



CERTIFIED SURVEY MAP

NO. 1879

Found 4" Diameter Cast Iron Monument

Found 6"x6" Concrete Monument
with Brass Cap

Set 1"x24" Iron Pipe
Weighing 1.13#/L.F.

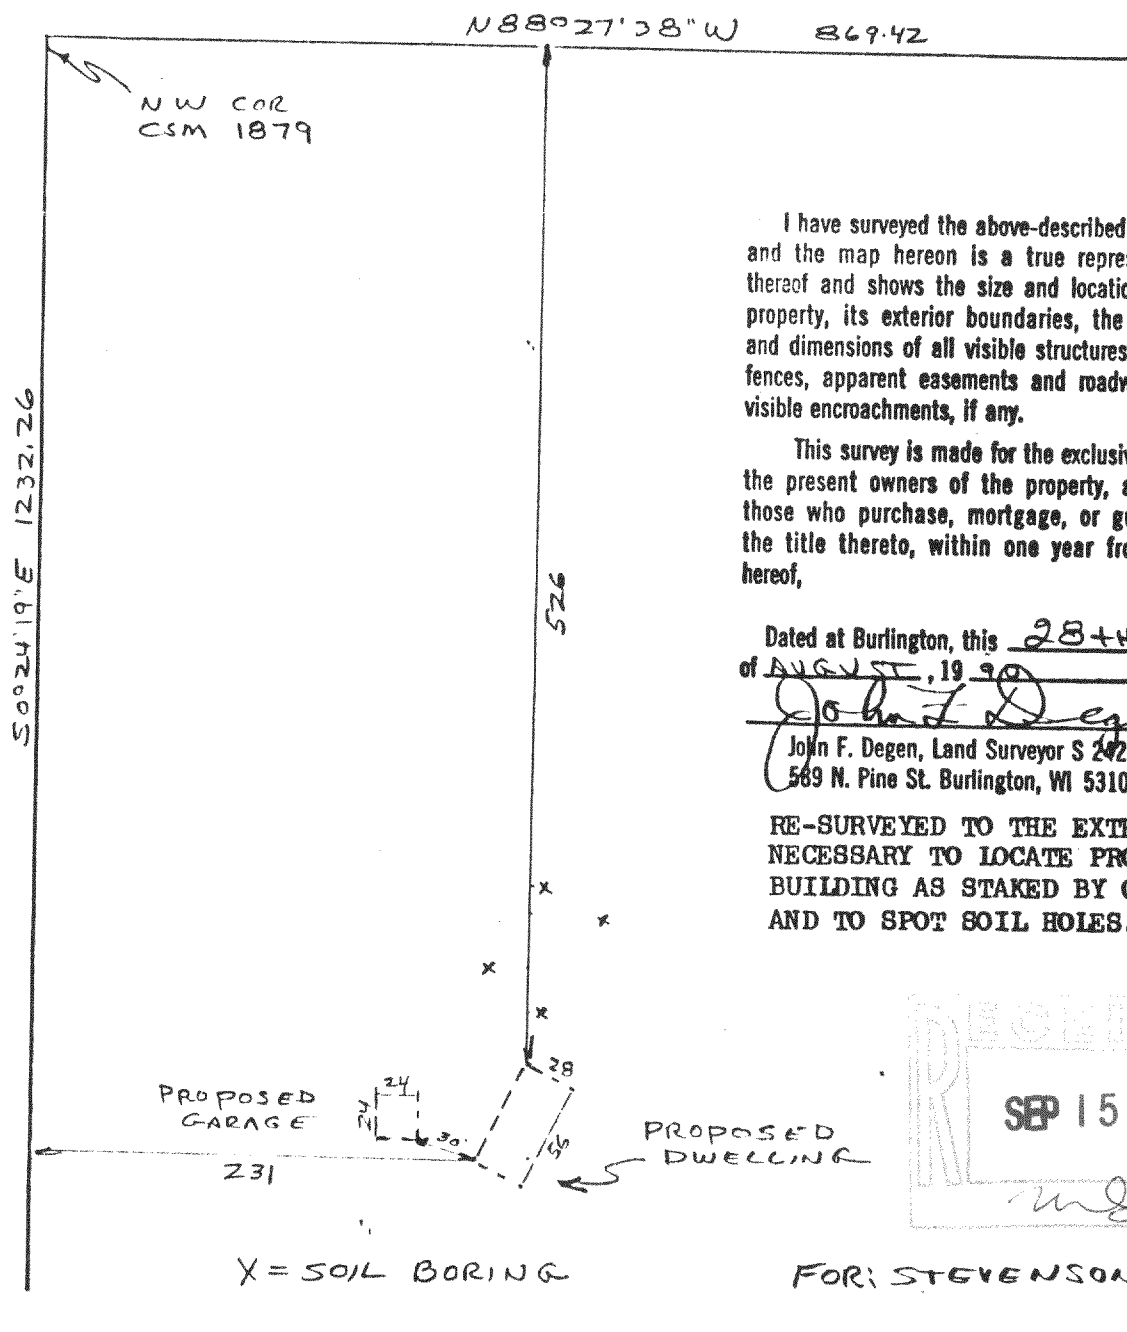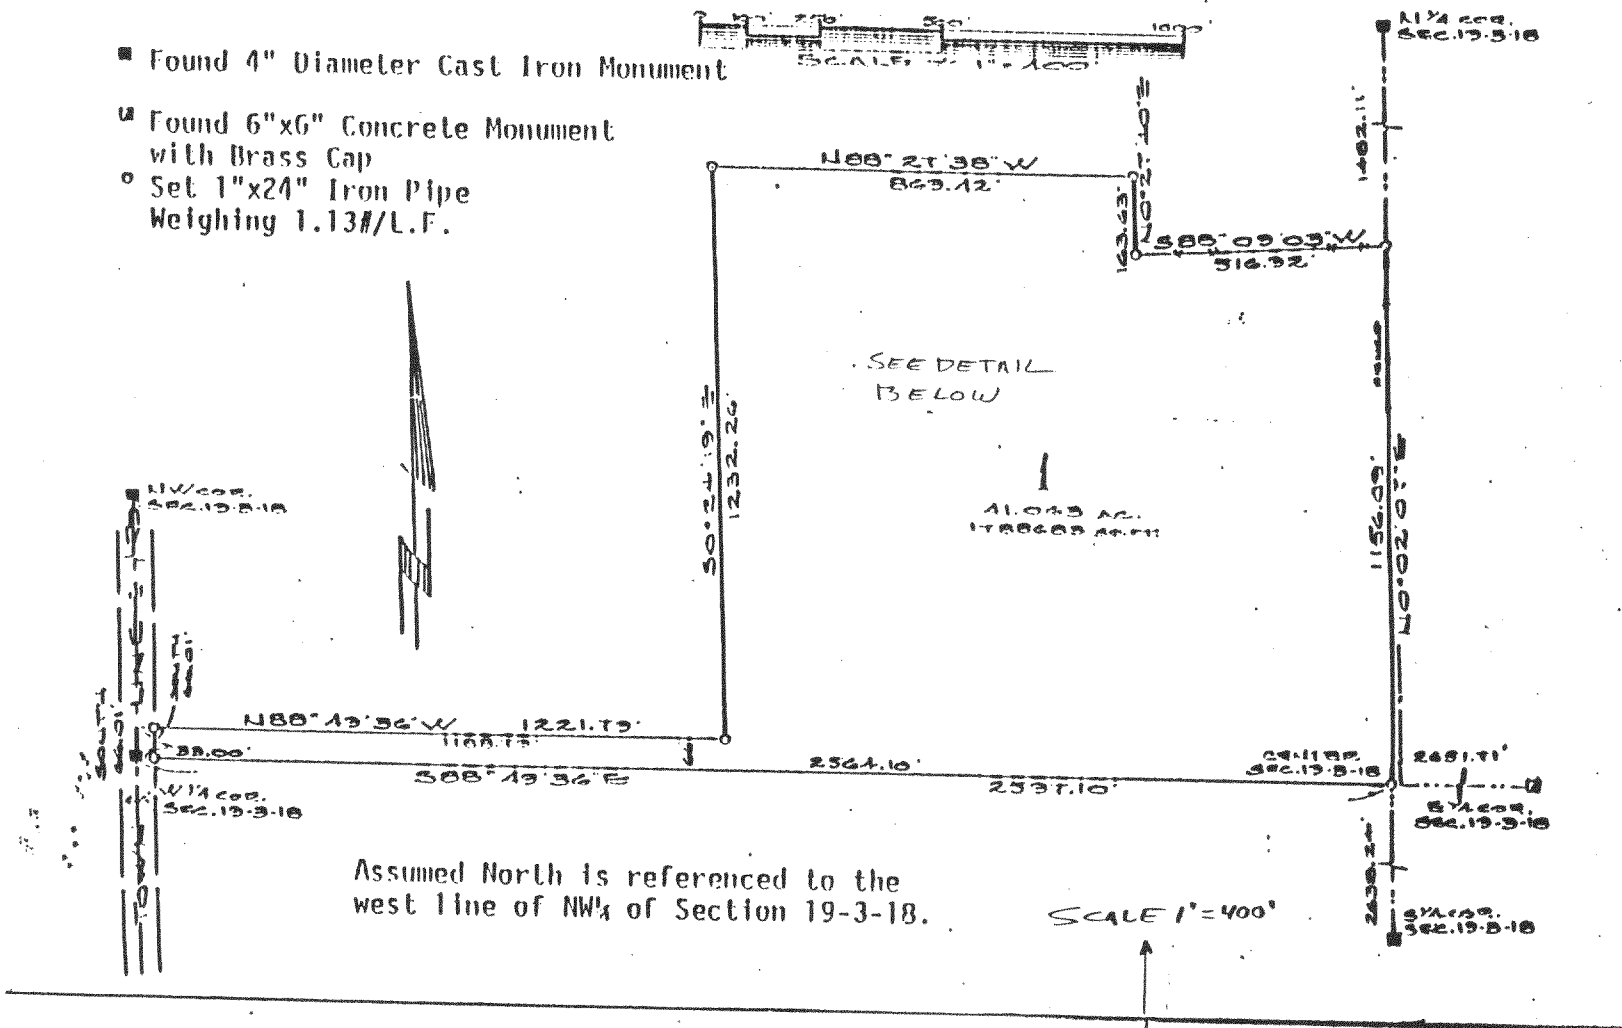

I have surveyed the above-described property,
and the map hereon is a true representation
thereof and shows the size and location of the
property, its exterior boundaries, the location
and dimensions of all visible structures thereon,
fences, apparent easements and roadways and
visible encroachments, if any.

This survey is made for the exclusive use of
the present owners of the property, and also
those who purchase, mortgage, or guarantee
the title thereto, within one year from date
hereof.

Dated at Burlington, this 28th day,
of AUGUST, 1990

John F. Degen
John F. Degen, Land Surveyor S 242
569 N. Pine St. Burlington, WI 53105

RE-SURVEYED TO THE EXTENT
NECESSARY TO LOCATE PROPOSED
BUILDING AS STAKED BY OTHERS
AND TO SPOT SOIL HOLES.

