

CERTIFIED SURVEY MAP NO. _____

PART OF THE NORTHEAST 1/4 OF THE NORTHEAST 1/4 OF SECTION 32, T. 3 N., R. 18 E. OF THE 4TH P.M., TOWNSHIP OF SPRING PRAIRIE, COUNTY OF WALWORTH, STATE OF WISCONSIN AND MORE PARTICULARLY DESCRIBED AS FOLLOWS: BEGIN AT A CONCRETE MONUMENT AT THE NORTHEAST CORNER OF SAID SECTION 32, RUN THENCE WEST ALONG THE NORTH LINE OF SECTION 32, 305.64 FEET TO THE PLACE OF BEGINNING OF PARCEL OF LAND HEREINAFTER DESCRIBED: THENCE CONTINUE WEST, 220.00 FEET ALONG THE NORTH LINE OF SECTION 32, THENCE SOUTH AT RIGHT ANGLES TO THE NORTH LINE OF SECTION 32, 218.57 FEET; THENCE EAST, PARALLEL WITH THE NORTH LINE OF SECTION 32, 220.00 FEET; THENCE NORTH, 218.57 FEET TO THE PLACE OF BEGINNING. SUBJECT TO RIGHTS OF PUBLIC OVER THE NORTH 33 FEET. CONTAINING 40,085 SQUARE FEET OF LAND. (CONTAINING 40,025 SQUARE FEET OF LAND EXCLUSIVE OF ROAD.)



I HEREBY CERTIFY THAT I HAVE SURVEYED THE LAND DESCRIBED ABOVE AND THAT PLAT DRAWN HEREON IS A CORRECT REPRESENTATION OF SAID SURVEY. I FURTHER CERTIFY THAT THE BUILDINGS ON SAID LAND ARE LOCATED AS SHOWN ON THIS PLAT. I ALSO CERTIFY THAT I HAVE COMPLIED WITH THE PROVISIONS OF CHAPTER 230.34 OF THE WISCONSIN STATUTES AND SECTION 6.0 OF THE WALWORTH COUNTY SUBDIVISION CONTROL ORDINANCE.

John F. Degen 5-26-72
JOHN F. DEGEN, LAND SURVEYOR
209 W. PINE ST., BURLINGTON, WISCONSIN.

APPROVED BY THE WALWORTH COUNTY PARK AND PLANNING COMMISSION THIS _____ DAY OF _____

0 GENGIES 1" x 2 1/2" IRON PIPE 1.68 LBS/FT.
SCALE 1" EQUALS 50'
BEARINGS ARE RELATIVE TO THE NORTH LINE OF SECTION 32-3-18 WHICH WAS ASSUMED AS WEST.

EUGENE HOLLISTER, CHAIRMAN

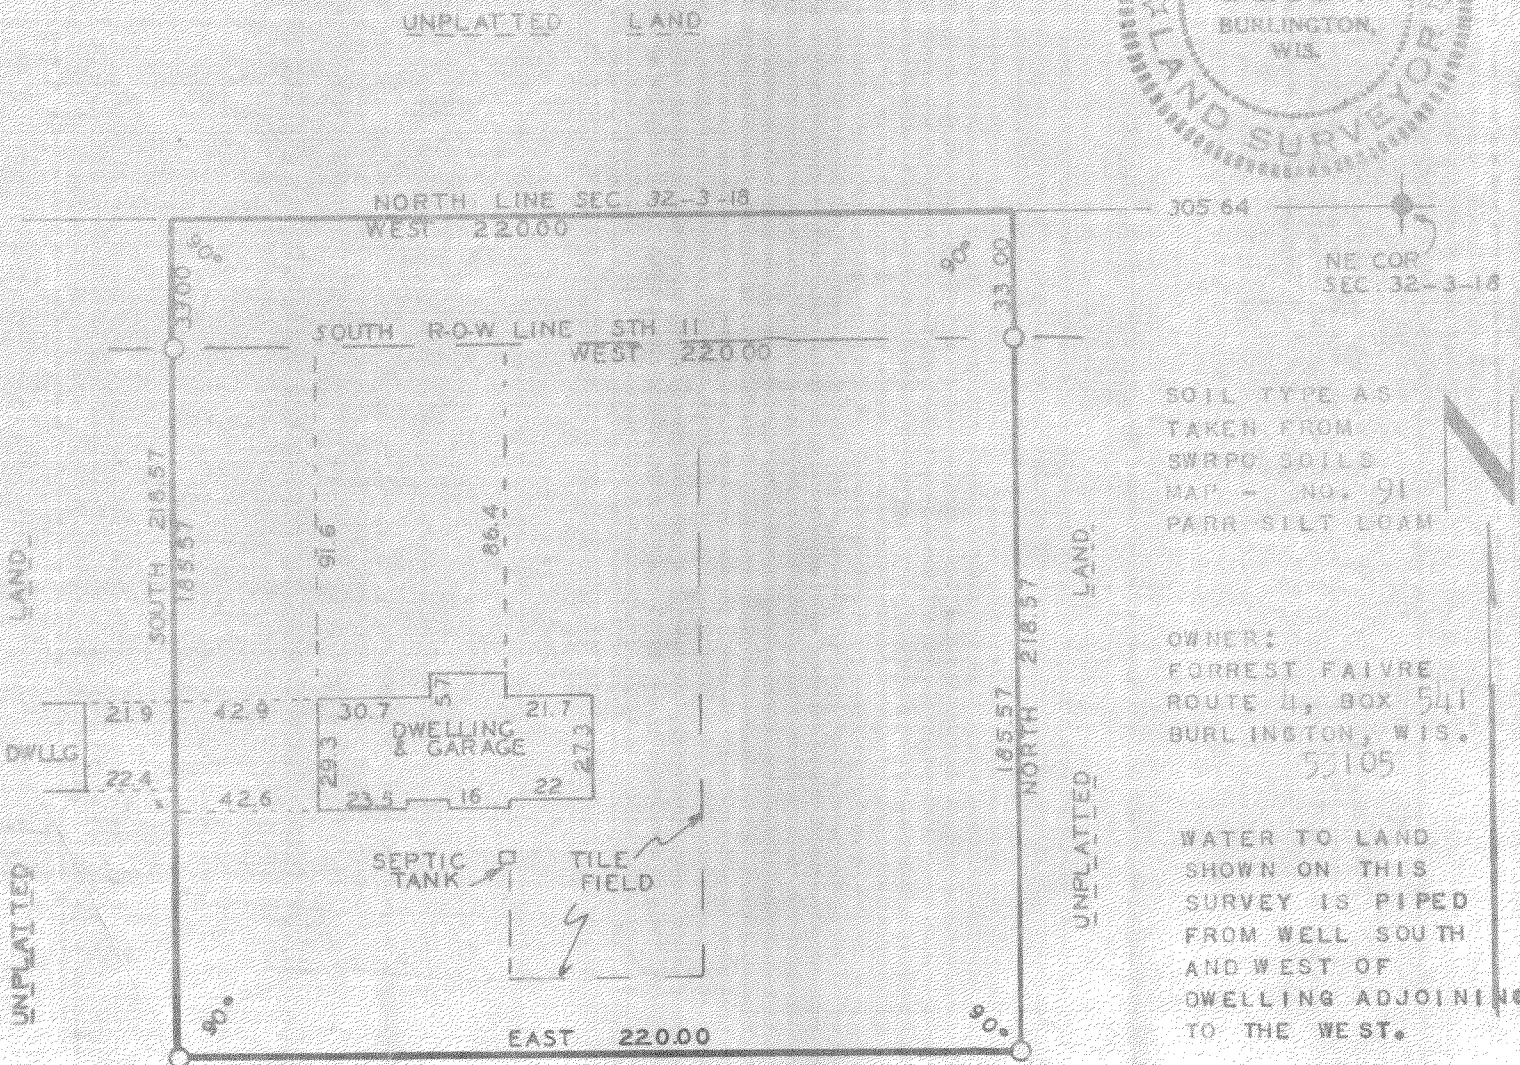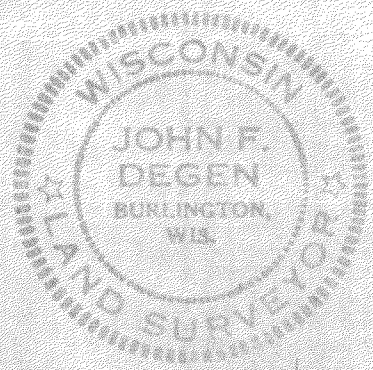

UNPLATTED LAND