
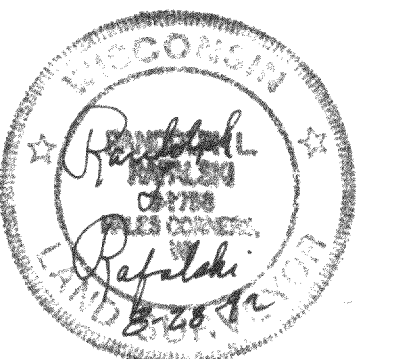
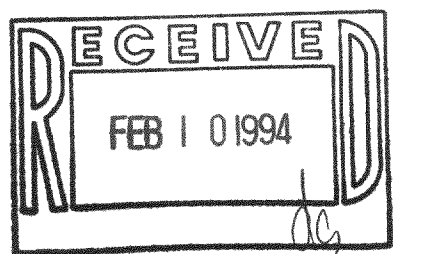


PLAT OF SURVEY
FOR: WOLTER BROS. BLDGS.
LOCATION: CLAUSEN RD.

PETERSON

N 90°00'00" E 1024.63

LEGAL DESCRIPTION:
LOT 1 CERTIFIED SURVEY MAP NO. 2160,
part of the N.W. 1/4 of the N.E. 1/4
and the N.E. 1/4 of the N.E. 1/4 and
the S.W. 1/4 of the N.E. 1/4 of Section
53, Town 5 North, Range 18 East, of
the 4TH P.M., Township of Spring
Prairie, Walworth County, Wisconsin.

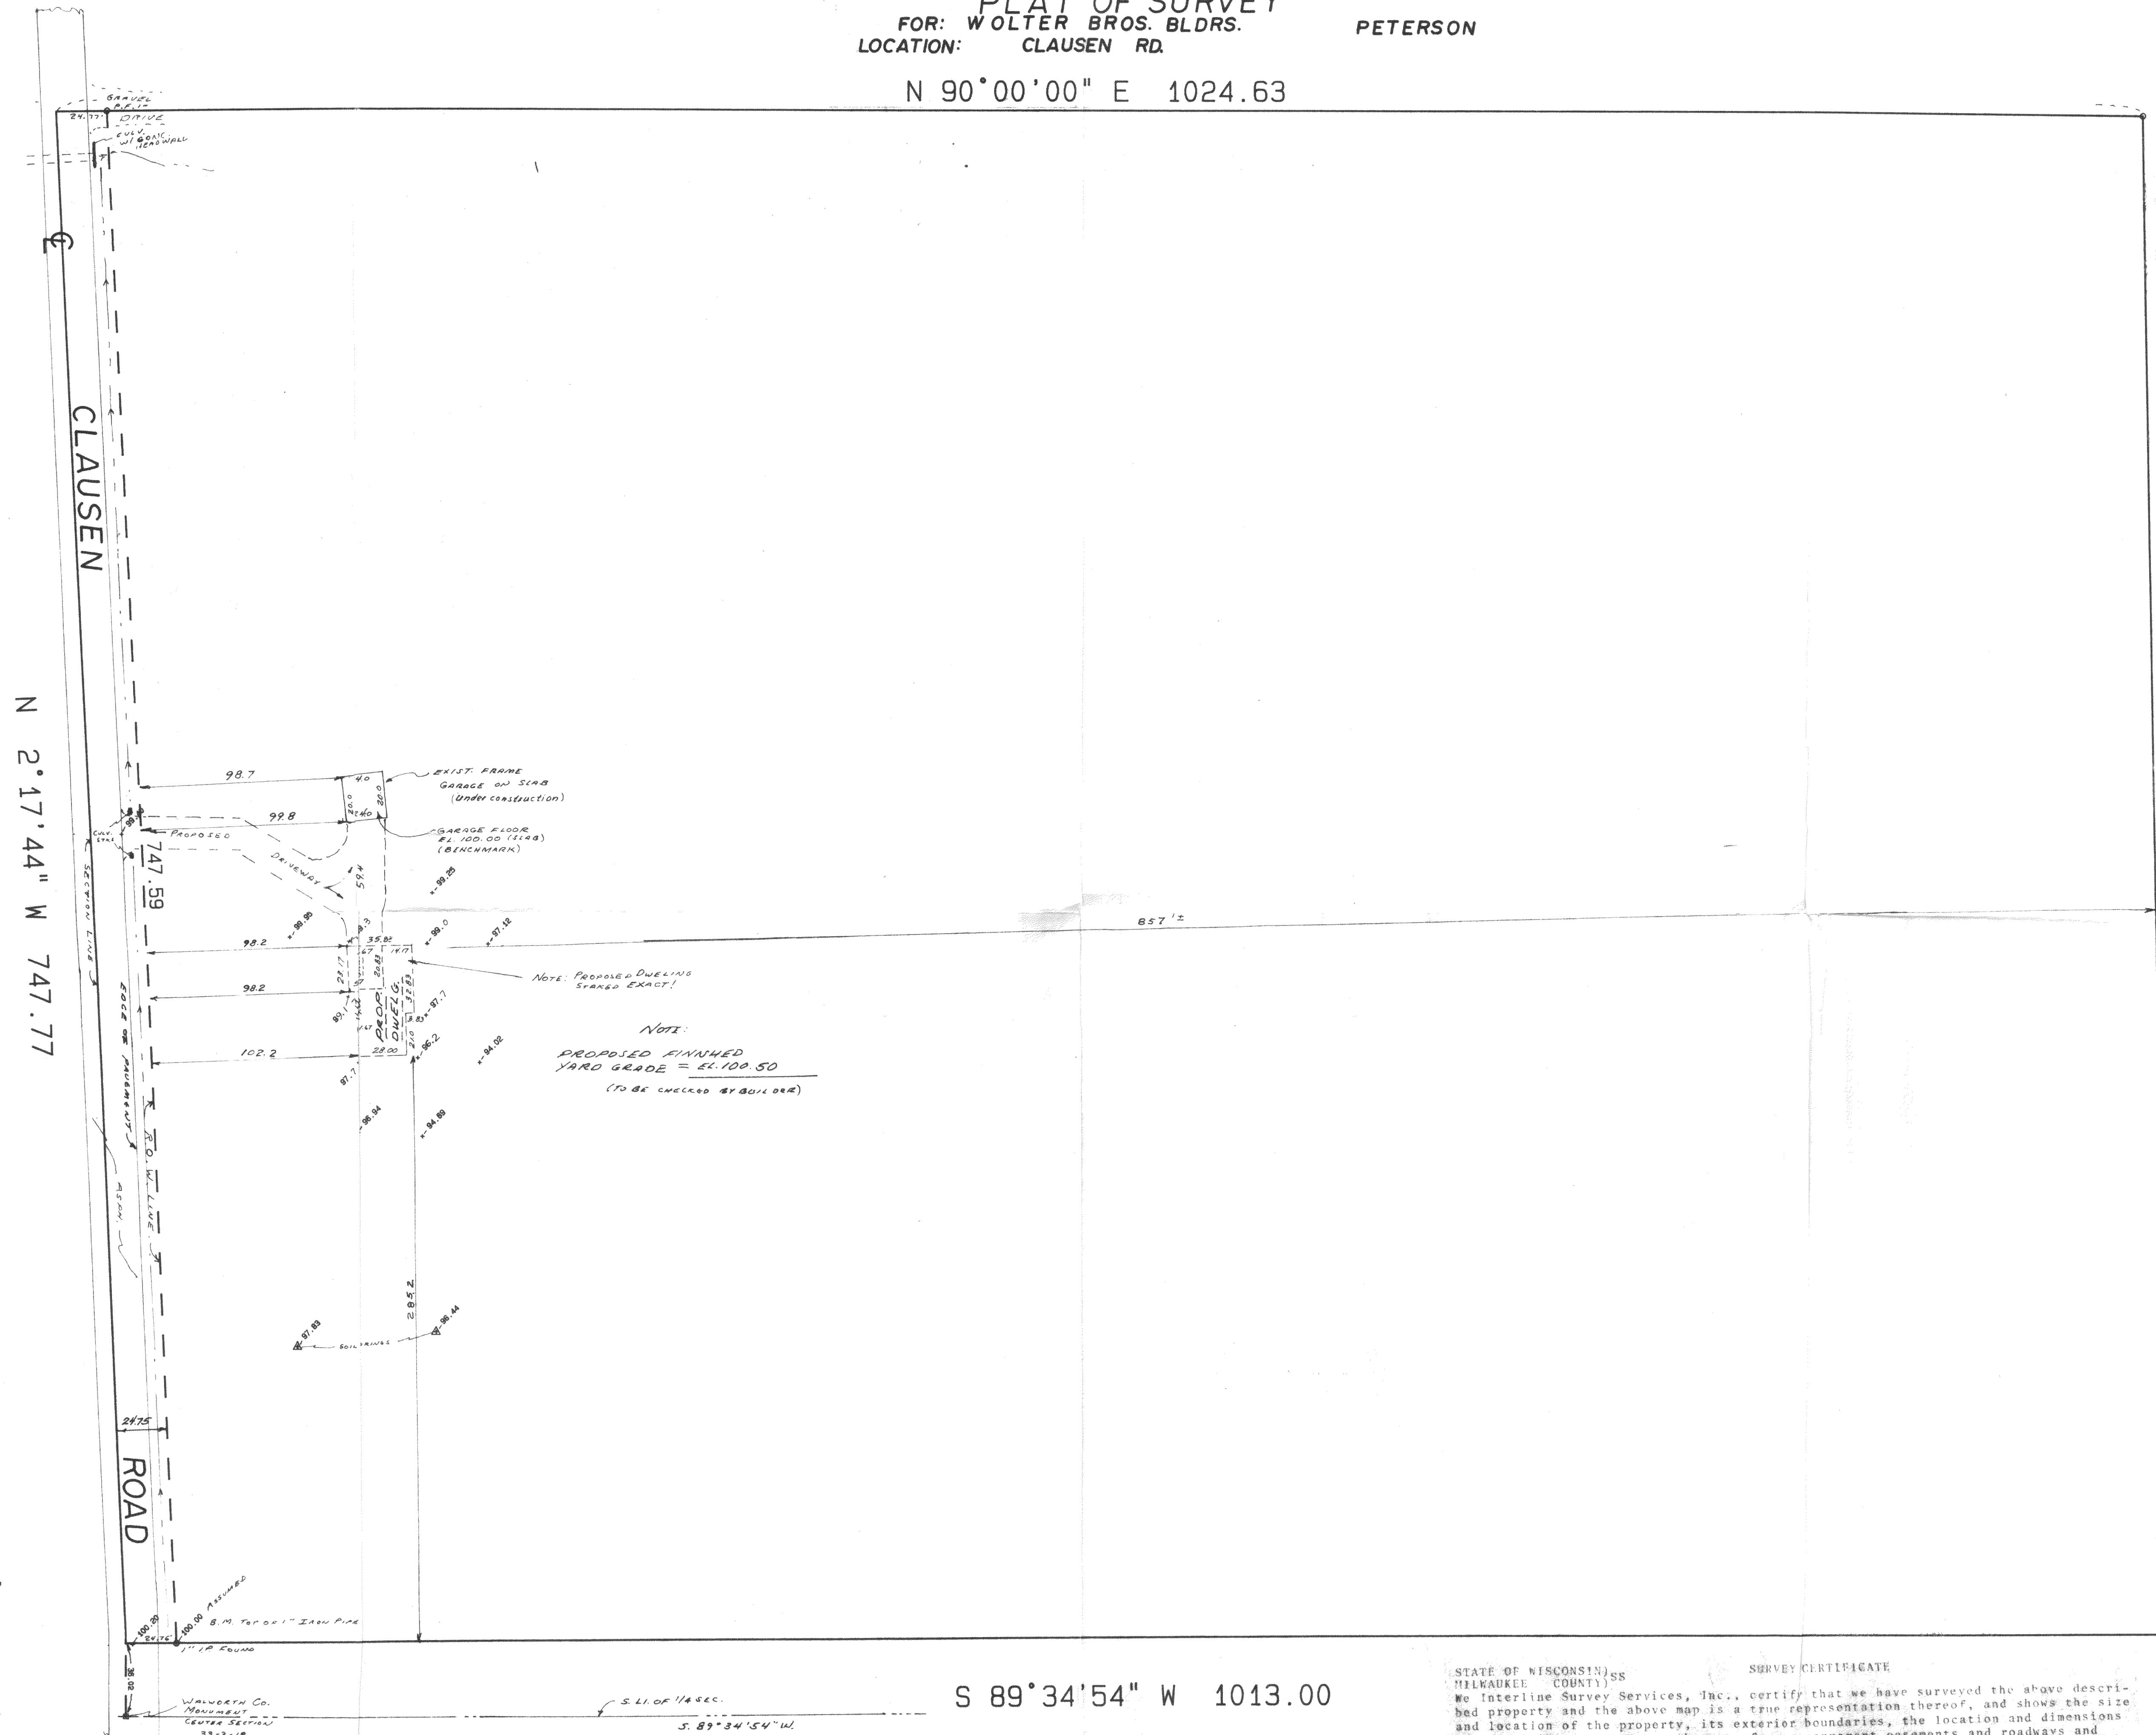

STATE OF WISCONSIN
MILWAUKEE COUNTY
We, Interline Survey Services, Inc., certify that we have surveyed the above described property and the above map is a true representation thereof, and shows the size and location of the property, its exterior boundaries, the location and dimensions of all visible structures thereon, fences, apparent easements and roadways and visible encroachments, if any.
This survey is made for the exclusive use of the present owners of the Property, and also those who purchase, mortgage, or guarantee the title thereto, within one (1) year from date hereof.

Randolph L. Repshel
Wisconsin Registered Land Surveyor

JOB #21244 SCALE 1"=40'
INTERLINE SURVEY SERVICES, INC.
11221 W. FOREST HOME AVE.
HALES CORNERS, WISCONSIN 53130
PHONE 425-2060

JOB NO. 21392
DATED: 8-28-92

RE-CERTIFICATION
PLAT OF SURVEY
FOR: WOLTER BROS. BLDGS.
LOCATION: CLAUSEN RD.

PETERSON

N 90°00'00" E 1024.63


LEGAL DESCRIPTION:
LOT 1 CERTIFIED SURVEY MAP NO. 2169,
Part of the N.E. 1/4 of the N.E. 1/4
and the N.E. 1/4 of the N.E. 1/4 and
the S.W. 1/4 of the N.E. 1/4 of Section
33, Town 3 North, Range 18 East, of
the 4TH P.M., Township of Spring
Prairie, Walworth County, Wisconsin.

S 1°25'00" E 740.00

N 2°17'44" W 747.77

CLAUSEN

ROAD

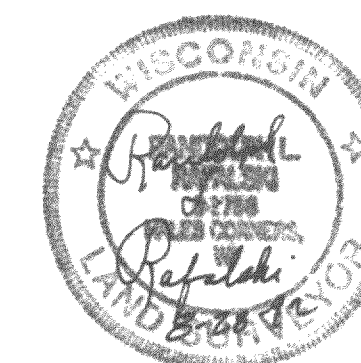

JOB #21244

Scale 1" = 40'

INTERLINE SURVEY
SERVICES, INC.
11221 W. FOREST HOME AVE.
HALES CORNERS, WISCONSIN 53130
PHONE 425-2060

JOB NO. 21528
DATED: 12-2-92

318-449


STATE OF WISCONSIN
MILWAUKEE COUNTY
We, Interline Survey Services, Inc., certify that we have surveyed the above described property and the above map is a true representation thereof, and shows the size and location of the property, its exterior boundaries, the location and dimensions of all visible structures thereon, fences, apparent easements and roadways and visible encroachments, if any.
This survey is made for the exclusive use of the present owners of the Property, and also those who purchase, mortgage, or guarantee the title thereto, within one (1) year from date hereof.

Randolph L. Repshke
Wisconsin Registered Land Surveyor


S 89°34'54" W 1013.00

S. 89°34'54" W

Walworth Co.
Monument
Center Station
33-3-18

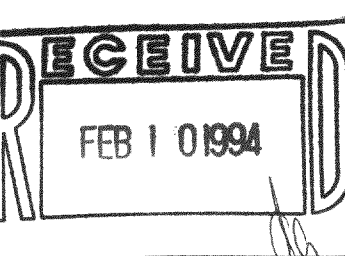

SCALE 1"=40'

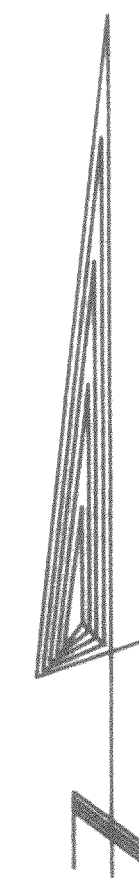

CA-2160-1