



AMERICAN SURVEYING COMPANY, INC.

LAND SURVEYORS

11931 Hwy. "K"

FRANKSVILLE, WISCONSIN



TEL. NO. (414) 835-4774

PLAT OF SURVEY

PREPARED FOR:
DESCRIPTION:

BADGER HOME BUILDERS
PARCEL NO. 2, CERTIFIED SURVEY MAP NO. 2388, BEING PART OF THE NORTHEAST 1/4 OF SECTION 15,
AND THE NORTHWEST 1/4 OF THE NORTHWEST 1/4 OF SECTION 14, TOWN 3 NORTH, RANGE 18 EAST, IN
THE TOWN OF SPRING PRAIRIE, COUNTY OF WALWORTH, STATE OF WISCONSIN.

OWNER: SCHMID

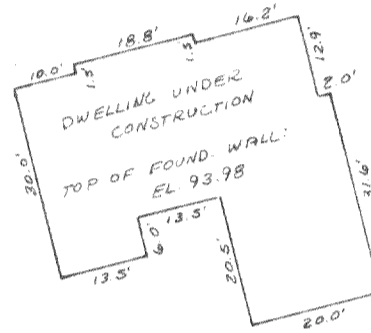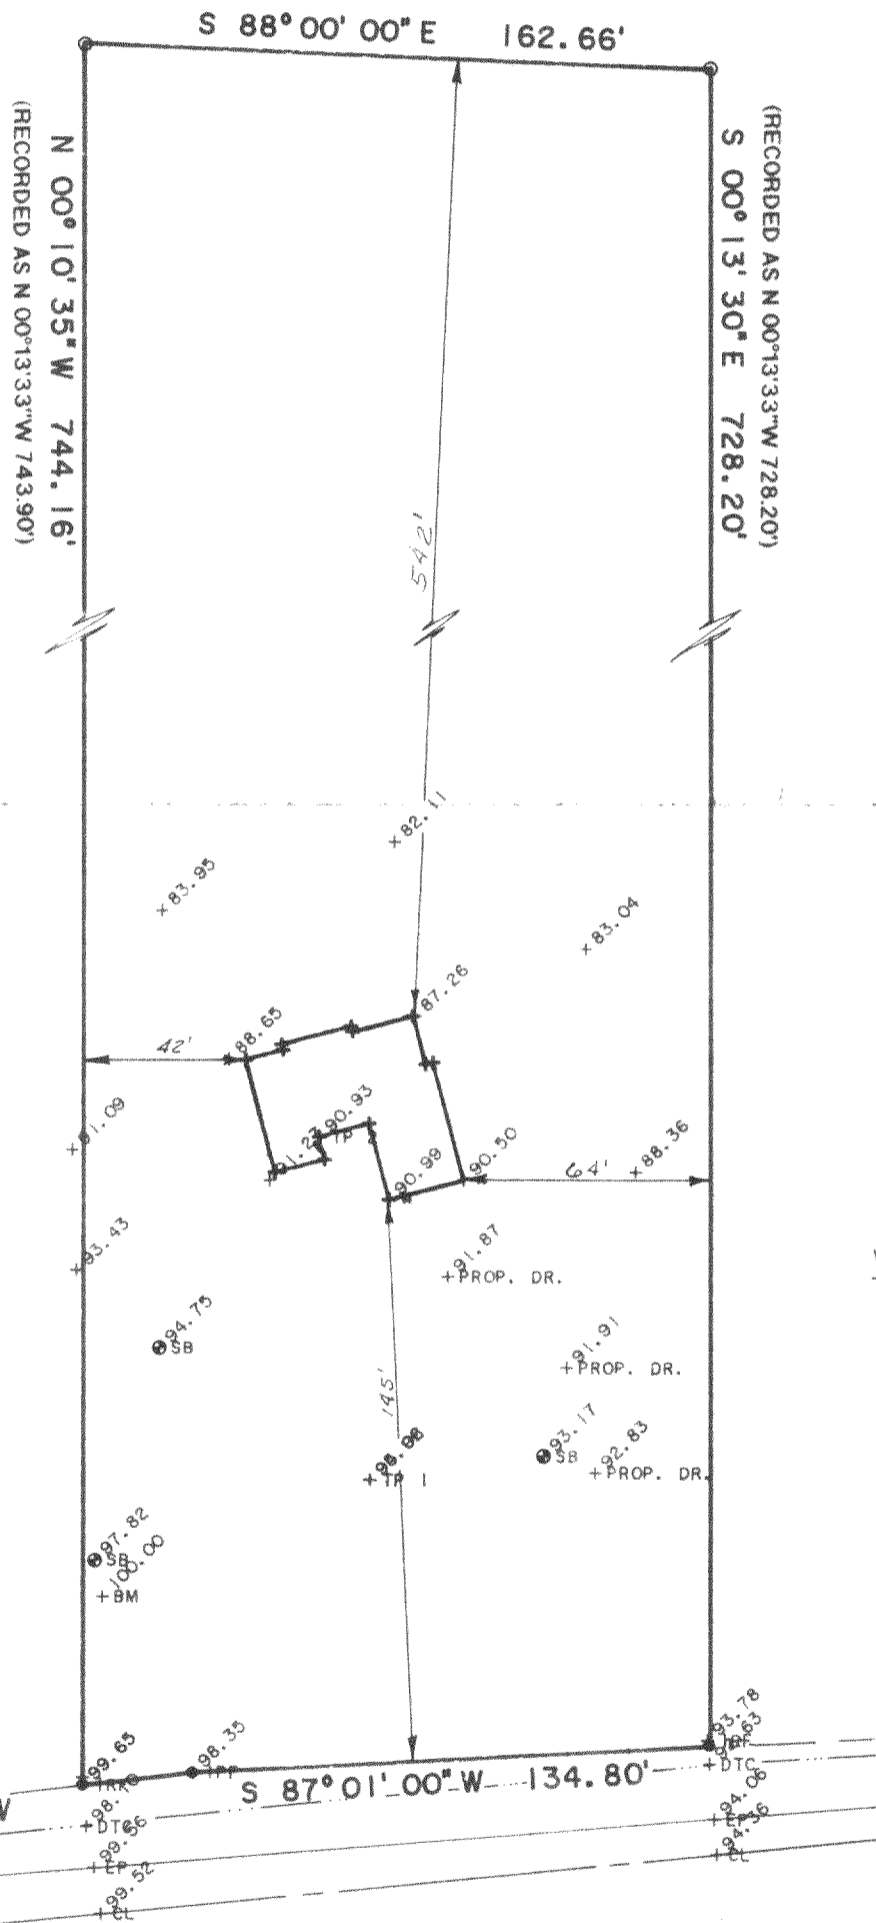

HOUSE DETAIL
SCALE: 1" = 30'




SCALE: 1" = 50'

VACANT

VACANT



(SEE BENCH MARK EL. 100.00)

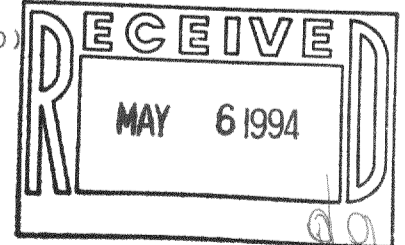

STATE OF WISCONSIN
COUNTY OF RACINE **PARADISE DRIVE**

I hereby certify that I have surveyed the above described property and the above map is a true representation thereof and shows the size and location of the property, its exterior boundaries, the location of all visible structures and dimensions of all principle buildings thereon, boundary fences, apparent easements, roadways and visible encroachments, if any.

This survey is made for the present owners of the property, and also those who purchase, mortgage, or guarantee the title thereto within one (1) year from the date thereof.

Dated at NORTH CAPE this 27th day of JANUARY, 19 94 Recertified APRIL 27, 1994

Pete L. Bailey
Registered Land Surveyor

JOB NO. 94.004

BADGER BLUEPRINT CO. 546551

DA-2388-2

318-461