
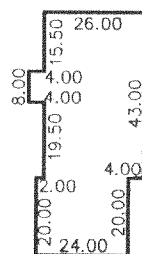
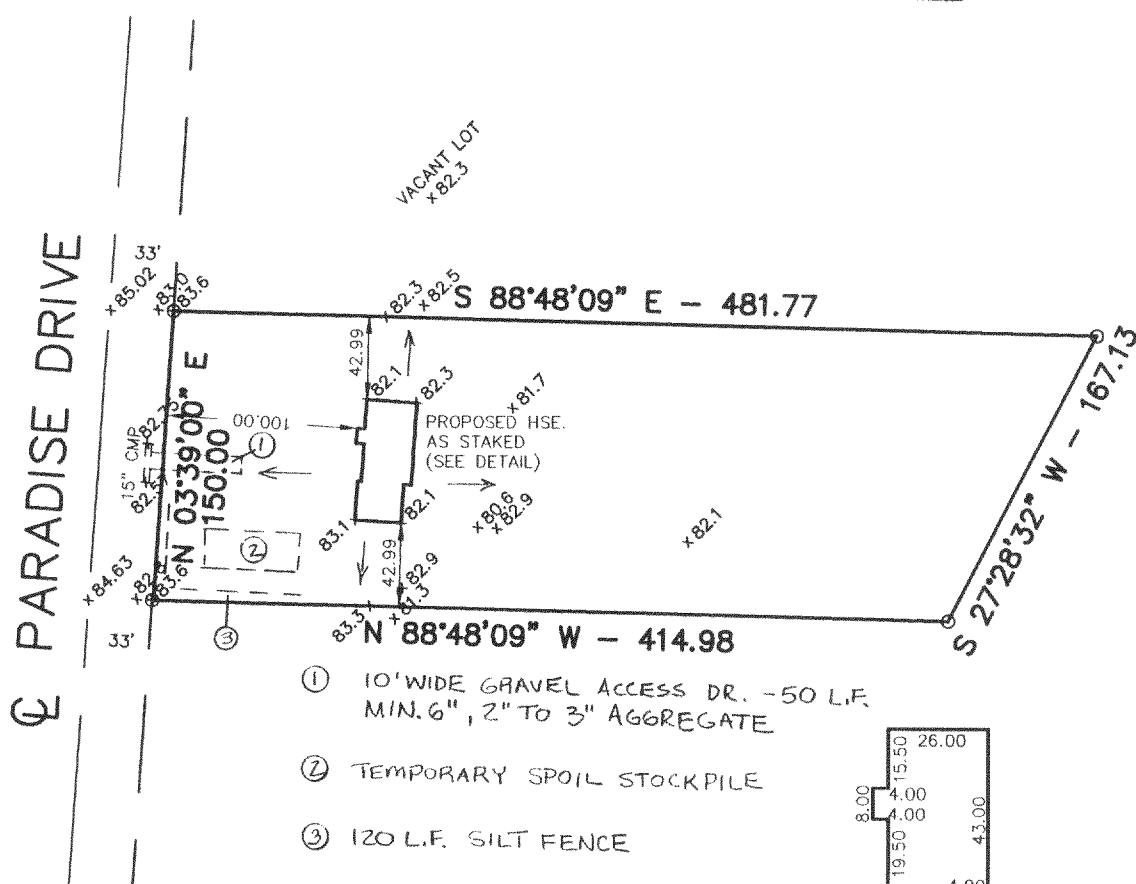


Plat of a survey for **CHARLES DYKSTRA** of Parcel 2, Certified Survey Map No. 2327, a division of part of the SE $\frac{1}{4}$ of the NE $\frac{1}{4}$ of Section 15-3-18 in the Town of Spring Prairie, Walworth County, Wisconsin, and recorded in Volume 11 at pages 203 and 204 as Document No. 263787.

Tops of Stakes	Elevations
5' E of NE corner	82.97
5' W of NW corner	82.96
Proposed Finished Grade	84.6

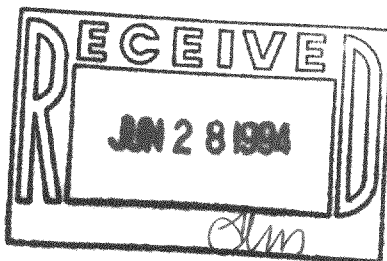

HOUSE DETAIL
1"=50'

BEARING BASE: GRID NORTH, WISCONSIN COORDINATE SYSTEM

ALL ELEVATIONS REFER TO ASSUMED DATUM PP# 70-29904 = 93.81
LEGEND (4TH POLE NORTH OF LOT 3)

- = SET
- = IRON STAKE FOUND
- ← = DRAINAGE

FIELD WORK 5-26-94 BY JRN, BSH

DRAWN 5-27-94 BY SCB

SCALE 1" = 100'

JOB NO. 94.160

CERTIFICATE

The above-described property has been surveyed under my direction and the above map is a correct representation thereof.

James E. Robinson

May 31, 1994

NM
&B

Nielsen Madsen & Barber, S.C.

1339 Washington Avenue Racine, Wisconsin 53403
Phone (414) 634-5588 / 552-7902
Facsimile (414) 634-5024

04-2327-2

318-469