


FARRIS, HANSEN & ASSOCIATES, INC.
ENGINEERING, ARCHITECTURE, SURVEYING
7 RIDGWAY COURT - P.O. BOX 437, ELKHORN, WISCONSIN 53121
PHONE: (414) 723-2098 FAX: (414) 723-5886

PLAT OF SURVEY

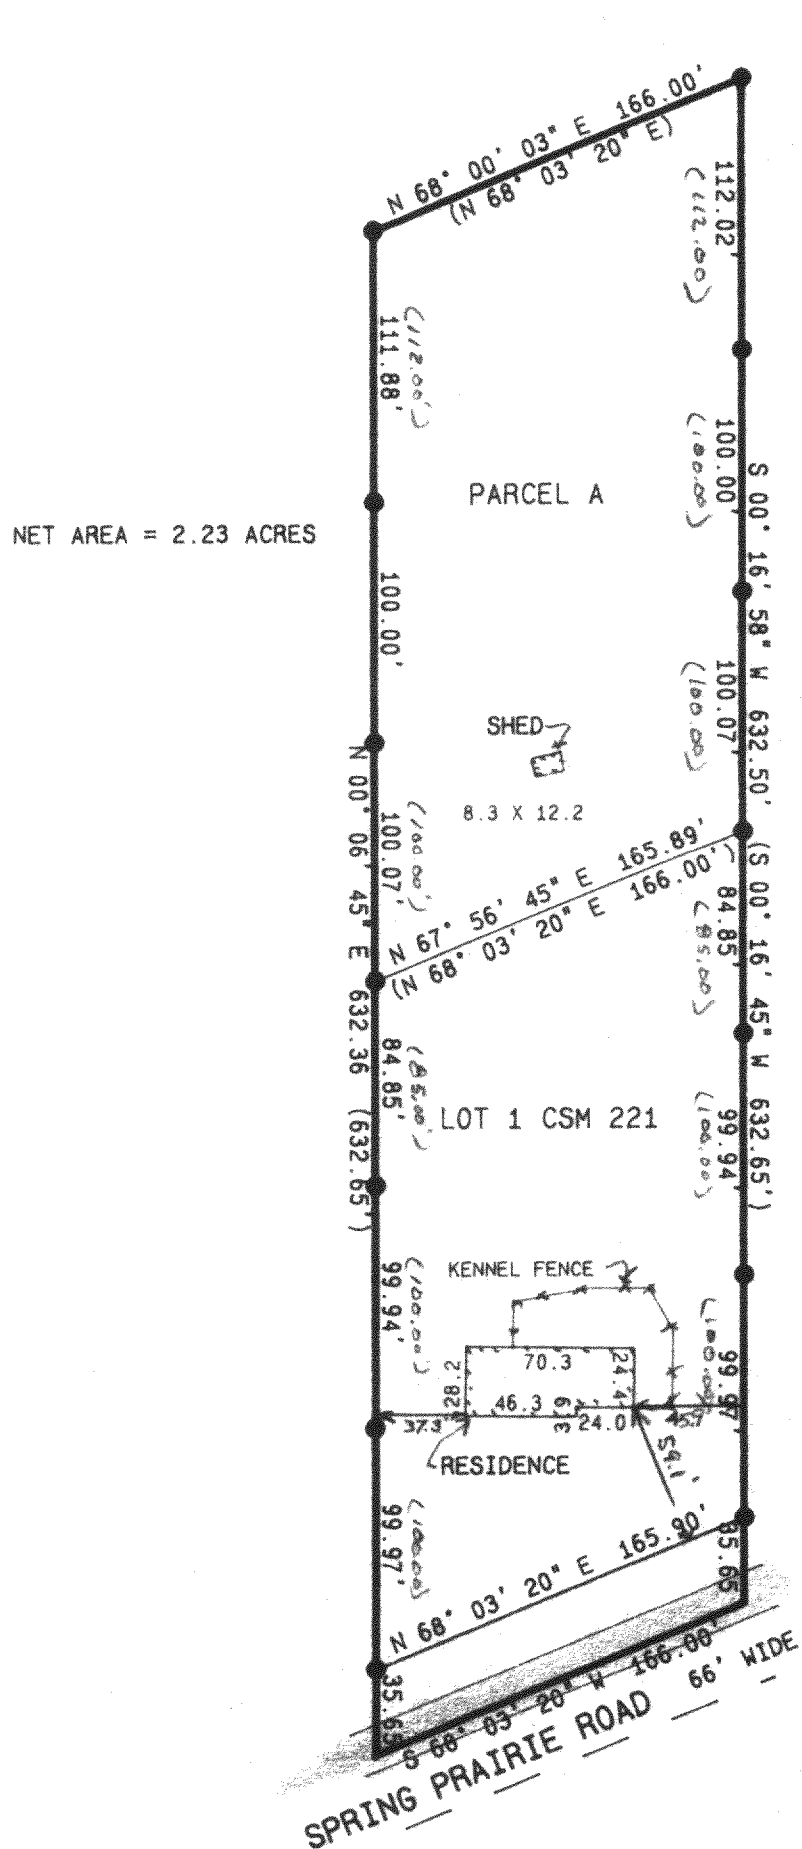

LOCATED IN THE NE 1/4 OF SECTION 29, TOWN 3 NORTH, RANGE 18 EAST, TOWN OF SPRING PRAIRIE, WALWORTH COUNTY, WISCONSIN DESCRIBED AS: LOT 1 OF CERTIFIED SURVEY MAP NO. 221, RECORDED IN VOLUME NO. 1 ON PAGE NO. 221 AS DOCUMENT NO. 662523 OF WALWORTH COUNTY CERTIFIED SURVEY MAPS.


AND PARCEL A: BEGINNING AT THE NORTHWEST CORNER OF LOT 1 OF CERTIFIED SURVEY MAP NO. 221, THENCE N 00DEG 16MIN 45SEC E, 312.00 FEET; THENCE N 68DEG 03MIN 20SEC E, 166.00 FEET; THENCE S 00DEG 16MIN 45SEC W, 312.00 FEET TO THE NORTHEAST CORNER OF SAID LOT 1; THENCE S 68DEG 03MIN 20SEC W, 166.00 FEET TO THE POINT OF BEGINNING.

WORK ORDERED BY: DONALD HUNT
W. 1778 SPRING PRAIRIE ROAD
BURLINGTON, WISCONSIN 53105

LEGEND

● = FOUND IRON PIPE STAKE
(xxx) = RECORDED AS

ASSIGNED WEST LINE LOT 1 CSM 221
N 00° 16' 45" E
PER RECORD PLAT

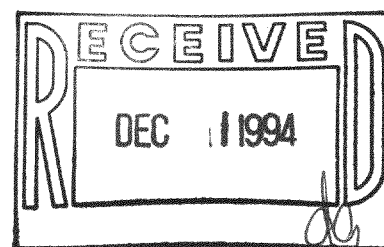


MAP SCALE IN FEET
ORIGINAL 1" = 80'

NOTE: COPIES OF THIS MAP TO WHICH THE FOLLOWING CERTIFICATE WILL APPLY ARE BLUE LINE PRINTS SHOWING SURVEYOR'S ORIGINAL SEAL AND SIGNATURE IN BLACK INK. COPIES BY ANY OTHER MEANS MAY HAVE ALTERATIONS WHICH DO NOT REPRESENT THE SURVEYOR'S WORK PRODUCT.

I HEREBY CERTIFY THAT THE ABOVE DESCRIBED PROPERTY HAS BEEN SURVEYED UNDER MY DIRECTION AND THAT THE ABOVE MAP IS A TRUE REPRESENTATION THEREOF AND SHOWS THE SIZE AND LOCATION OF THE PROPERTY AND ITS EXTERIOR BOUNDARIES. THIS SURVEY IS MADE FOR THE USE OF THE PRESENT OWNERS OF THE PROPERTY, AND ALSO THOSE WHO PURCHASE, MORTGAGE, OR GUARANTEE THE TITLE THERETO WITHIN ONE YEAR FROM THE DATE HEREOF.

DATED: 11-23-94

Peter S. Gordon

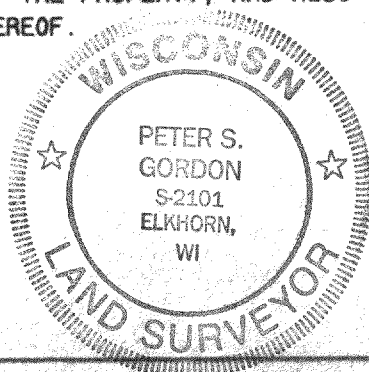

PROJ 4223

OA-221-1

318-498