


Plat of Survey



Survey For: WOLTER BROS. BUILDERS
Location: Potter Road

LOVRINE

Description: LOT 1 CERTIFIED SURVEY MAP NO. 2516, being a redivision of LOT 1 of CERTIFIED SURVEY MAP NO. 1958, located in the Southwest 1/4 of the Southwest 1/4 and in the Northwest 1/4 of the Southwest 1/4 of Section 13, Town 3 North, Range 18 East, of the 4th P.M., Township of Spring Prairie, County of Walworth, State of Wisconsin.

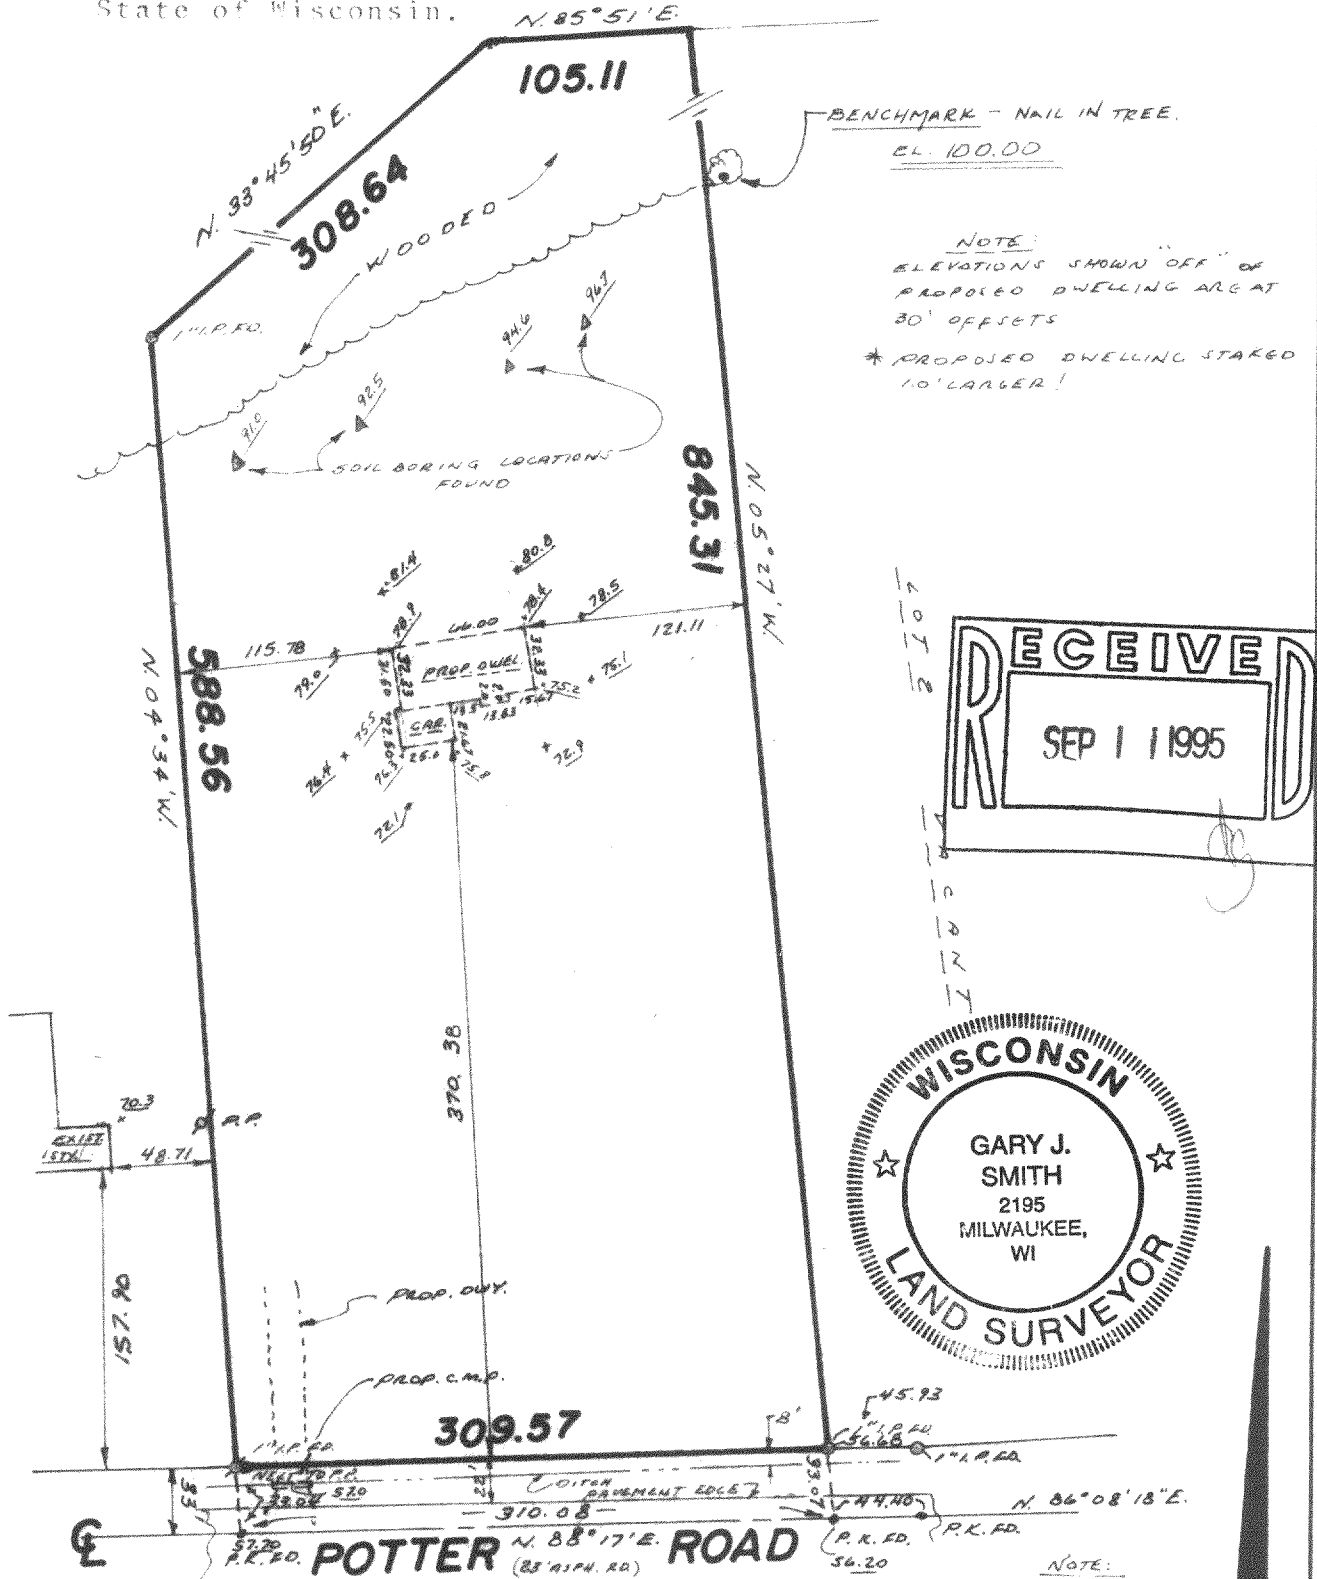

NOTE:
ELEVATIONS SHOWN "OFF" OF
PROPOSED DWELLING ARE AT
30' OFFSETS
* PROPOSED DWELLING STAKED
10' LARGER!

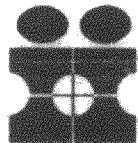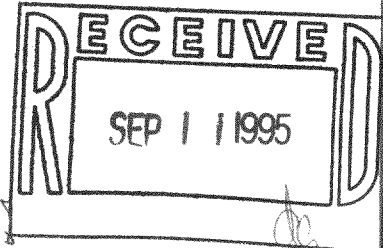

INTERLINE SURVEY SERVICES, INC.
11221 W. FOREST HOME AVE
HALES CORNERS, WISCONSIN 53130
PHONE 425-2060

SURVEY CERTIFICATE

NOTE:
SUGGESTED FINISHED
YARD GRADE =
EL. 79.00

Scale: 1" = 100'

State of Wisconsin) ss
Milwaukee County

We, Interline Survey Services, Inc., certify that we have surveyed the above described property and the above map is a true representation thereof, and shows the size and location of the property, its exterior boundaries, the location and dimensions of all visible structures thereon, fences, apparent easements and roadways and visible encroachments, if any.

This survey is made for the exclusive use of the present owners of the Property, and also those who purchase, mortgage, or guarantee the title thereto, within one (1) year from date hereof.

Gary J. Smith 5-2195
Wisconsin Registered Land Surveyor

Date: 5/22/95
Job No.: 23802

0A-2516-1

318-522