


PLAT OF SURVEY
OF
LOT 4, OF WALWORTH COUNTY CERTIFIED SURVEY MAP NO. 2398, LOCATED IN THE SOUTHEAST 1/4 OF SECTION 24, T. 3 N.,
R. 18 E. OF THE 4TH P.M., TOWNSHIP OF SPRING PRAIRIE, COUNTY OF WALWORTH, STATE OF WISCONSIN.

FOR: HARTHUN

SCALE 1" = 100'

♂ = IRON PIPE FOUND.

BEARINGS RELATE TO RECORDED CSM.

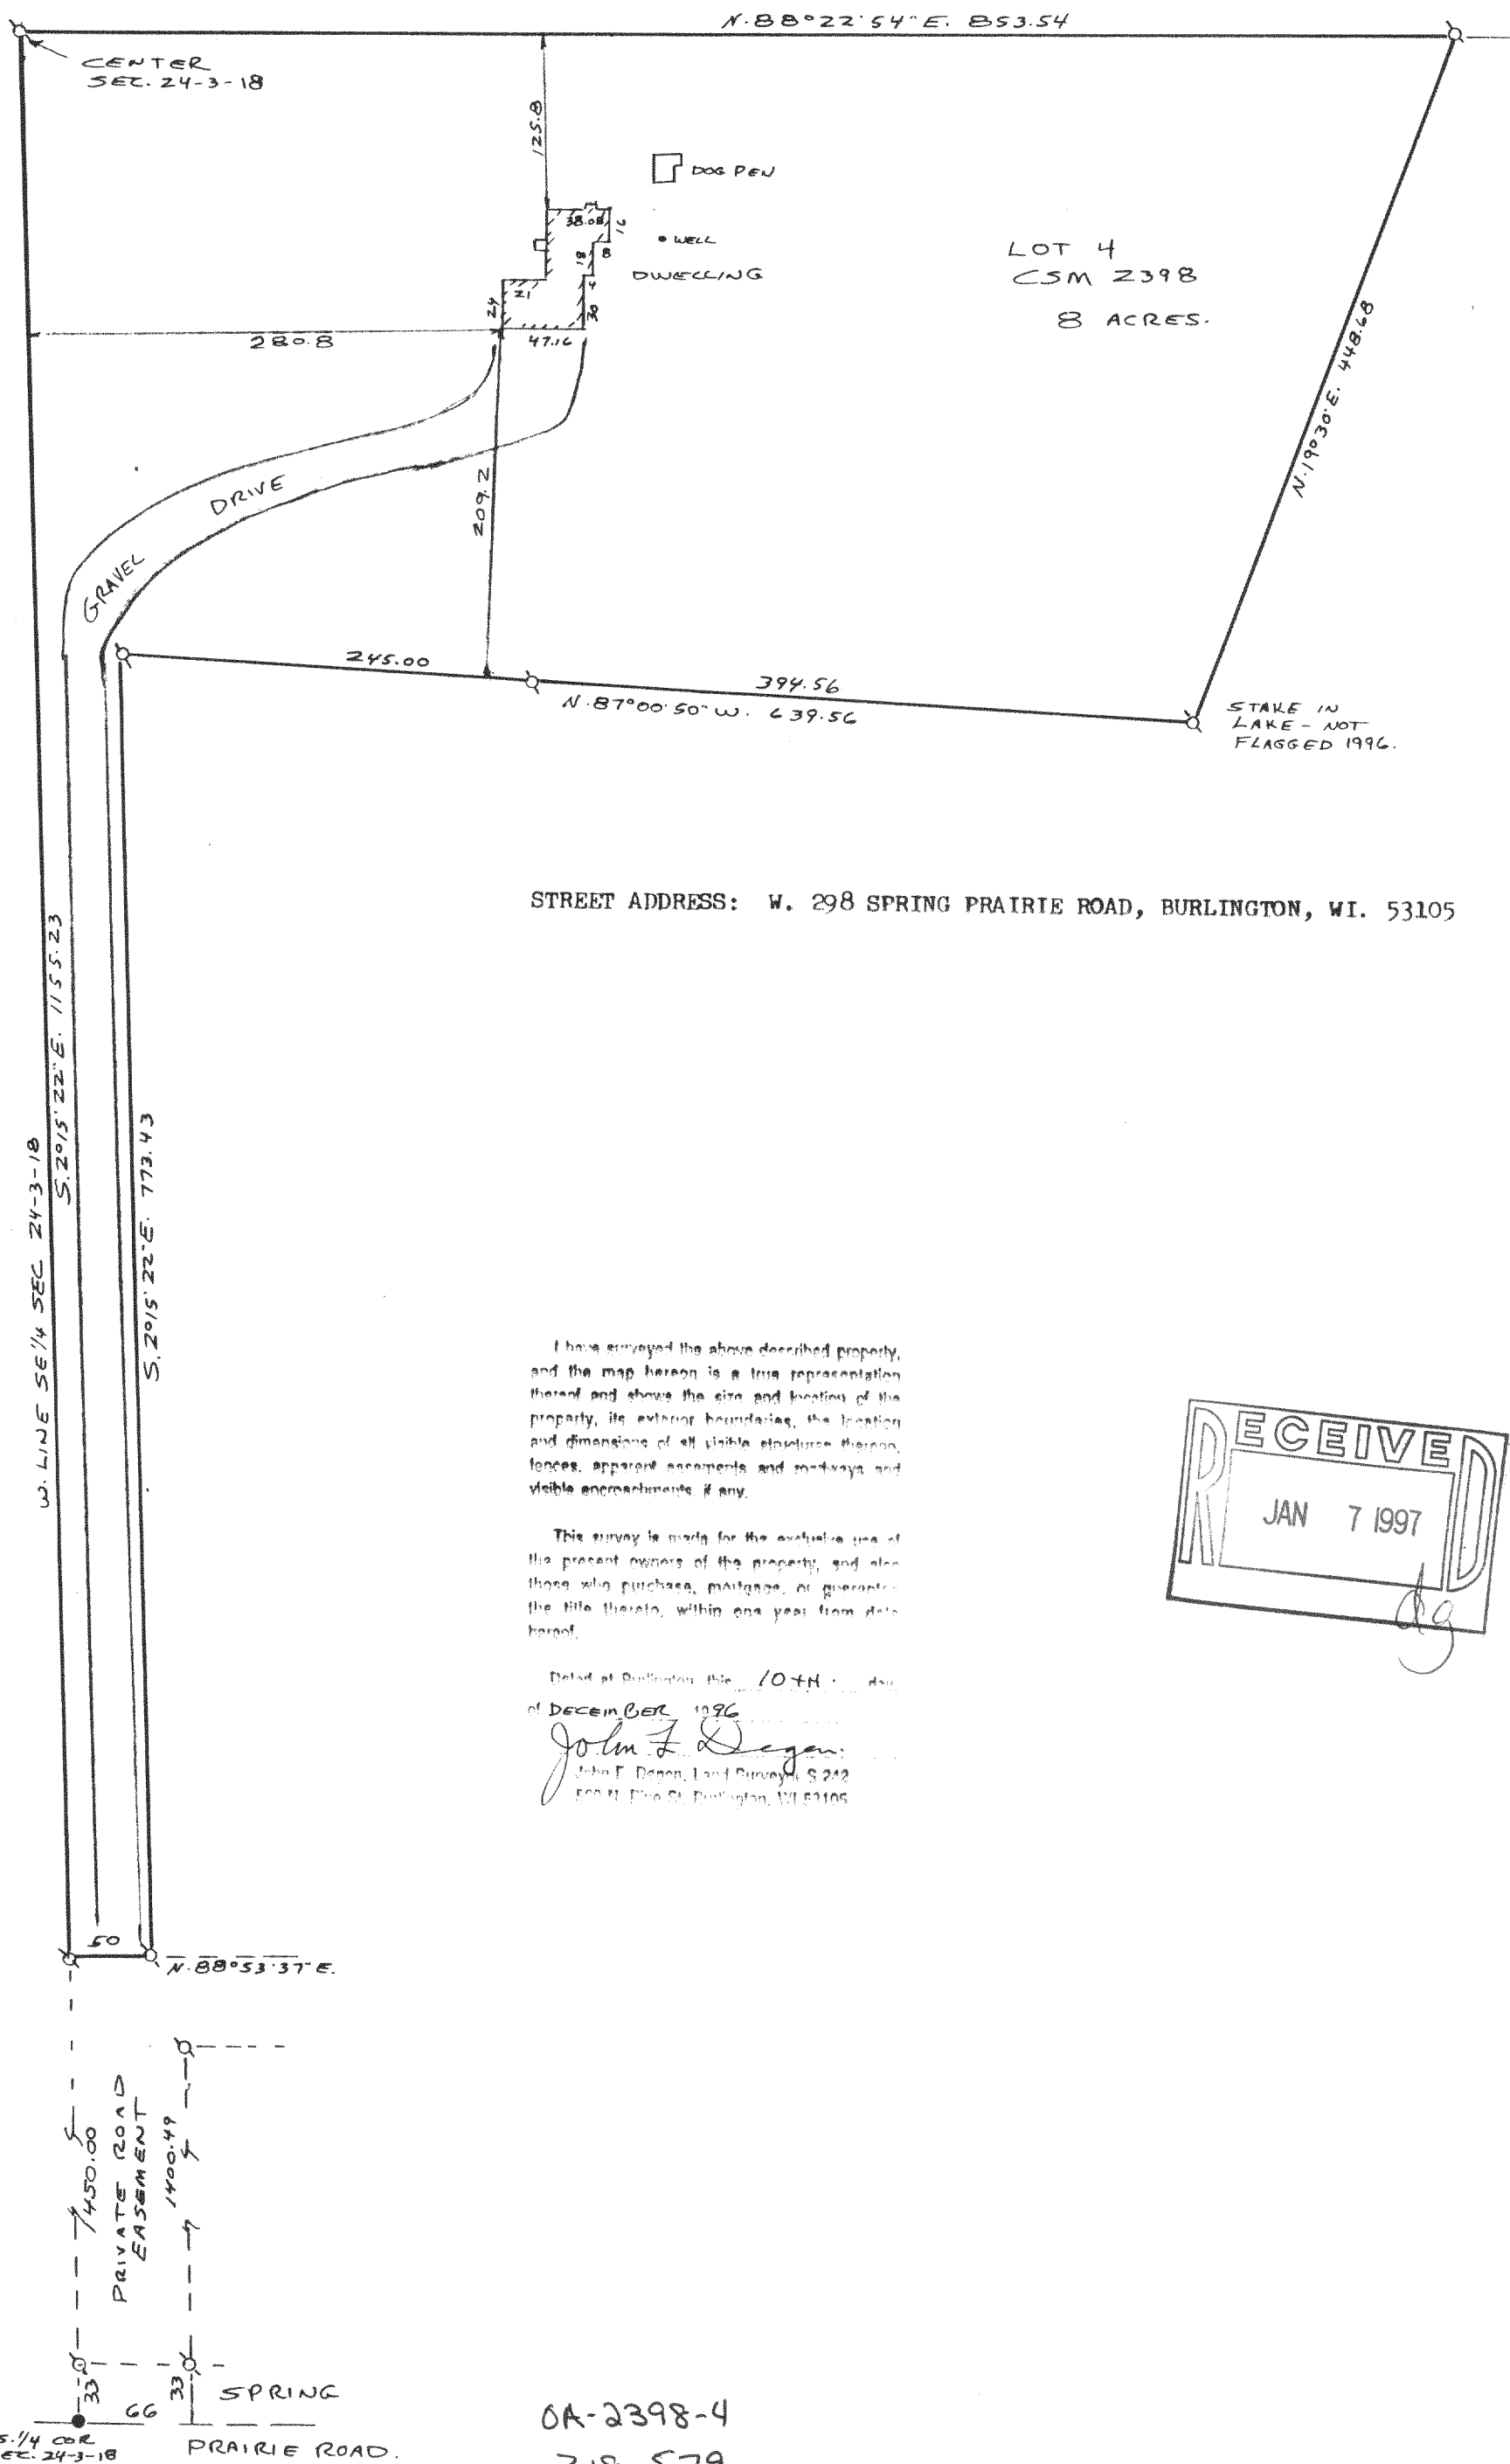


STREET ADDRESS: W. 298 SPRING PRAIRIE ROAD, BURLINGTON, WI. 53105

I have surveyed the above described property, and the map hereon is a true representation thereof and shows the size and location of the property, its exterior boundaries, the location and dimensions of all visible structures thereon, fences, apparent easements and roadways and visible encroachments if any.

This survey is made for the exclusive use of the present owners of the property, and also those who purchase, mortgage, or guarantee the title therein, within one year from date hereof.

Dated at Burlington this 10th day of December, 1996.
John F. Degan
John F. Degan, Land Surveyor, S 242
500 N. Elm St., Burlington, WI 53105

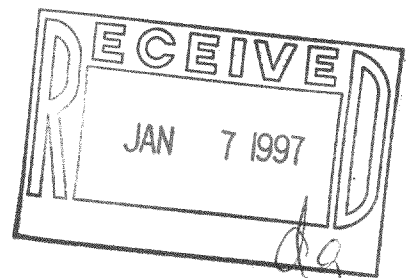

14# 361

0A-2398-4
318-579