




PLAT OF SURVEY

Survey For: WOLTER BROS. BUILDERS
Location: Potter Road

Description: LOT 3 CERTIFIED SURVEY MAP NO. 1958, located in part of the Northeast 1/4 of the Southwest 1/4 and part of the Southeast 1/4 of the Southwest 1/4 and part of the Southwest 1/4 of the Southwest 1/4 and part of the Northwest 1/4 of the Southwest 1/4, all in Section 13, Township 3 North, Range 18 East of the 4th Principal Meridian, in the Township of Spring Prairie, Walworth County, Wisconsin.

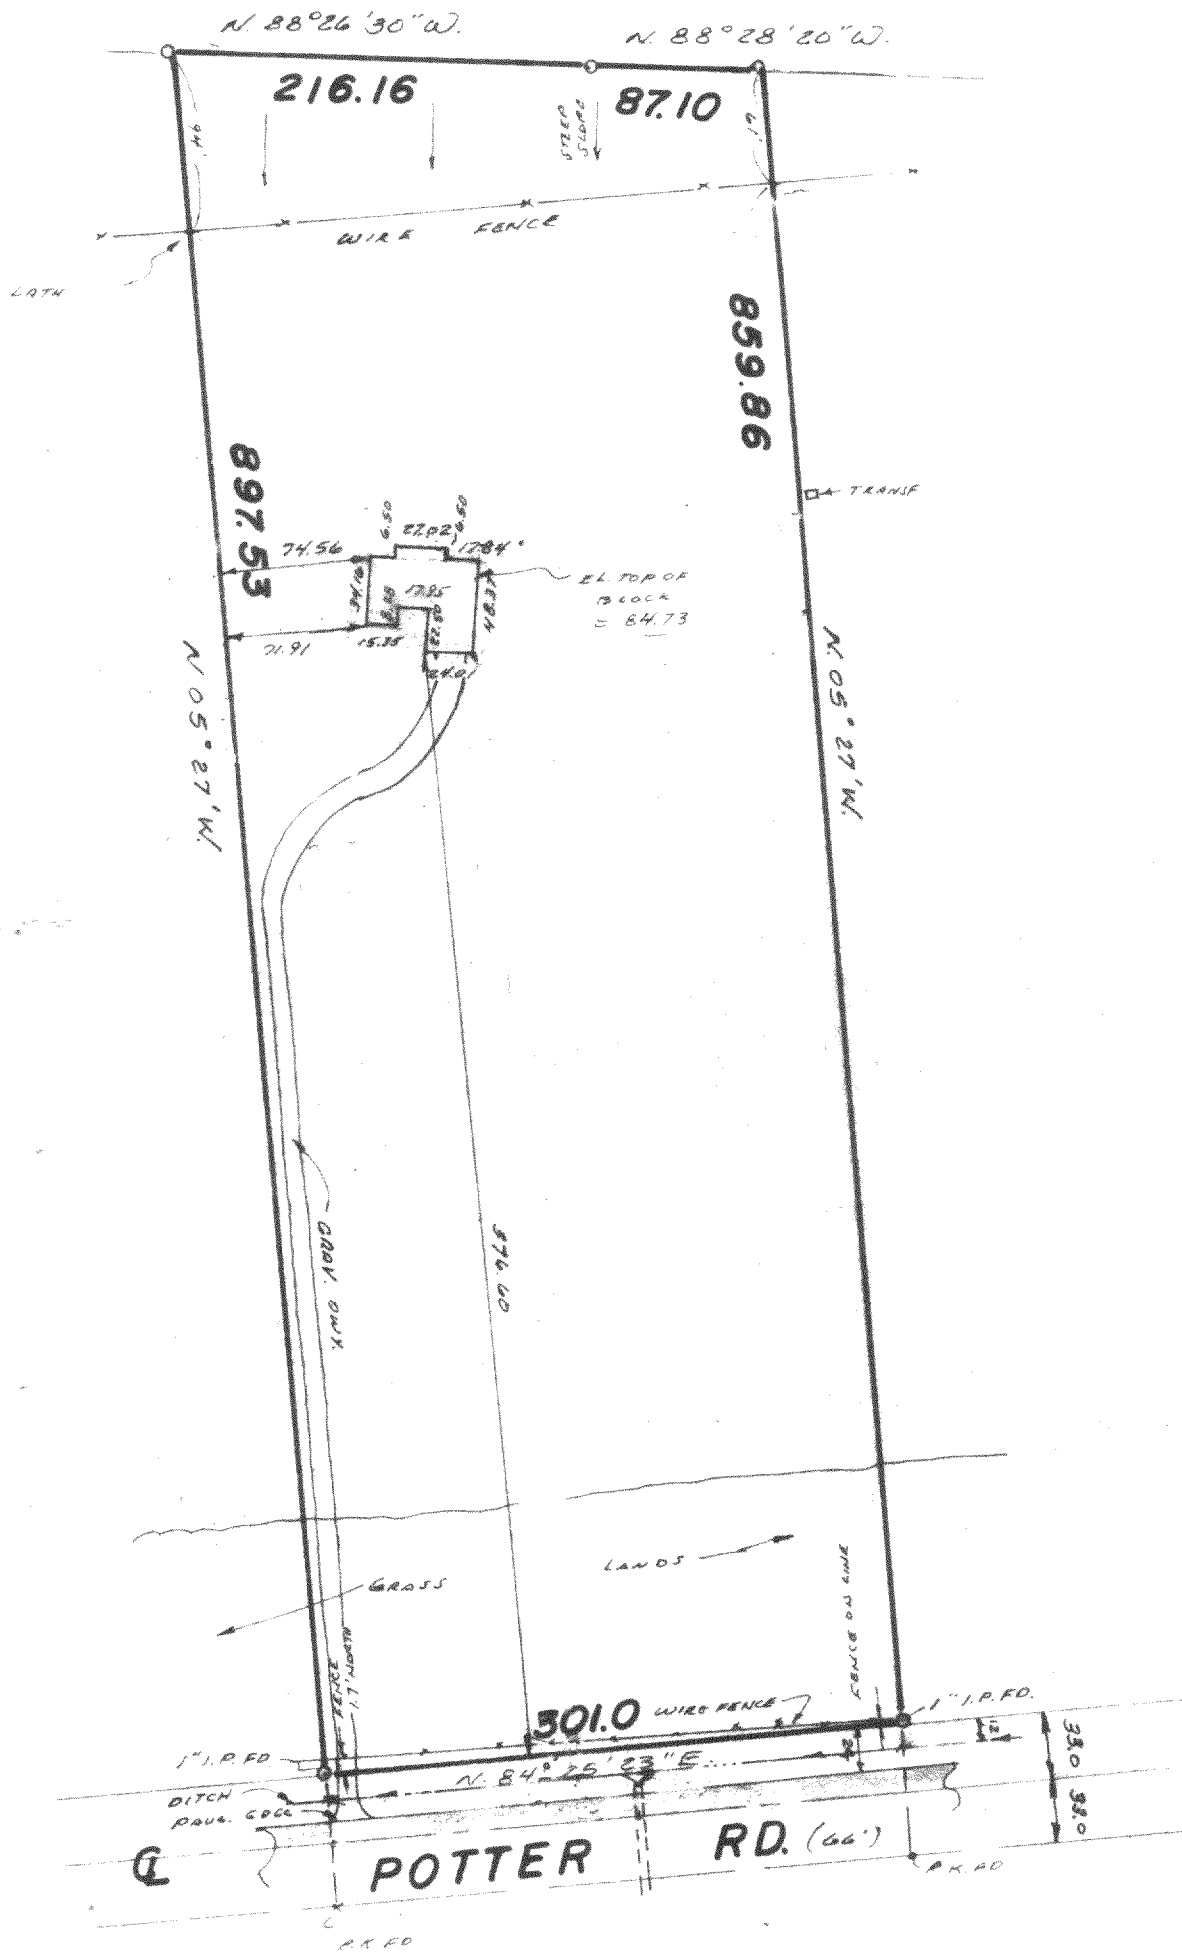

SCALE: 1" = 100'

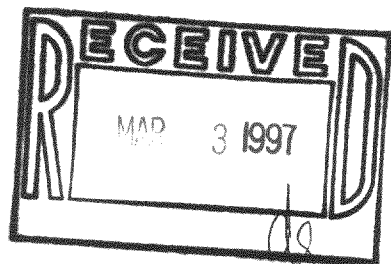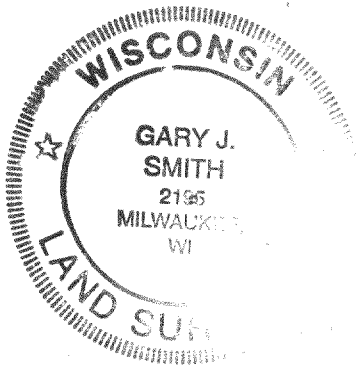


Survey Certificate

State of Wisconsin)
Milwaukee County)SS

We, Interline Survey Services, Inc., certify that we have surveyed the above described property and the above map is a true representation thereof, and shows the size and location of the property, its exterior boundaries, the location and dimensions of all visible structures thereon, fences, apparent easements and roadways and visible encroachments, if any.

This survey is made for the exclusive use of the present owners of the Property, and also those who purchase, mortgage, or guarantee the title thereto, within one (1) year from date hereof.

Gary J. Smith
Wisconsin Registered Land Surveyor

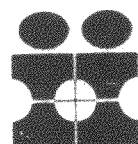

INTERLINE SURVEY
SERVICES, INC.

11201 W. FOREST HOME AVE.
HALES CORNERS, WISCONSIN 53130
PHONE 425-2060



JOB NO. 25067
DATED: 11/20/96

PLAT OF SURVEY

Survey For: WOLTER BROS. BUILDERS
Location: Potter Road

EBBOTT

Description: LOT 3 CERTIFIED SURVEY MAP NO. 1958, located in part of the Northeast 1/4 of the Southwest 1/4 and part of the Southwest 1/4 of the Southwest 1/4 and part of the Northwest 1/4 of the Southwest 1/4, all in Section 13, Township 3 North, Range 18 East of the 4th Principal Meridian, in the Township of Spring Prairie, Walworth County, Wisconsin.

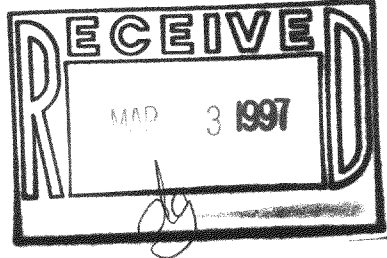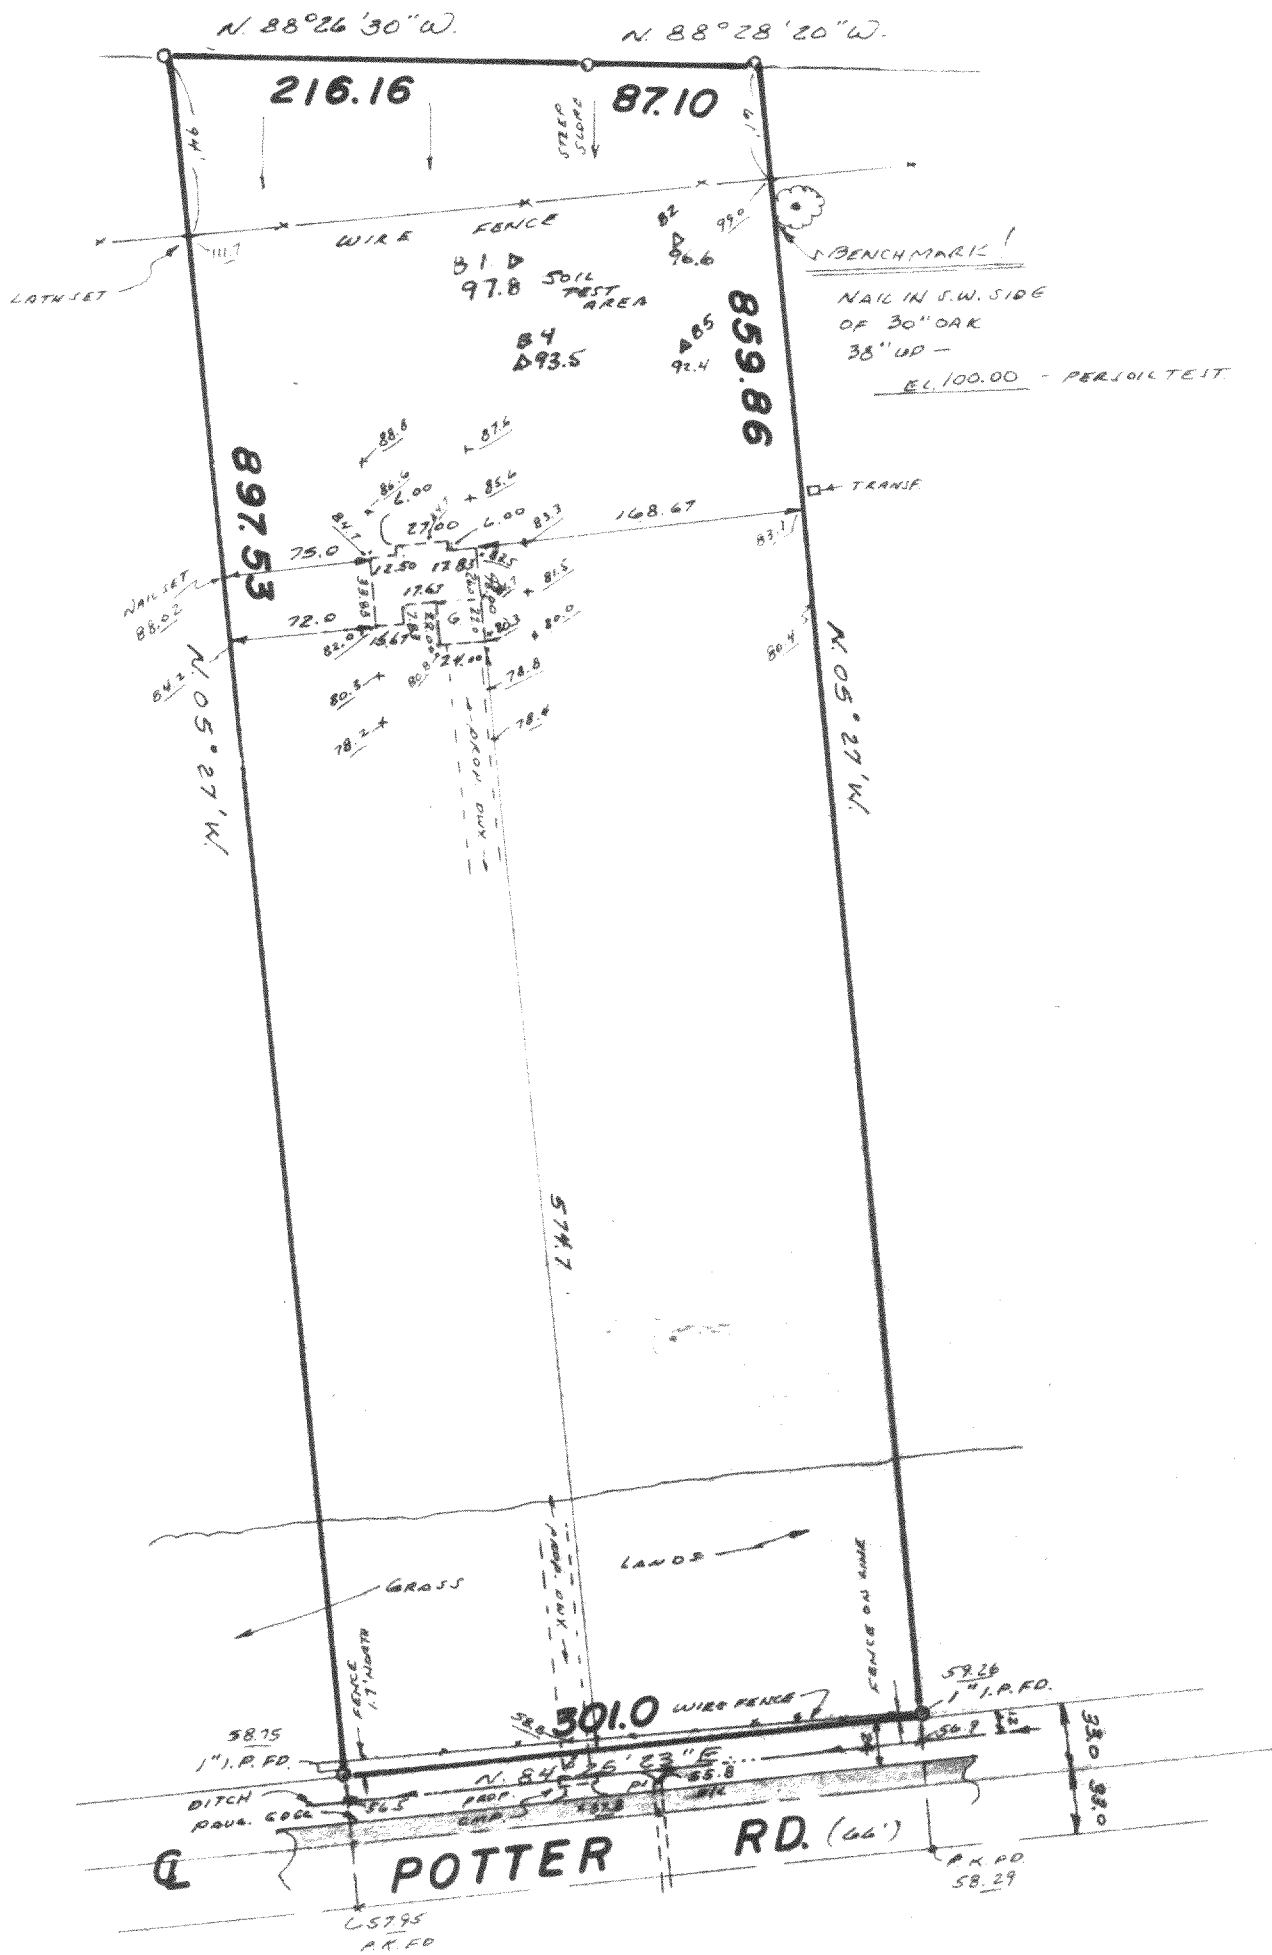

SCALE: 1" = 100'

Survey Certificate

State of Wisconsin)
Milwaukee County) ss
We, Interline Survey Services, Inc., certify that we have surveyed the above described property and the above map is a true representation thereof, and shows the size and location of the property, its exterior boundaries, the location and dimensions of all visible structures thereon, fences, apparent easements and roadways and visible encroachments, if any.

This survey is made for the exclusive use of the present owners of the Property, and also those who purchase, mortgage, or guarantee the title thereto, within one (1) year from date hereof.

Gary J. Smith
Wisconsin Registered Land Surveyor

INTERLINE SURVEY SERVICES, INC.
11221 W. FOREST HOME AVE.
HALES CORNERS, WISCONSIN 53130
PHONE 425-2060

JOB NO. 25030
DATED: 11/5/96

OA-1958-3
318-584