

PLAT OF SURVEY

RSV ENGINEERING, INC
ENGINEERS, PLANNERS, SURVEYORS
CONSTRUCTION MANAGERS
545 BAY VIEW ROAD, MUKWONAGO, WISCONSIN 53149 (414) 363-2004

FOR: JOHN AND PATRICIA EICH

DATE: 10/16/96


DESCRIPTION: BEING LOT 3 OF C.S.M. #2759, LOCATED IN PART OF THE
NE $\frac{1}{4}$ OF THE NE $\frac{1}{4}$ OF SECTION 17, TOWN 3 NORTH,
RANGE 18 EAST, TOWN OF SPRING PRAIRIE, WALWORTH
COUNTY, WISCONSIN.



SCALE: 1"=100'

LEGEND

● IRON PIPE FOUND

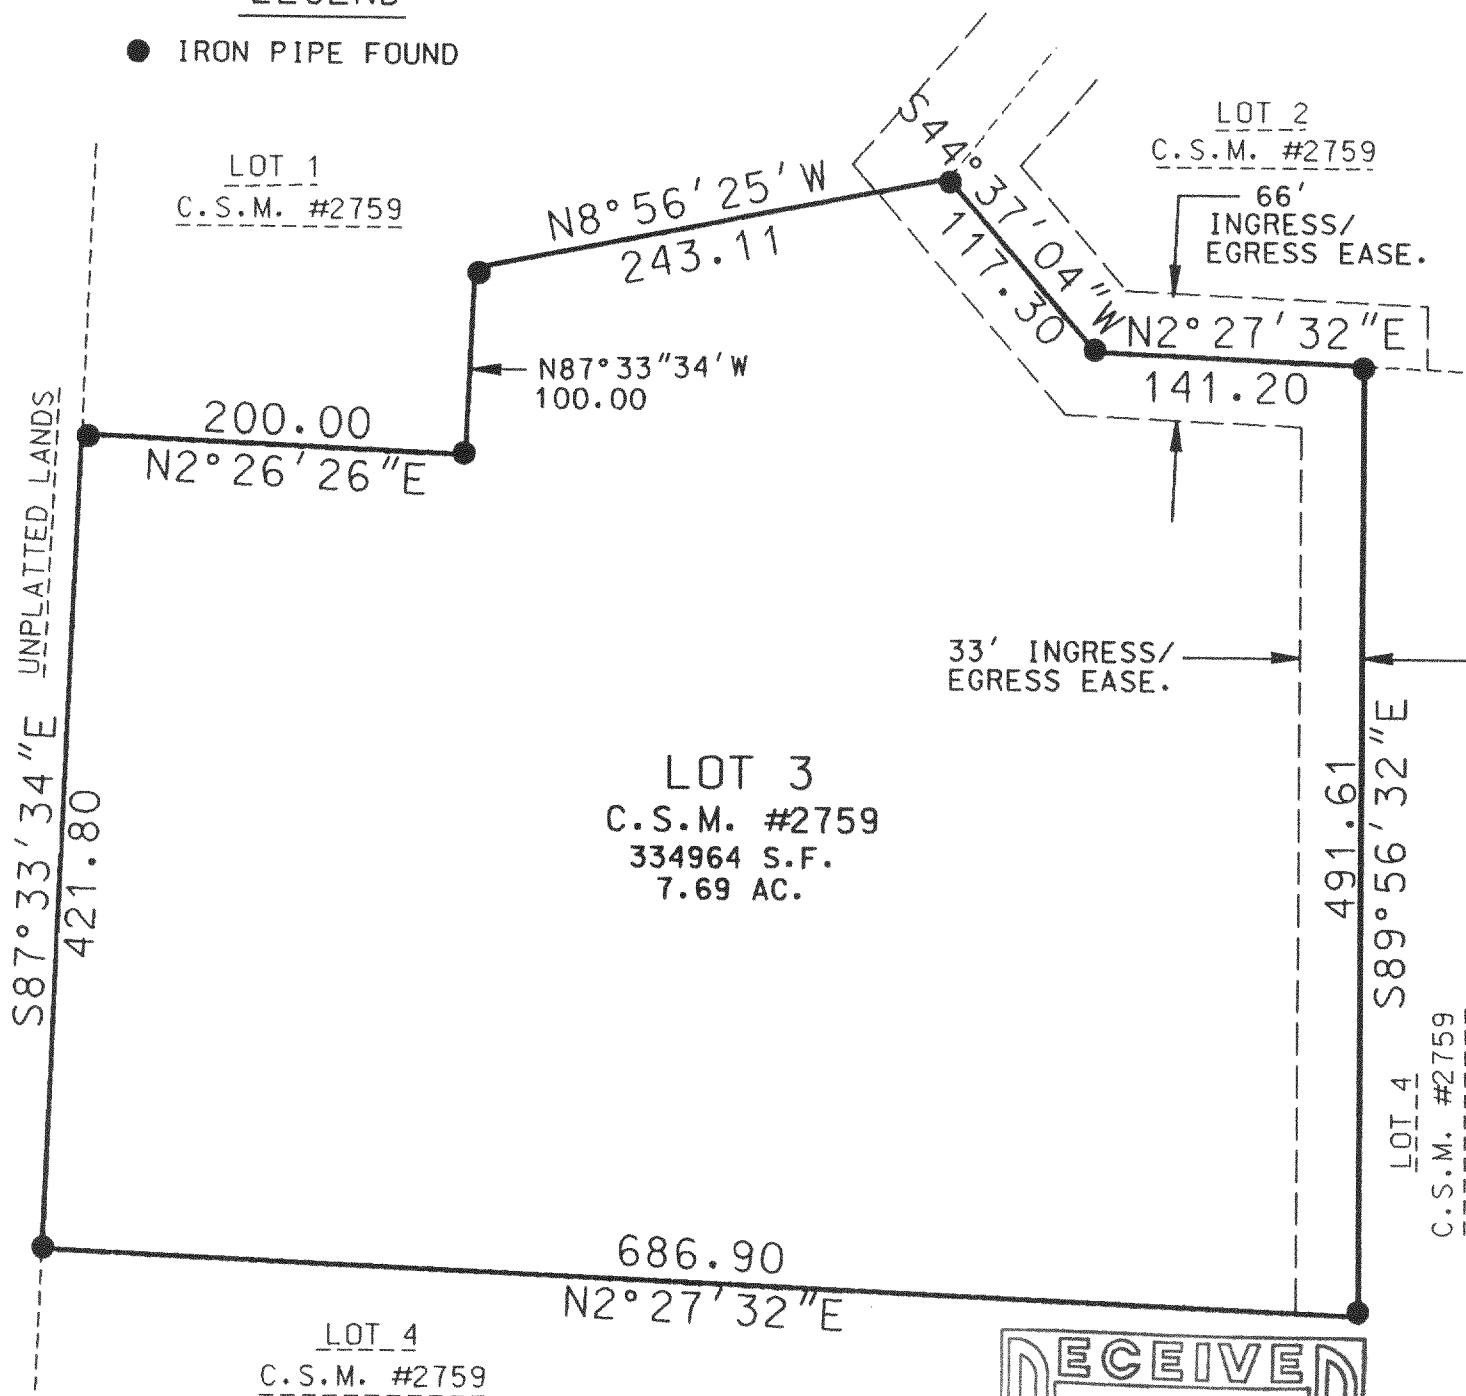


THE ABOVE MAP IS A TRUE REPRESENTATION THEREOF AND
SHOWS THE SIZE AND LOCATION OF ALL THE PROPERTY,
EXTERIOR BOUNDARIES, THE LOCATION OF ALL VISIBLE
BOUNDARY FENCES, APPARENT EASEMENTS, ROADWAYS
AND VISIBLE ENCROACHMENTS, IF ANY.


THIS SURVEY IS MADE FOR THE USE OF THE PRESENT
OWNERS OF THE PROPERTY, AND ALSO THOSE WHO
PURCHASE, MORTGAGE OR GUARANTEE TITLE THEREIN
WITHIN ONE (1) YEAR FROM DATE HERETO.

BRADFORD L. SPENCER, R.L.S. 2069
RSV#

OA-2759-3

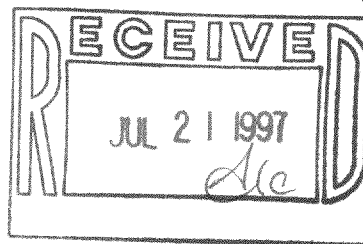

THIS IS ORIGINAL
PRINT ONLY IF
SEAL IS IMPRINTED
IN RED

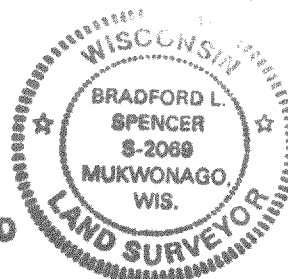

318-600