


PLAT OF SURVEY
-OF-

UNIT 20 IN THE HIGHLANDS OF PARADISE VALLEY CONDOMINIUM, BEING A
CONDINIUM CREATED UNDER THE CONDOMINIUM OWNERSHIP ACT OF THE
STATE OF WISCONSIN BY A DECLARATION OF CONDOMINIUM FOR THE
HIGHLANDS OF PARADISE VALLEY CONDOMINIUM", DATED THE 18TH DAY OF
MAY, 1993 AND RECORDED THE 18TH DAY OF MAY, 1993 IN THE OFFICE OF
THE REGISTER OF DEEDS FOR WALWORTH COUNTY, WISCONSIN IN VOLUME
623 OF RECORDS, AT PAGE 3214 THROUGH 3256, AS DOCUMENT NO.
257614 AND BY A CONDOMINIUM PLAT THEREFOR.

PREPARED FOR: TERRY TYNAN

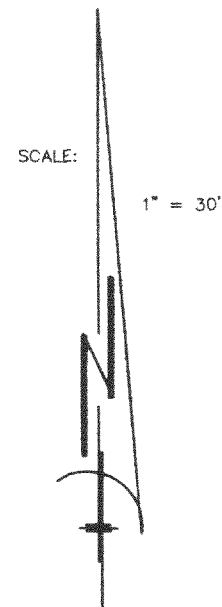


LEGEND

○ FOUND IRON PIPE

● SET IRON PIPE




"I hereby certify that I have surveyed the above described
property and that the above map is a correct representation thereof
and shows the size and location of the property, its exterior
boundaries, the location of all visible structures and dimensions
of all principal buildings thereon, boundary fences, apparent
easements, roadways and encroachments, if any."

"This survey is made for the use of the present owners of the
property, and those who purchase, mortgage, or guarantee the
title thereto within one year from date hereof."

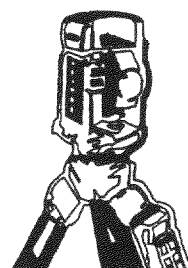

B.W. SURVEYING

LAND SURVEYS
MAPPING AND PLANNING
412 N. PINE STREET
BURLINGTON, WI 53105
(414)-767-0225

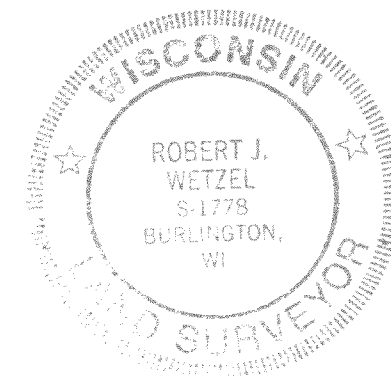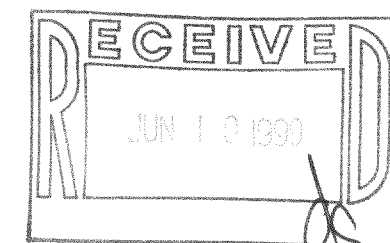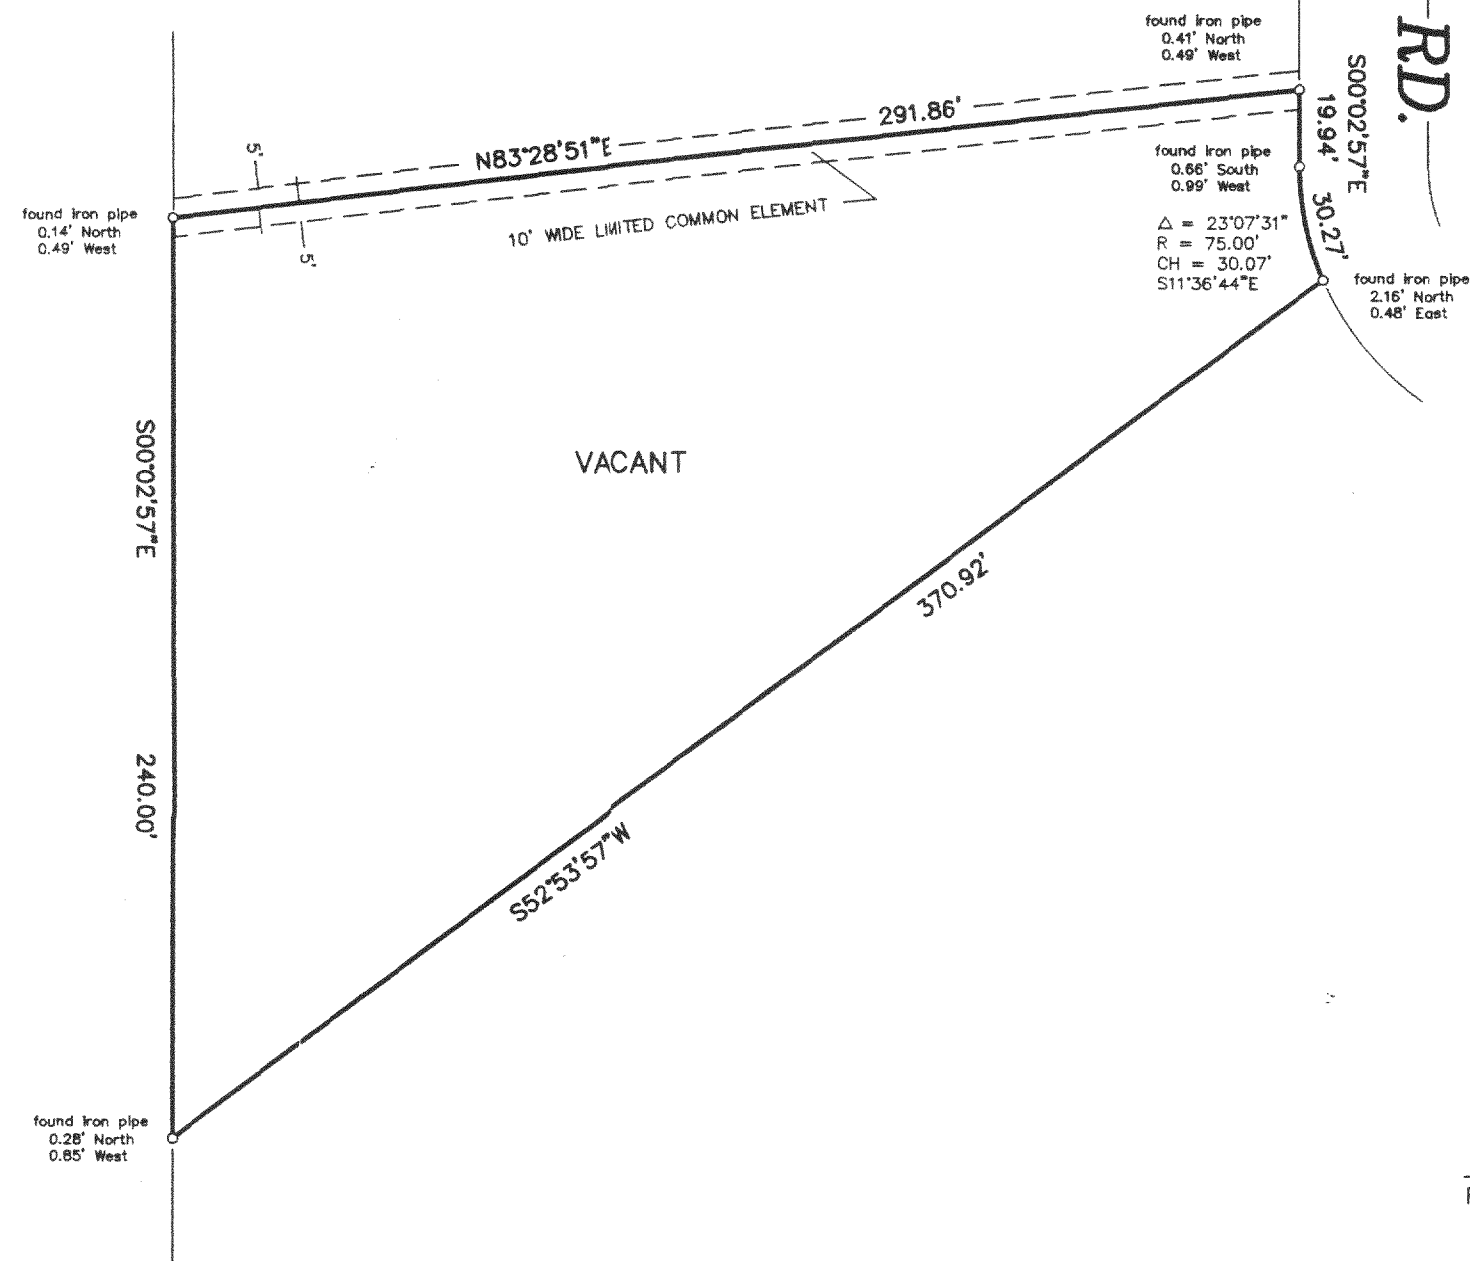

THIS IS NOT AN ORIGINAL PRINT
UNLESS THIS SEAL IS RED.

Robert J. Wetzel
ROBERT J. WETZEL S-1778

11 / 9 / 98
DATE

3750
JOB NUMBER

042-20

318-672