

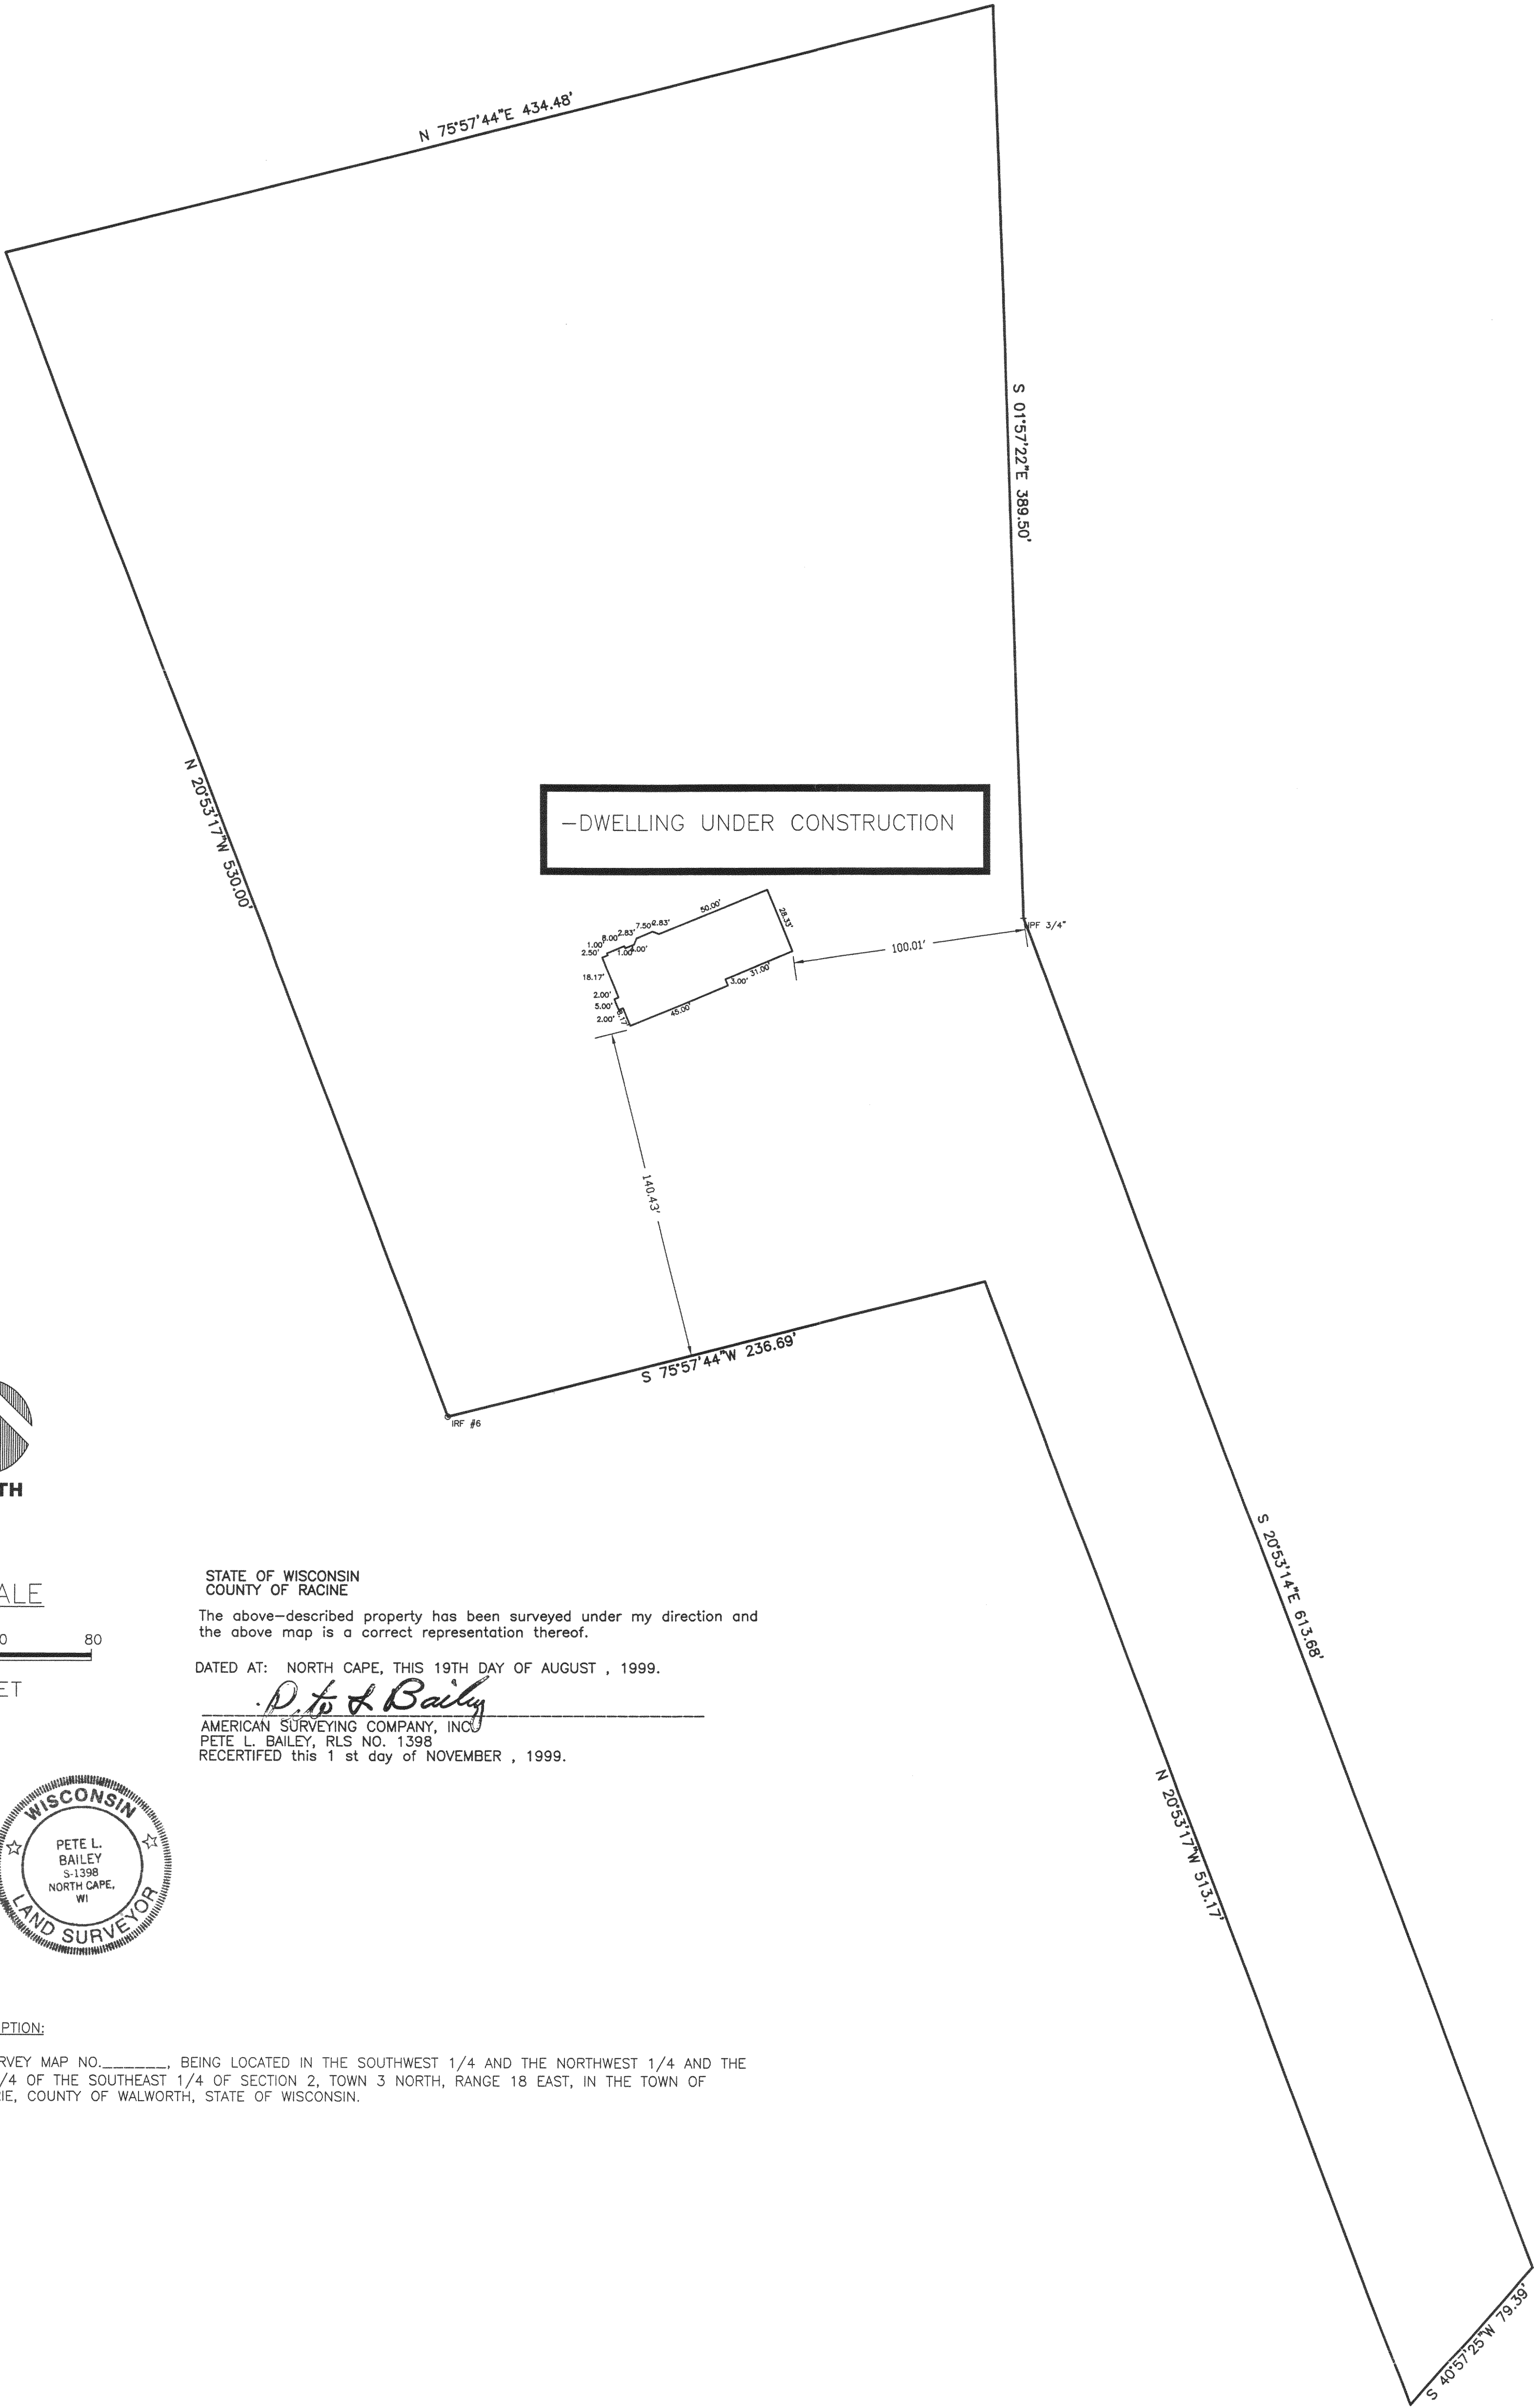


SCALE

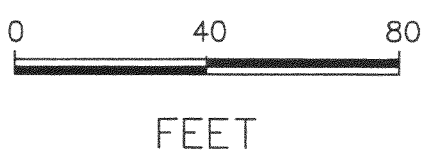

FEET

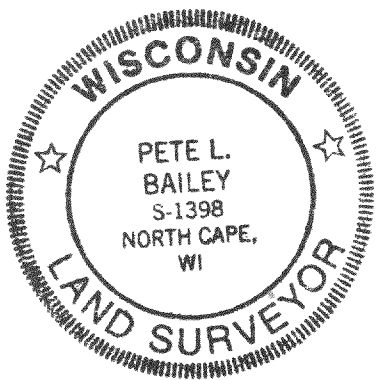

STATE OF WISCONSIN
COUNTY OF RACINE

The above-described property has been surveyed under my direction and the above map is a correct representation thereof.


DATED AT: NORTH CAPE, THIS 19TH DAY OF AUGUST, 1999.

P. L. Bailey

AMERICAN SURVEYING COMPANY, INC.
PETE L. BAILEY, RLS. NO. 1398
RECERTIFIED this 1 st day of NOVEMBER, 1999.

LEGAL DESCRIPTION:

CERTIFIED SURVEY MAP NO. _____, BEING LOCATED IN THE SOUTHWEST 1/4 AND THE NORTHWEST 1/4 AND THE SOUTHEAST 1/4 OF THE SOUTHEAST 1/4 OF SECTION 2, TOWN 3 NORTH, RANGE 18 EAST, IN THE TOWN OF SPRING PRAIRIE, COUNTY OF WALWORTH, STATE OF WISCONSIN.

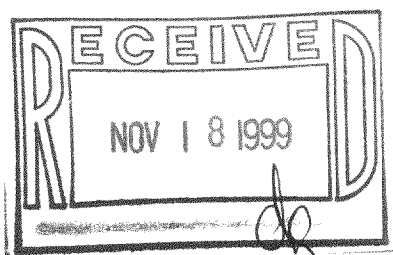


Sheet
1
of
1

TOWN OF SPRING PRAIRIE

PROJECT:
PLAT OF SURVEY/STAKEOUT SURVEY

PREPARED FOR: NORM KEEKER AND SONS
OWNERS: RICH & VICKI BLAZER

DRAWN BY:	PLB	REVISIONS:	DATE
CHECKED BY:	PLB		
PLOT SCALE:	1 = 40		
DATE:	08/02/99		
JOB NO.:	99200		
DWG. FILE:	JN99219		

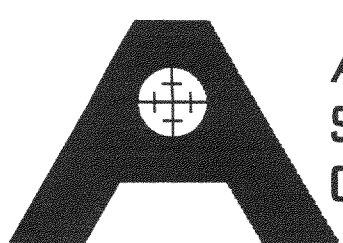

AMERICAN
SURVEYING
COMPANY, INC.

12207 C.T.H. "K" FRANKSVILLE, WISCONSIN 53126
TEL. (414) 835-4774 FAX: (414) 835-2379

CA-328-1 318-694