


UNIT 12 OF PHASE 2 OF THE
HIGHLANDS OF PARADISE VALLEY, A
CONDOMINIUM LOCATED IN SECTION
15, TOWN 3 NORTH, RANGE 18 EAST,
WALWORTH COUNTY, WISCONSIN.


OWNER: JERRY KUTA
970 DOROTHY CT.
BURLINGTON, WI. 53105

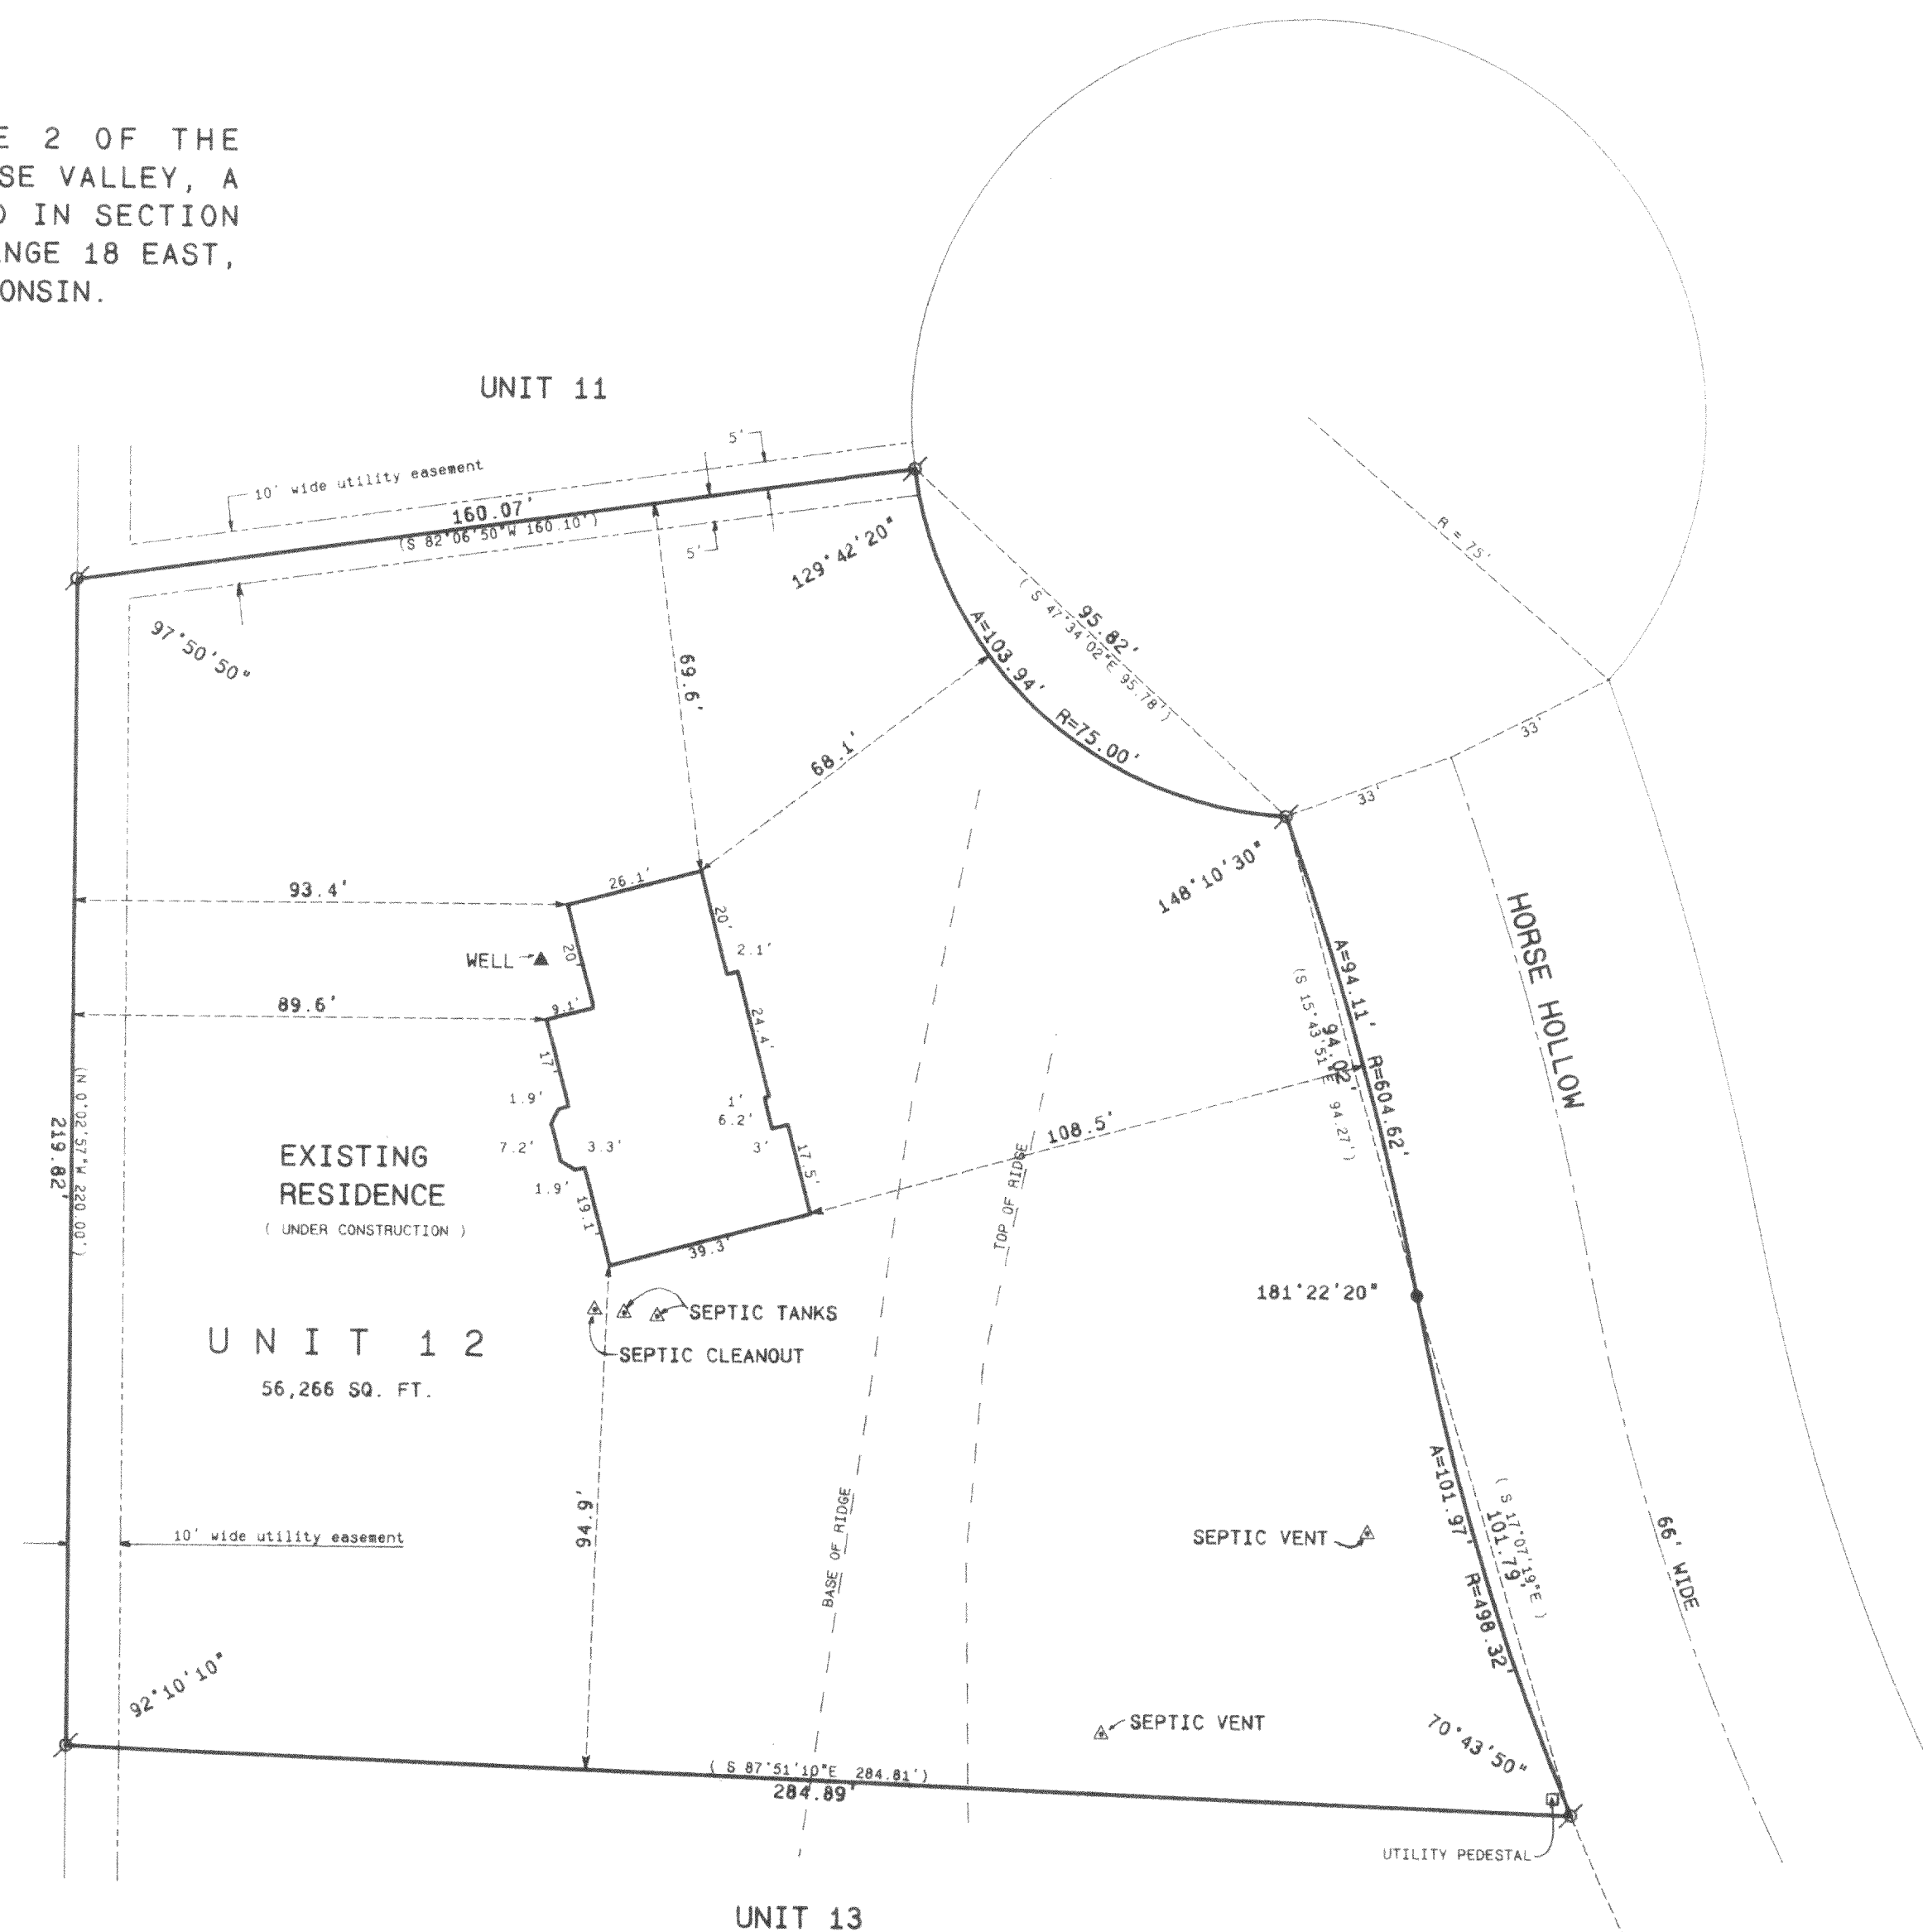

SCALE 1" = 30 FEET


Legend

- J" FOUND IRON PIPE
 ● FOUND IRON ROD
 □ FOUND BRASS CAPPED MONUMENT
 ✕ FOUND CONCRETE MONUMENT
 + CHISEL CUT IN CONCRETE
 ● SET IRON ROD, 24" LONG, WEIGHING
 1.5 LBS./LINEAL FT., 3/4" DIA.
 ● SET IRON ROD, 30" LONG, WEIGHING
 4 LBS./LINEAL FT., 1-11/16" DIA.
 [xx] RECORDED AS DIMENSION
 --- X --- X --- EXISTING FENCE

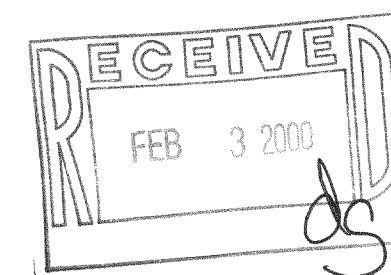

SCALE: 1" = 30 FEET

REVISED MARCH 18, 1999
AS BUILT RESIDENCE LOCATED AND PLAT REVISED 1/24/00

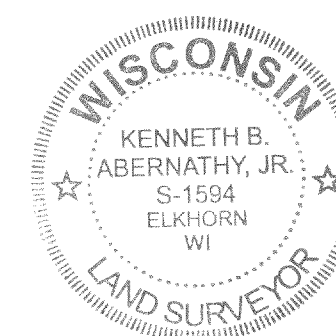

"I hereby certify that the above described property has been surveyed by me or under my direction and that the above map is a true representation thereof and shows the size and location of the property, its exterior boundaries, the location of all visible structures and dimensions of all principal buildings thereon, boundary fences, apparent easements, roadways and visible encroachments, if any."

Kenneth B. Abernathy
KENNETH B. ABERNATHY, JR.
WISCONSIN REGISTERED LAND-SURVEYOR
S-1594
Date: MARCH 1st 1999 Job No. 98.1214

OH2-12

318-707