

LEGAL DESCRIPTION

LOT #2 OF CSM #_____, BEING A PART OF THE NORTHEAST 1/4 AND SOUTHEAST 1/4 OF THE NORTHEAST 1/4 OF SECTION 2, TOWNSHIP 3 NORTH, RANGE 18 EAST, TOWN OF SPRING PRAIRIE, WALWORTH COUNTY, WISCONSIN.

CSM #2538


S 88°25'23"W 485.82'

-DWELLING UNDER CONSTRUCTION


N 30°29'32"E 179.35'

SCALE

0 40 80
FEET

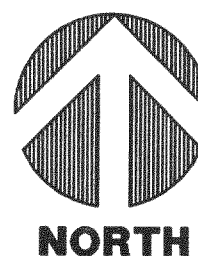

S 01°49'01"E 383.26'

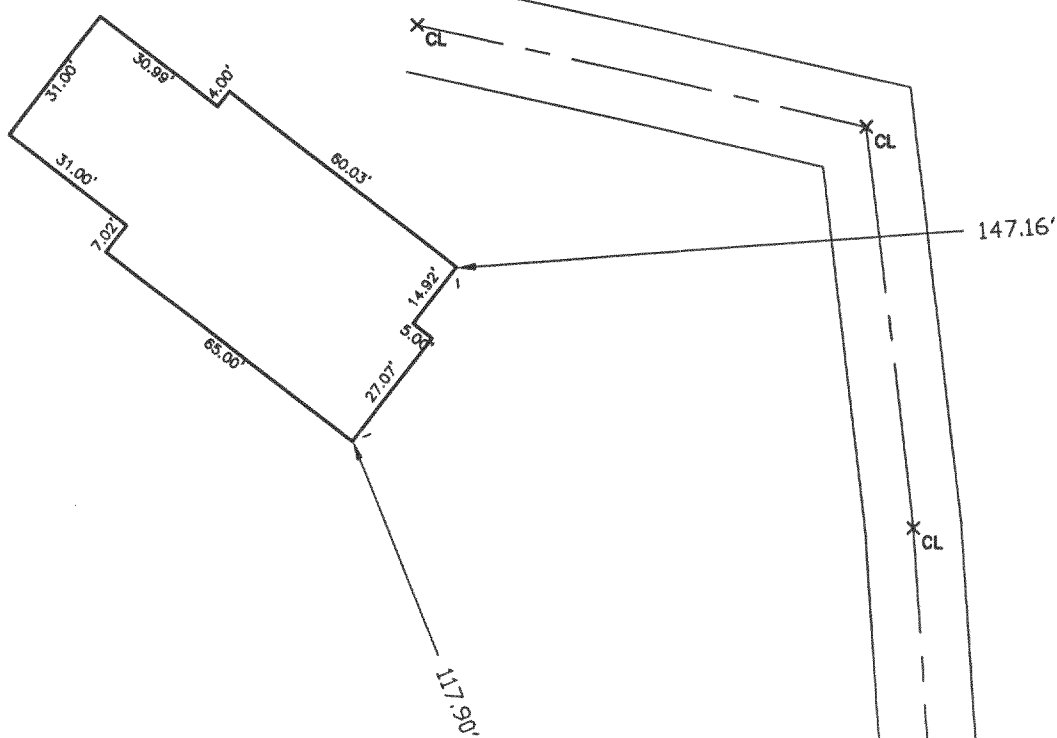

SETBACK LINE PER CSM

N 04°18'29"W 493.16'

S 55°08'59"E 440.40'



STATE OF WISCONSIN
COUNTY OF RACINE

The above-described property has been surveyed under my direction and the above map is a correct representation thereof.

DATED AT: NORTH CAPE, THIS 30TH DAY OF AUGUST, 1999.

P. L. & Bailey

AMERICAN SURVEYING COMPANY, INC.
PETE L. BAILEY, RLS NO. 1398
RECERTIFIED this 26th day of NOVEMBER, 1999.

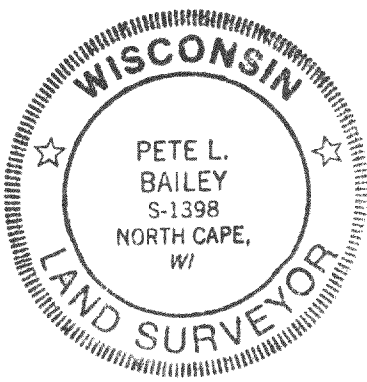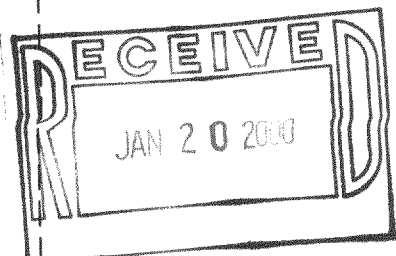


TO CTH 'D'

TOWN OF SPRING PRAIRIE

PROJECT:
STAKEOUT/PLAT OF SURVEY

PREPARED FOR, NORM KEEKER
OWNER, AL & SHARIE HANSEN

AMERICAN
SURVEYING
COMPANY, INC.

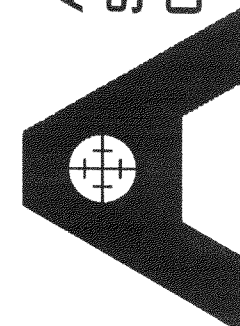

12207 C.T.H. "K" FRANKSVILLE, WISCONSIN 53126
TEL. (414) 835-4774 FAX: (414) 835-2379

DATE

REVISIONS:

DRAWN BY: ALJ

CHECKED BY: ALJ

PLOT SCALE: 1" = 40'

DATE: 08/30/99

JOB NO.: 99226

DWG. FILE: JN99233

Sheet

1
of
1

0A-2870-2

318-716