


PLAT OF SURVEY AND HOUSE LOCATION
OF
LOTS 6, 7, 18 & 19, BLOCK 13 OF HONEY LAKE SUBD
13th ADD. TOWN OF SPRING PRAIRIE, WALWORTH COUNTY
WISCONSIN

"I certify that I have surveyed the above described property and that the above plat is an accurate survey and a true representation thereof and correctly shows the exterior boundary lines and location of buildings and other improvements on said property and the correct measurements thereof."

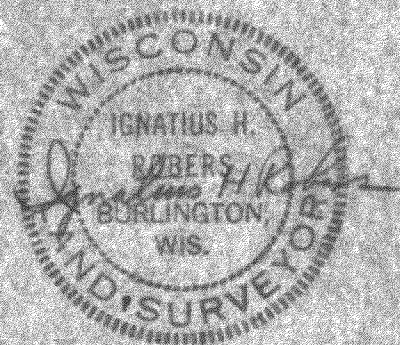


ROBERS & BOYD, INC.
CONSULTING ENGINEERS
116 E. CHESTNUT STREET
BURLINGTON, WISCONSIN



LEGEND

○ IRON PILE
SCALE 1"=30'

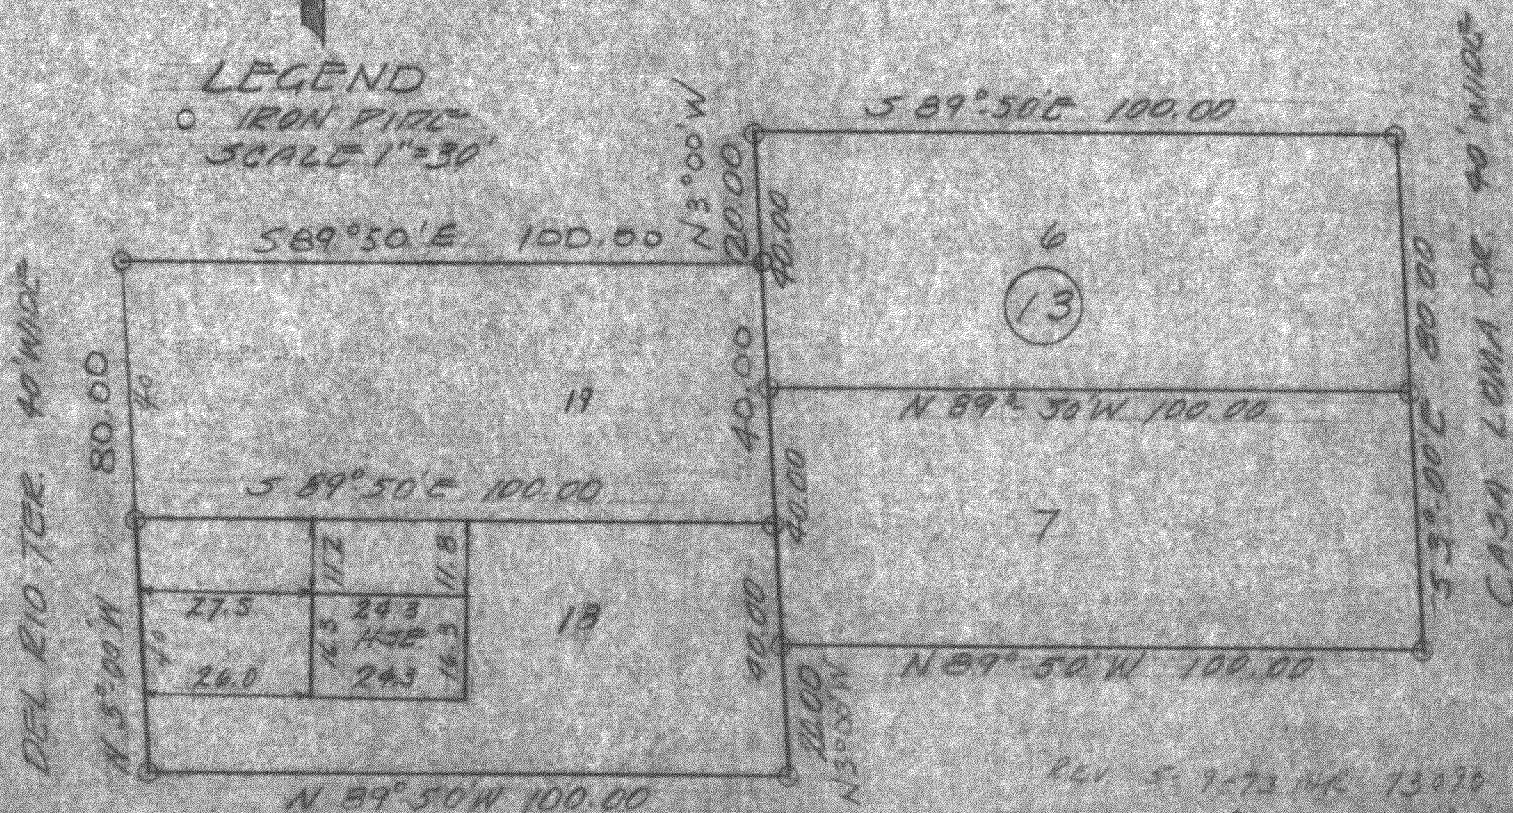

044-93,99

318-72