


This survey is a retracement
of a prior survey by R.J.
Wetzel (S-1778) in 1999.

Scale
1" = 200'

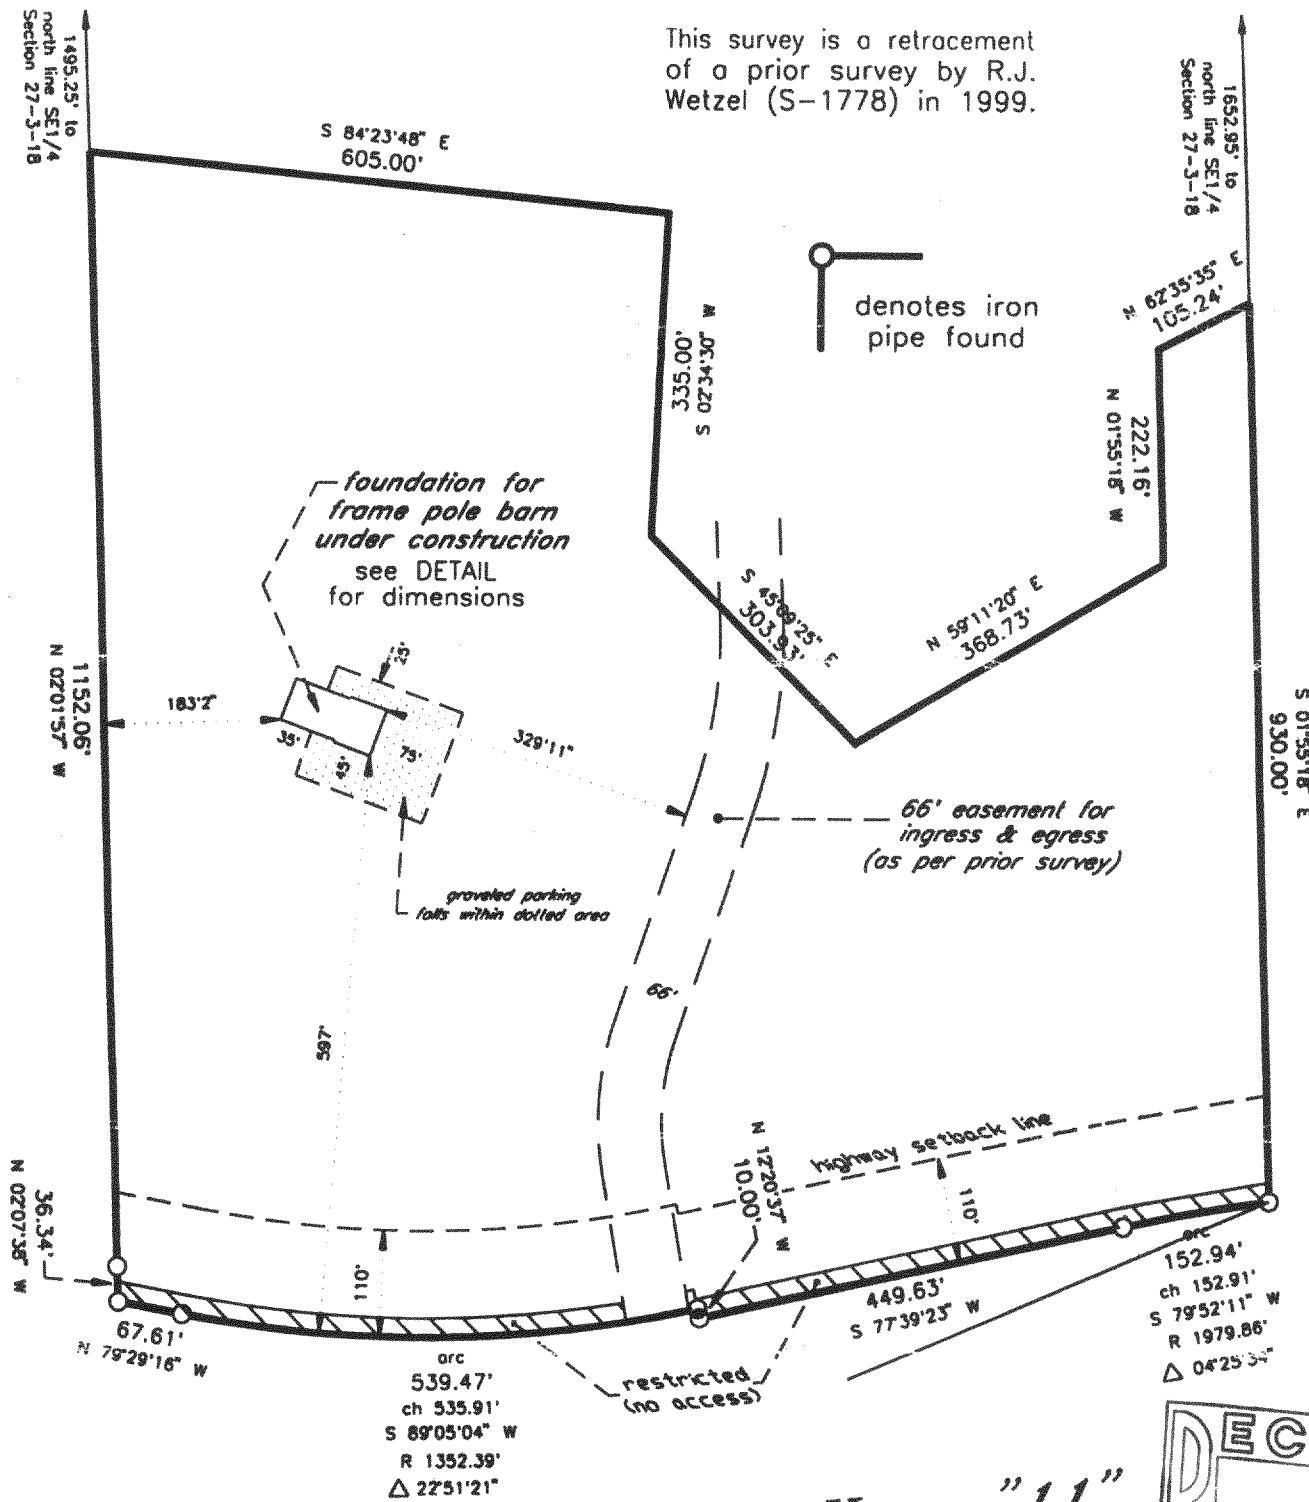

St. Tr. Hwy. "11"

Bearings refer to grid north, state plane coordinate system south zone.

Refer to a current title report for a complete legal description and for any easements or restrictions which may affect this site.

Monumentation has been waived in accordance with A-E 7.01 (2) of the Wisconsin Administrative Code.

MARESCALCO COUNTYWIDE SURVEYING, INC.
1120 80TH STREET KENOSHA, WI 53143
(262) 654 6809 FAX (262) 654 1120



I hereby certify that this plat was drawn by me and the information shown accurately depicts the location of the existing pole barn located upon this site.

[Signature]

Reg. Land Surveyor

September 13, 1999

Revised 7/24/00 to show existing pole barn

25.48 ACRES PARCEL
NORTH SIDE ST. TR. HWY. "11"

in SE1/4 Section 27-3-18

TOWN OF SPRING PRAIRIE
WALWORTH COUNTY, WIS.

-for-

Randy Marescalco

OA 3237-4 & (part of) OA 3237-3

318-739