


DEGEN, FOAT SURVEYING ASSOCIATES

100 SOUTH SECOND STREET
WATERFORD, WISCONSIN
(262)534-5404 (FAX)534-2022

015164
015164S1.DWG

PLAT OF SURVEY

LOT 2, CERTIFIED SURVEY MAP NO. 2962 ACCORDING TO THE RECORDED PLAT THEREOF
RECORDED IN VOLUME 15 OF CERTIFIED SURVEY MAPS ON PAGE 270 AS DOCUMENT NO. 377484,
BEING PART OF THE NORTHEAST 1/4 AND THE SOUTHEAST 1/4 OF THE SOUTHEAST 1/4
OF SECTION 3, TOWN 3 NORTH, RANGE 18 EAST OF THE FOURTH PRINCIPAL MERIDIAN,
TOWN OF SPRING PRAIRIE, WALWORTH COUNTY, WISCONSIN. TOGETHER WITH A 66' WIDE EASEMENT
FOR INGRESS AND EGRESS AS SHOWN ON SAID CERTIFIED SURVEY MAP NO. 2962.

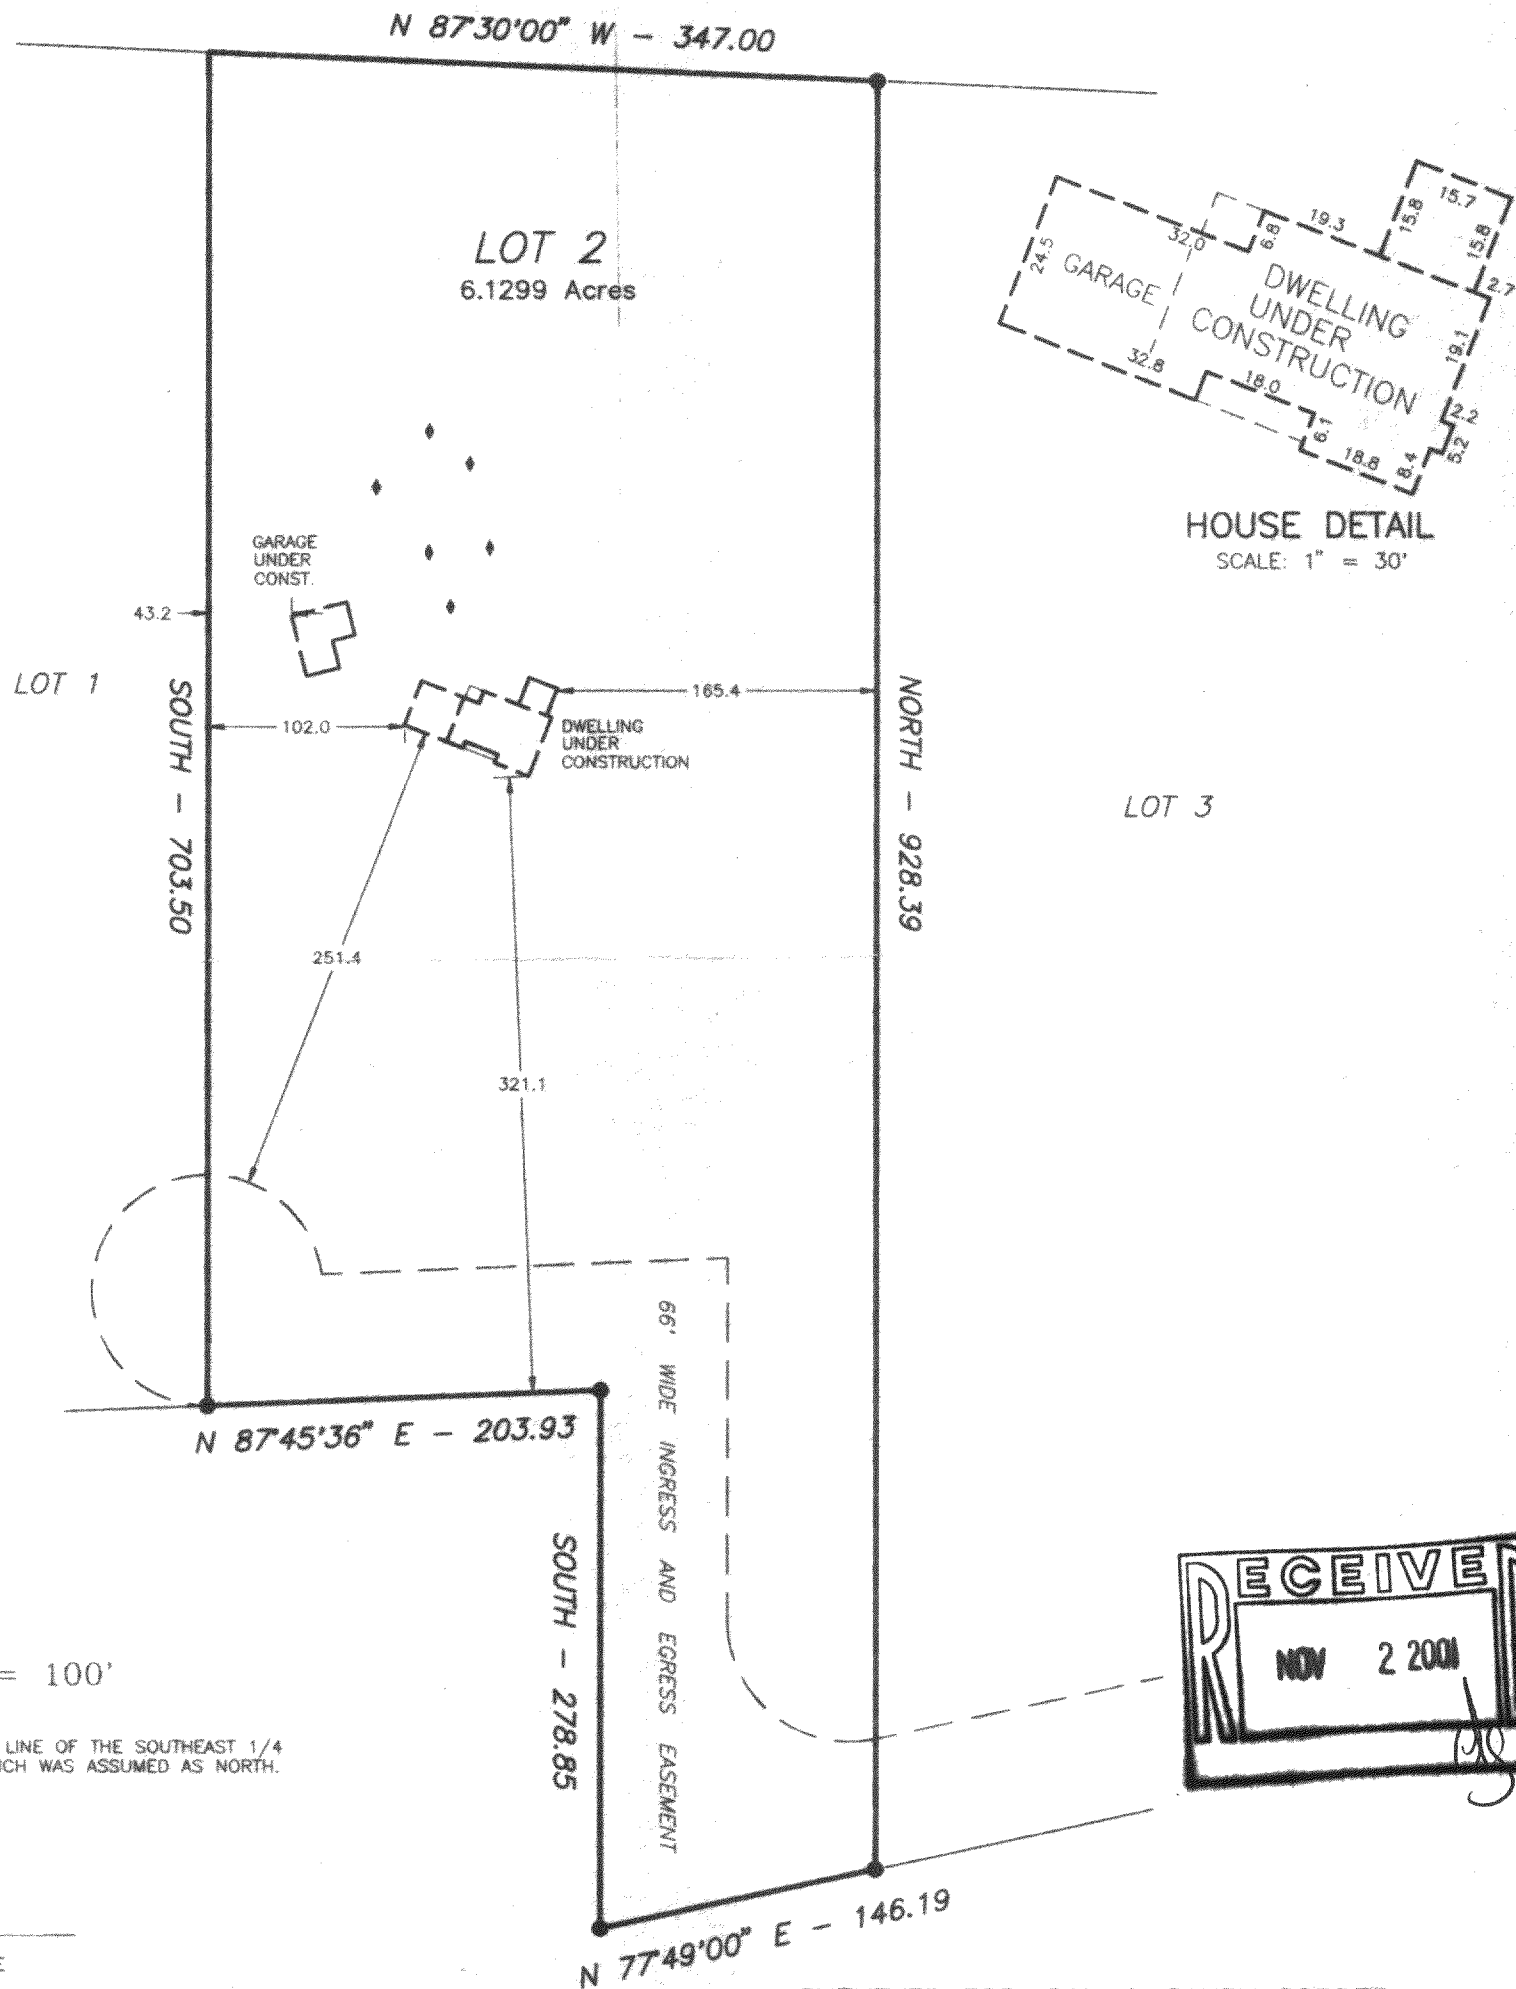

SURVEYED FOR: DAN & SANDY GORDER
S76 W23210 WOODLAND COURT
BIG BEND, WI 53103

I HEREBY CERTIFY THAT I HAVE SURVEYED THE ABOVE DESCRIBED PROPERTY AND THE ABOVE MAP IS A TRUE REPRESENTATION THEREOF AND SHOWS THE SIZE AND LOCATION OF THE PROPERTY, THE LOCATION OF ALL VISIBLE STRUCTURES AND DIMENSIONS OF ALL PRINCIPAL BUILDINGS THEREON, BOUNDARY FENCES, APPARENT EASEMENTS, ROADWAY AND VISIBLE ENCROACHMENTS, IF ANY.

THIS SURVEY IS MADE FOR THE PRESENT OWNERS OF THE PROPERTY, AND ALSO THOSE WHO PURCHASE, OR GUARANTEE THE TITLE THERETO WITHIN (1) YEAR FROM THE DATE HEREOF.

DATED AT WATERFORD THIS 20TH DAY OF JUNE 20 01

RECEIVED OCTOBER 9, 2001

0A-2962-2
318-771