


✓ OA 367-1

# Plat of Survey

of  
**Lot 2 of Certified Survey Map No. 367,**  
recorded in Vol. 2 on Page 157 and located in the Southwest  
1/4 of Section 14, Town 3 North, Range 18 East, Town of  
Spring Prairie, Walworth County, Wisconsin.

Surveyed for: **Coldwell Banker, Leith & Associates**  
102 North Wisconsin Street  
Elkhorn, Wisconsin. 53121

Survey Date: May 7, 2002.  
Revisions:




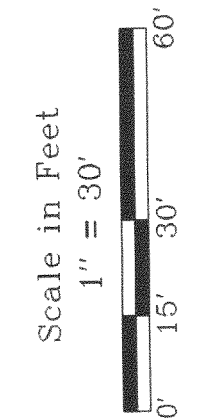


**Jensen & Olson Land Surveying, LLC**  
45 South Wisconsin Street  
Elkhorn, Wisconsin. 53121  
P.O. Box 322  
Telephone (262) 723-3434  
Facsimile (262) 723-8044

**Legend**  
Found Iron Pipe  
Set Iron Rod, 3/4" dia.  
Recorded Information  
Utility Pole  
Asphalt Surface  
Concrete Cover  
Gravel Surface  
Concrete Surface

Sheet 1 of 1 Sheets  
Job Reference Number  
**2002.076**  
2002.076

Tax Parcel  
OSP 1400002A1

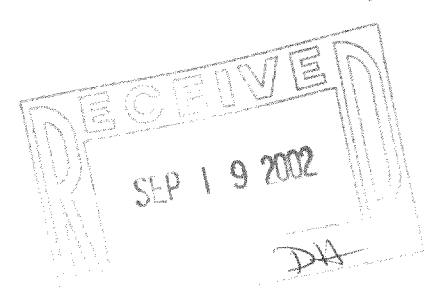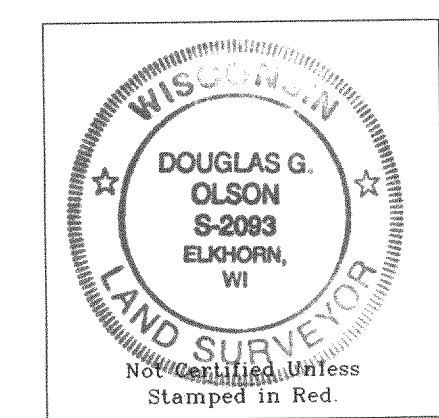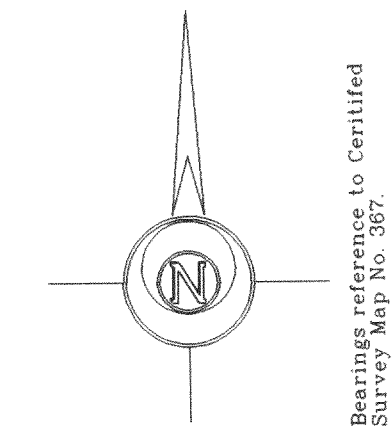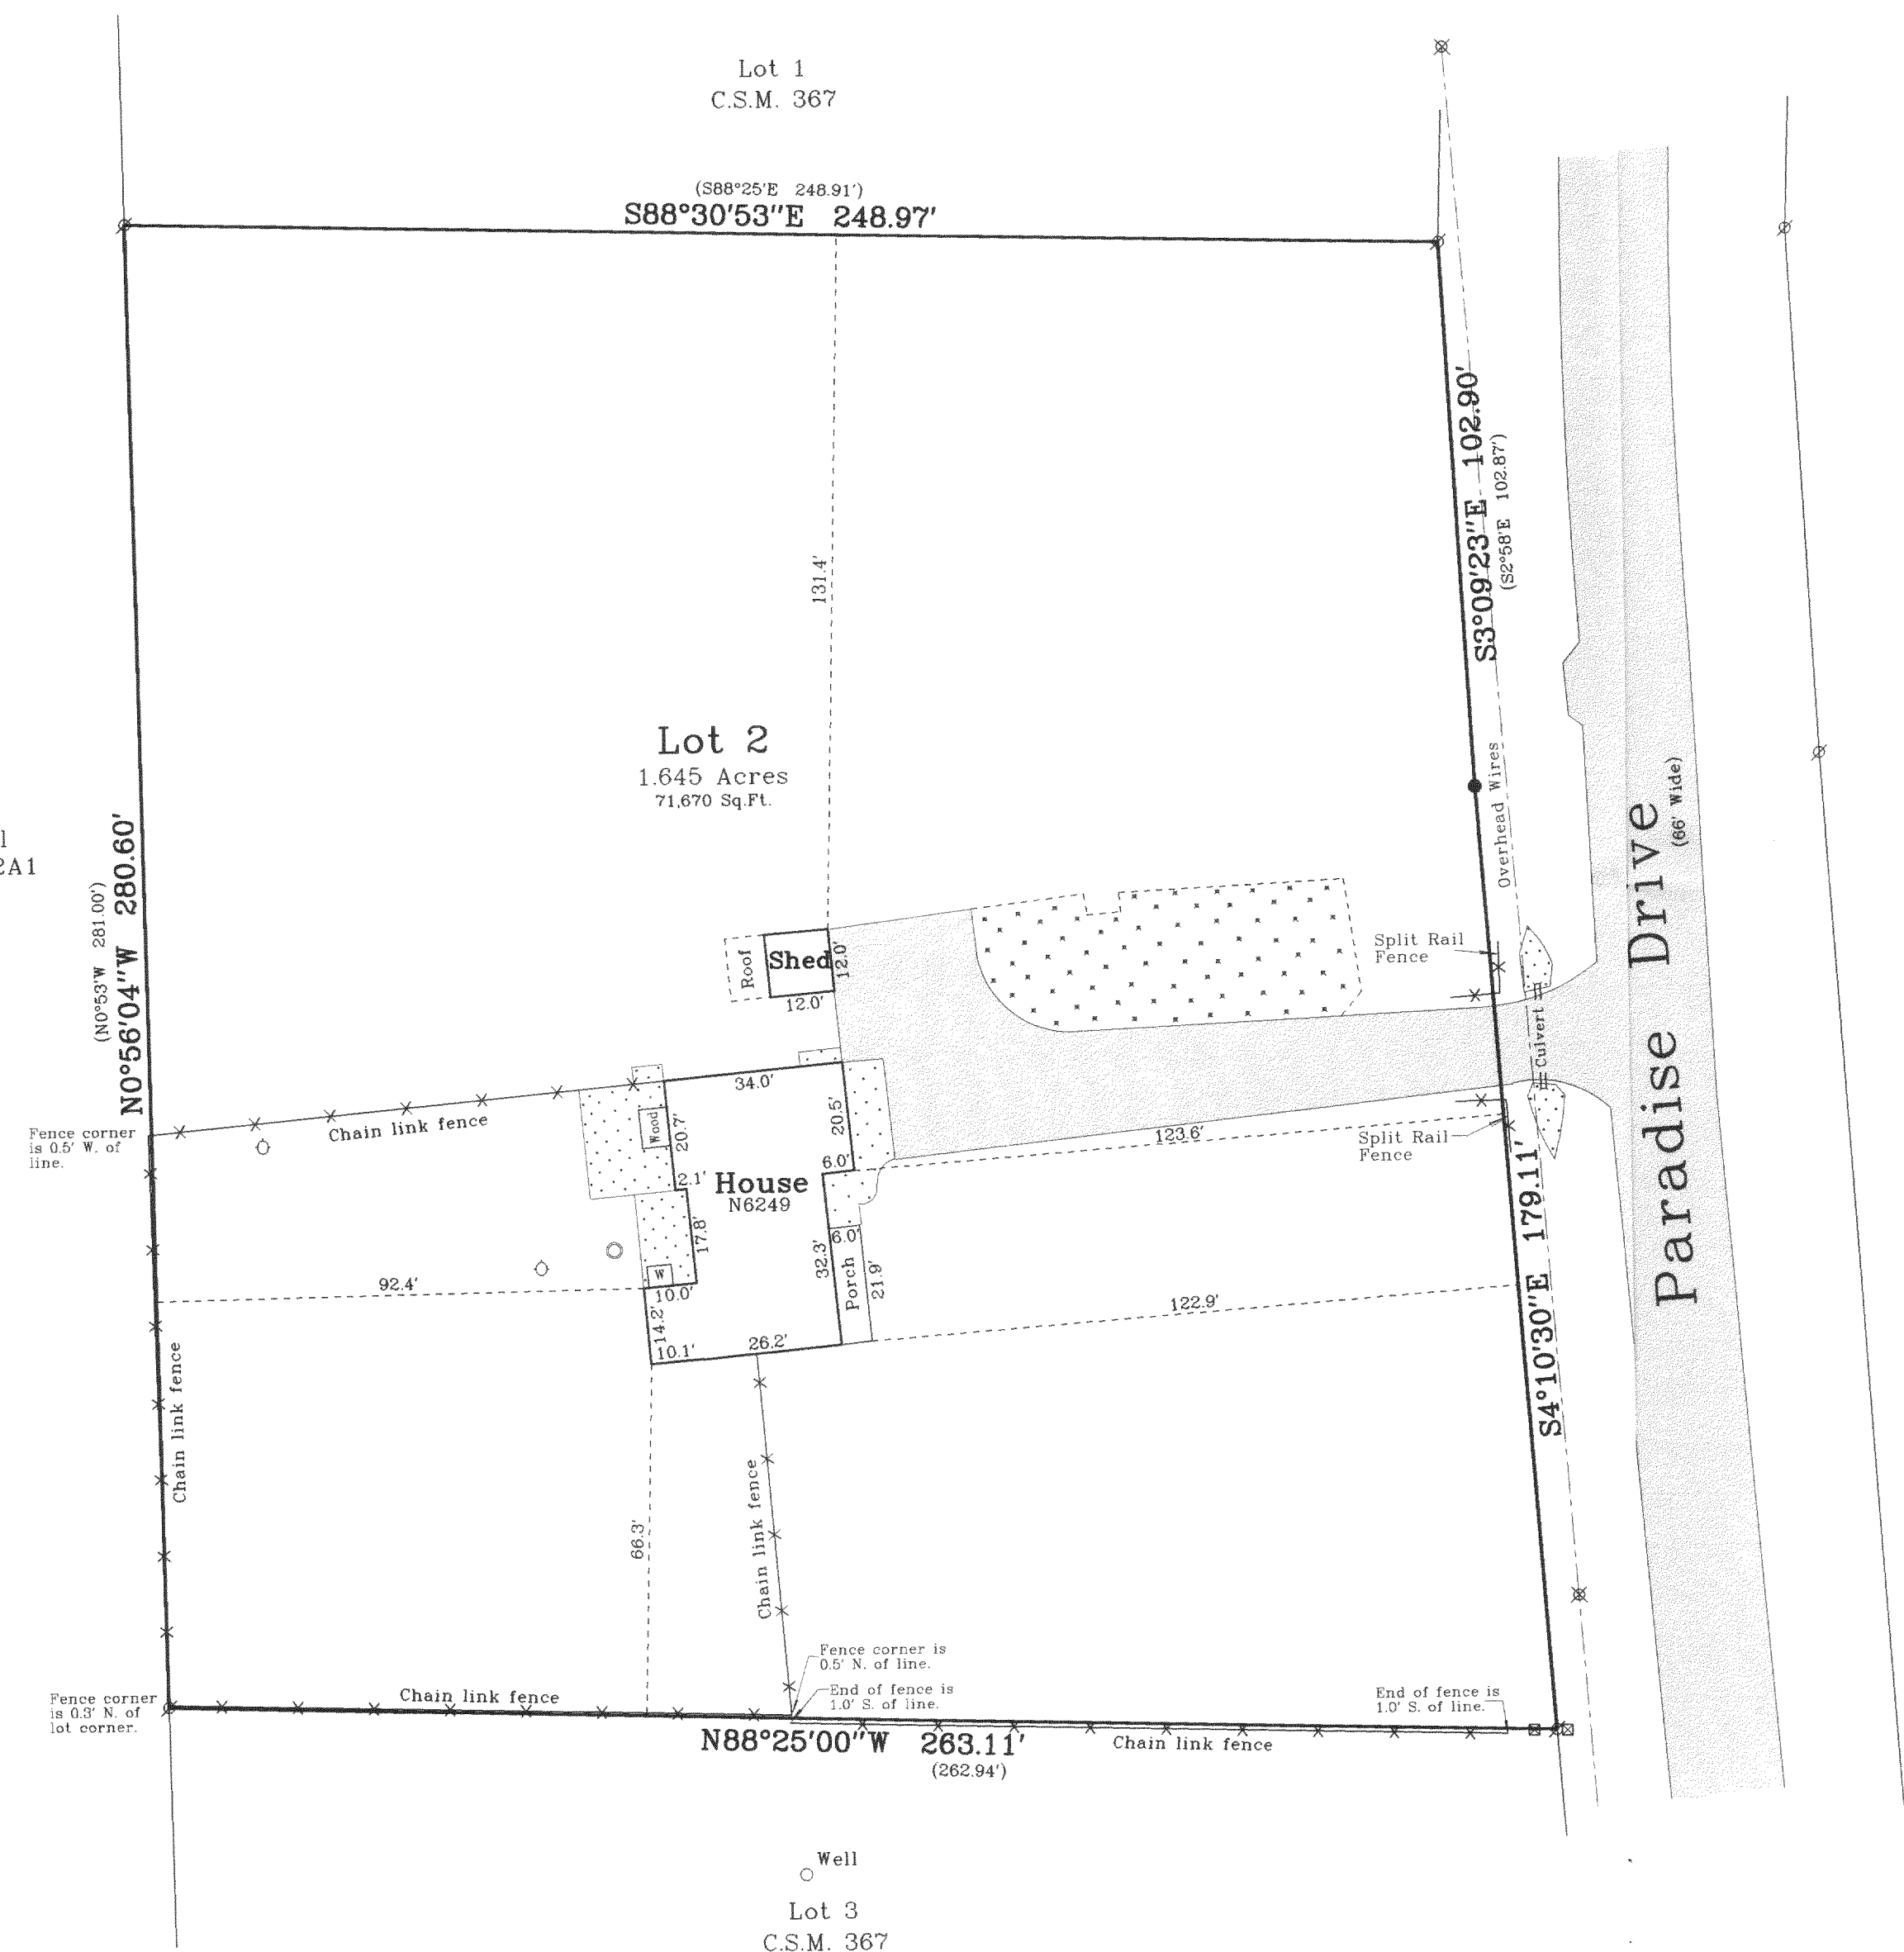

- Notes: 1) This survey plat is not certified unless signed and sealed in red ink.
- 2) This survey is subject to Wisconsin lien laws. This Plat of Survey is the notice of intent to file lien. Lien waiver required.

Copyright © 2002 by Jensen & Olson Land Surveying, LLC.

All rights reserved. No part of this survey plat may be reproduced or transmitted in any form by any means - graphic, electronic, or mechanical, including photocopying, tracing, or information storage and retrieval systems - without permission in writing from Douglas G. Olson, Jensen & Olson Land Surveying, LLC.

I hereby certify that I have surveyed the above described property and the map hereon is correct to the best of my professional knowledge and belief and shows the size and location of the property, its exterior boundaries, the location and dimensions of all visible structures thereon, boundary fences, apparent easements and roadways and visible encroachments, if any.

This survey is made for the exclusive use of the present owners of property, and also those who purchase, mortgage or guarantee title thereto, within one year from the date hereof.

Douglas G. Olson  
Wisconsin Registered Land Surveyor - 2093