



SCALE: 1" = 80'

GRAPHIC SCALE

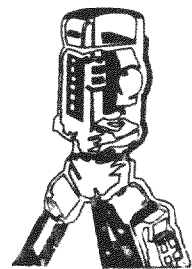


DETAIL
SCALE: 1" = 30'

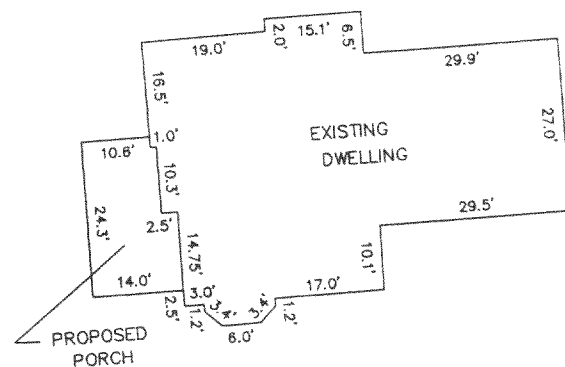

B.W. SURVEYING, INC.

LAND SURVEYS
MAPPING AND PLANNING
412 N. PINE STREET
BURLINGTON, WI 53105
(262)-767-0225

C.T.H.
N05°41'54"W
"DD"

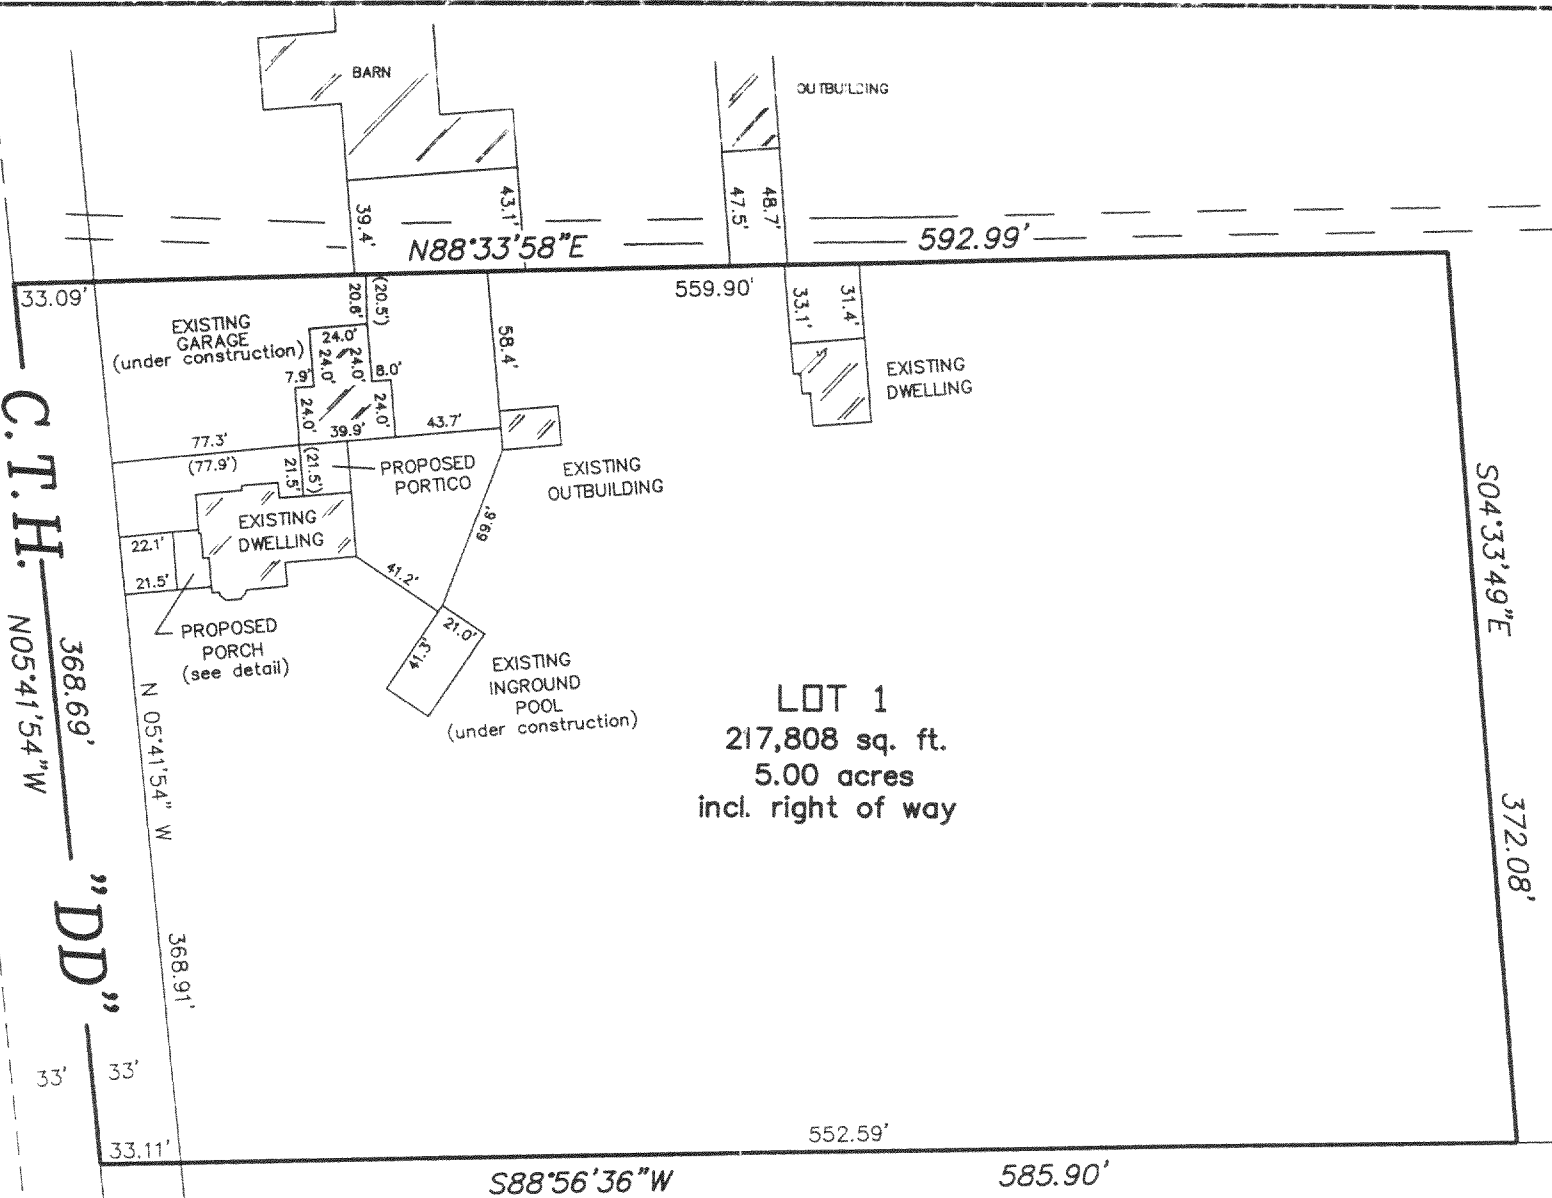

LOT 1
217,808 sq. ft.
5.00 acres
incl. right of way

**PLAT OF SURVEY
-OF-**


LOT 1, CERTIFIED SURVEY MAP NO. 2281, BEING PART OF THE SOUTHEAST 1/4 OF THE NORTHEAST 1/4 OF SECTION 12, TOWNSHIP 3 NORTH, RANGE 18 EAST OF THE FOURTH PRINCIPAL MERIDIAN, IN THE TOWNSHIP OF SPRING PRAIRIE, WALWORTH COUNTY, WISCONSIN.

PREPARED FOR: JEFF AND KRISTINE WAY
SITE PLAN LOCATION: N6746 HWY. "DD"

I HEREBY CERTIFY THAT THE EXISTING GARAGE AND IN GROUND POOL AS LOCATED ON THIS PLAT OF SURVEY IS LOCATED AS SHOWN THUS (DATED THIS 15TH DAY OF JANUARY, 2003)

Robert J. Wetzel
ROBERT J. WETZEL S-1778

EAST LINE NE 1/4 SECTION 12-3-18
N02°19'00"W
310.07'
EAST 1/4 CORNER SECTION 12-3-18
S88°56'36"W
159.55'

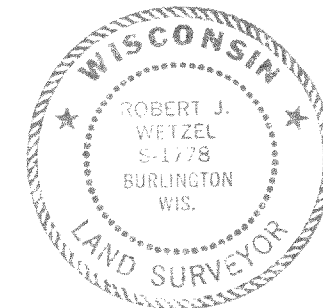

THIS IS NOT AN ORIGINAL PRINT
UNLESS THIS SEAL IS RED.

Robert J. Wetzel
ROBERT J. WETZEL S-1778

SEPTEMBER 5, 2002
DATE

5563
JOB NUMBER

0A2281-1

318-818