


PLAT OF SURVEY -OF-

LOT 1 OF WALWORTH COUNTY CERTIFIED SURVEY MAP NO. 3113, BEING PART OF THE SOUTHWEST 1/4 AND SOUTHEAST 1/4 OF THE NORTHWEST 1/4 AND PART OF THE NORTHWEST 1/4, NORTHEAST 1/4 AND SOUTHWEST 1/4 OF THE SOUTHWEST 1/4 OF SECTION 14, TOWNSHIP 3 NORTH, RANGE 18 EAST OF THE FOURTH PRINCIPAL MERIDIAN, IN THE TOWNSHIP OF SPRING PRAIRIE, WALWORTH COUNTY, WISCONSIN.

SURVEY FOR: DALE & JENNIFER DEGROOT
SURVEY LOCATION: N6240 PARADISE DRIVE

DETAIL

SCALE: 1" = 30'

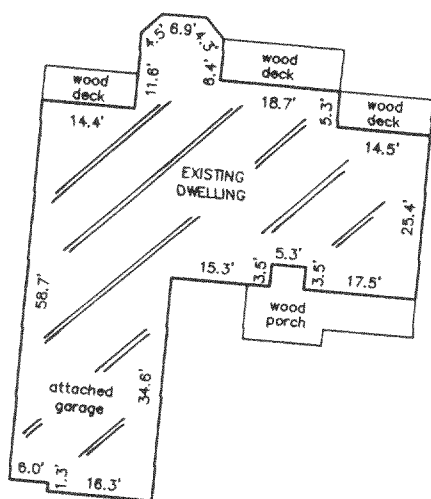


LEGEND

- FOUND IRON PIPE
- SET IRON PIPE

LINE	DIRECTION	DISTANCE
A	N01°43'30"E	74.10'
B	N00°34'00"W	100.00'
C	N05°29'00"W	55.93'
D	N17°51'00"W	5.76'
E	S05°29'00"E	59.73'
F	S00°34'00"E	102.08'
G	S01°43'30"W	69.26'



"I hereby certify that I have surveyed the above described property and that the above map is a correct representation thereof and shows the size and location of the property, its exterior boundaries, the location of all visible structures and dimensions of all principal buildings thereon, boundary fences, apparent easements, roadways and encroachments, if any."

"This survey is made for the use of the present owners of the property, and those who purchase, mortgage, or guarantee the title thereto within one year from date hereof."

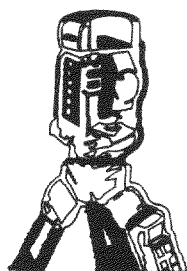

B.W. SURVEYING, INC.

LAND SURVEYS
MAPPING AND PLANNING
412 N. PINE STREET
BURLINGTON, WI 53105
(262)-767-0225

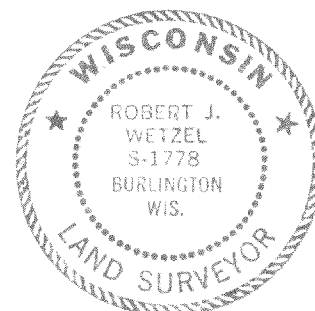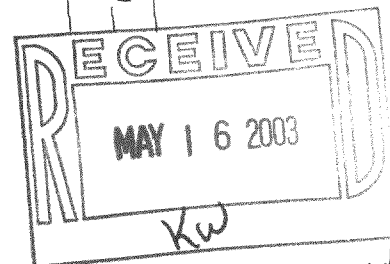


THIS IS NOT AN ORIGINAL PRINT
UNLESS THIS SEAL IS RED.

Robert J. Wetzel
ROBERT J. WETZEL S-1778
REVISED: 04/04/03

11/15/00
DATE

4705
JOB NUMBER

REVISED: MAY 2, 2003

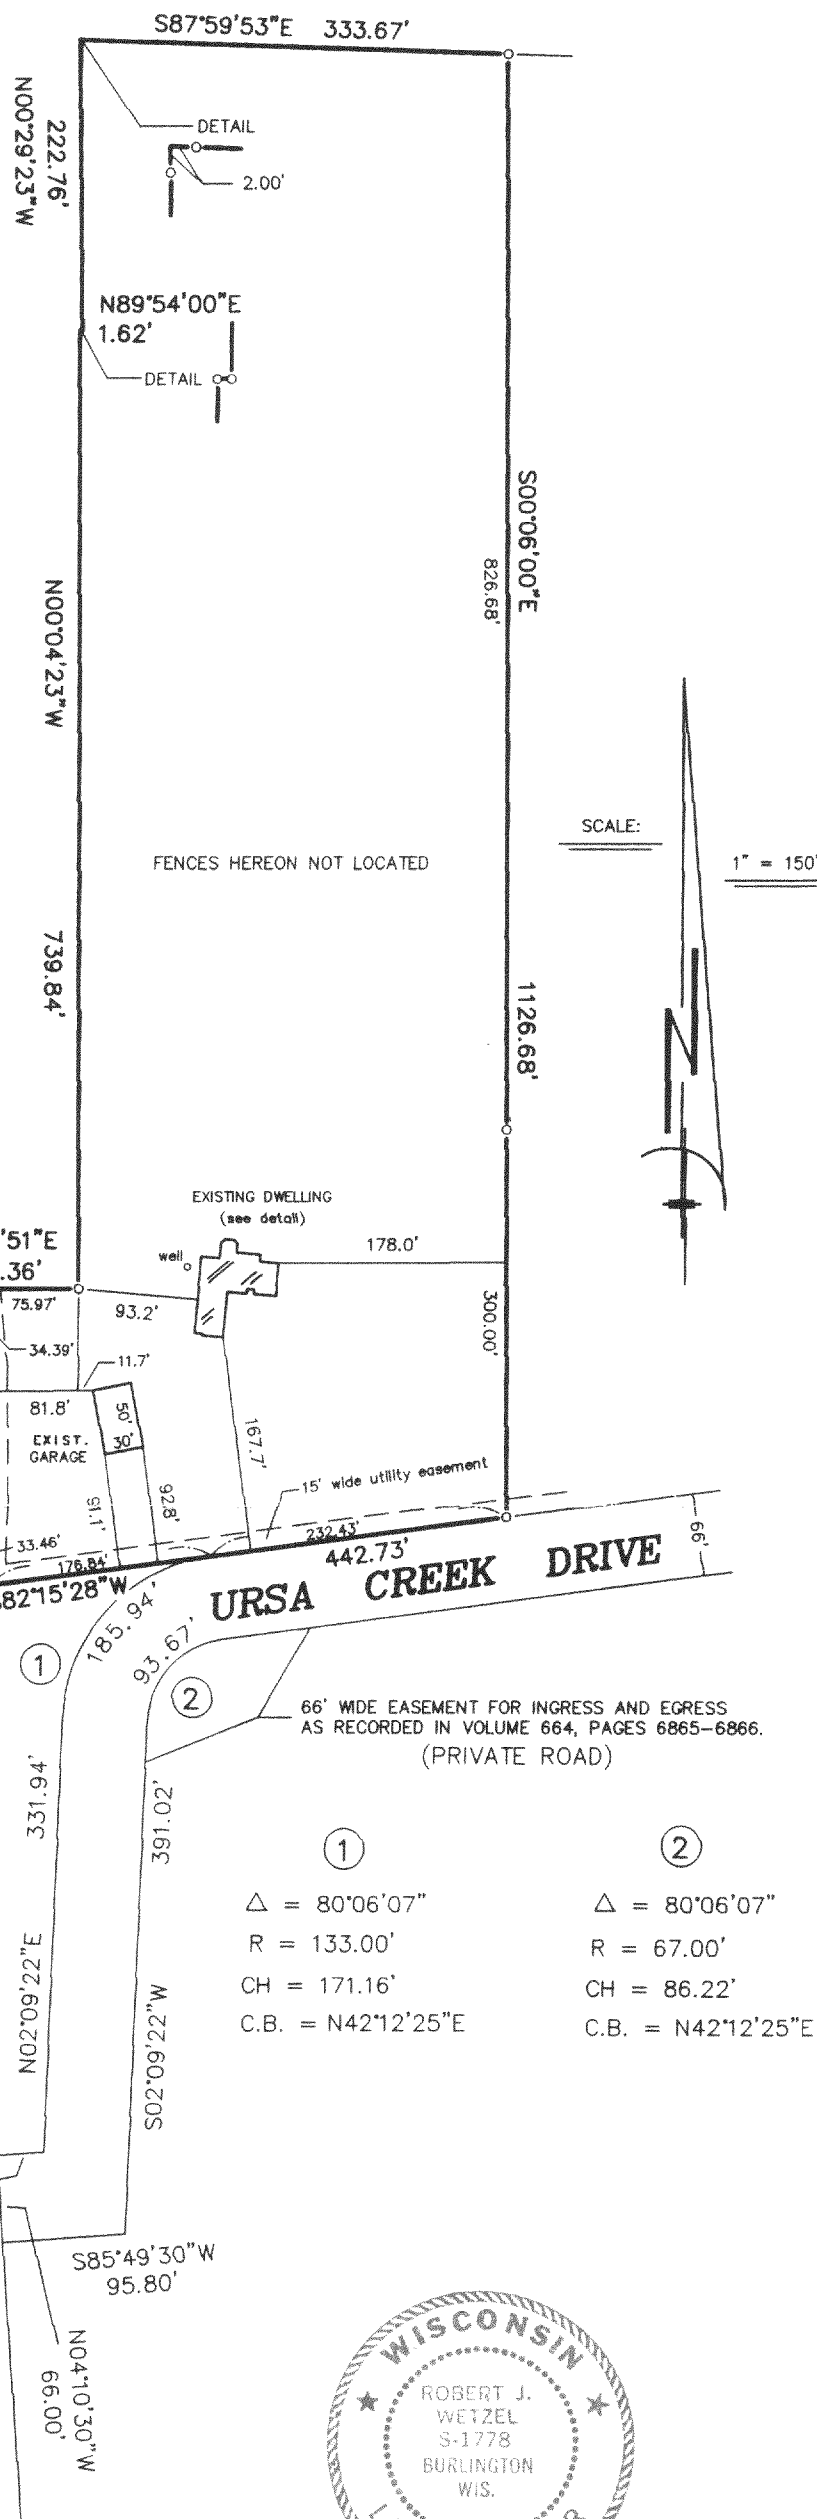

0A3113-1

318-831