
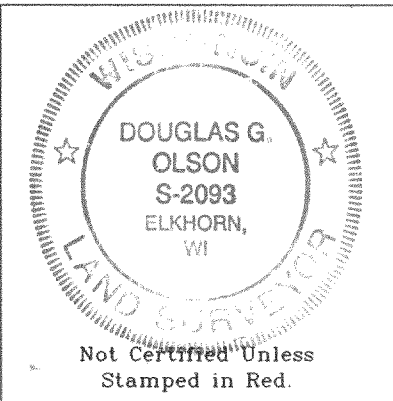


Plat of Survey

of
Lot 1 of Certified Survey Map No. 3459,
recorded in Vol. 20 of Certified Survey Maps of Walworth County on
Page 87 and located in the Southeast 1/4 of the Northwest 1/4 of
Section 1, Town 3 North, Range 18 East, Town of Spring Prairie,
Walworth County, Wisconsin.

Surveyed for: Lakes Area Builders, Inc.
340 Stohr Avenue
Twin Lakes, Wisconsin. 53181

Tax Parcel
OSP 100003

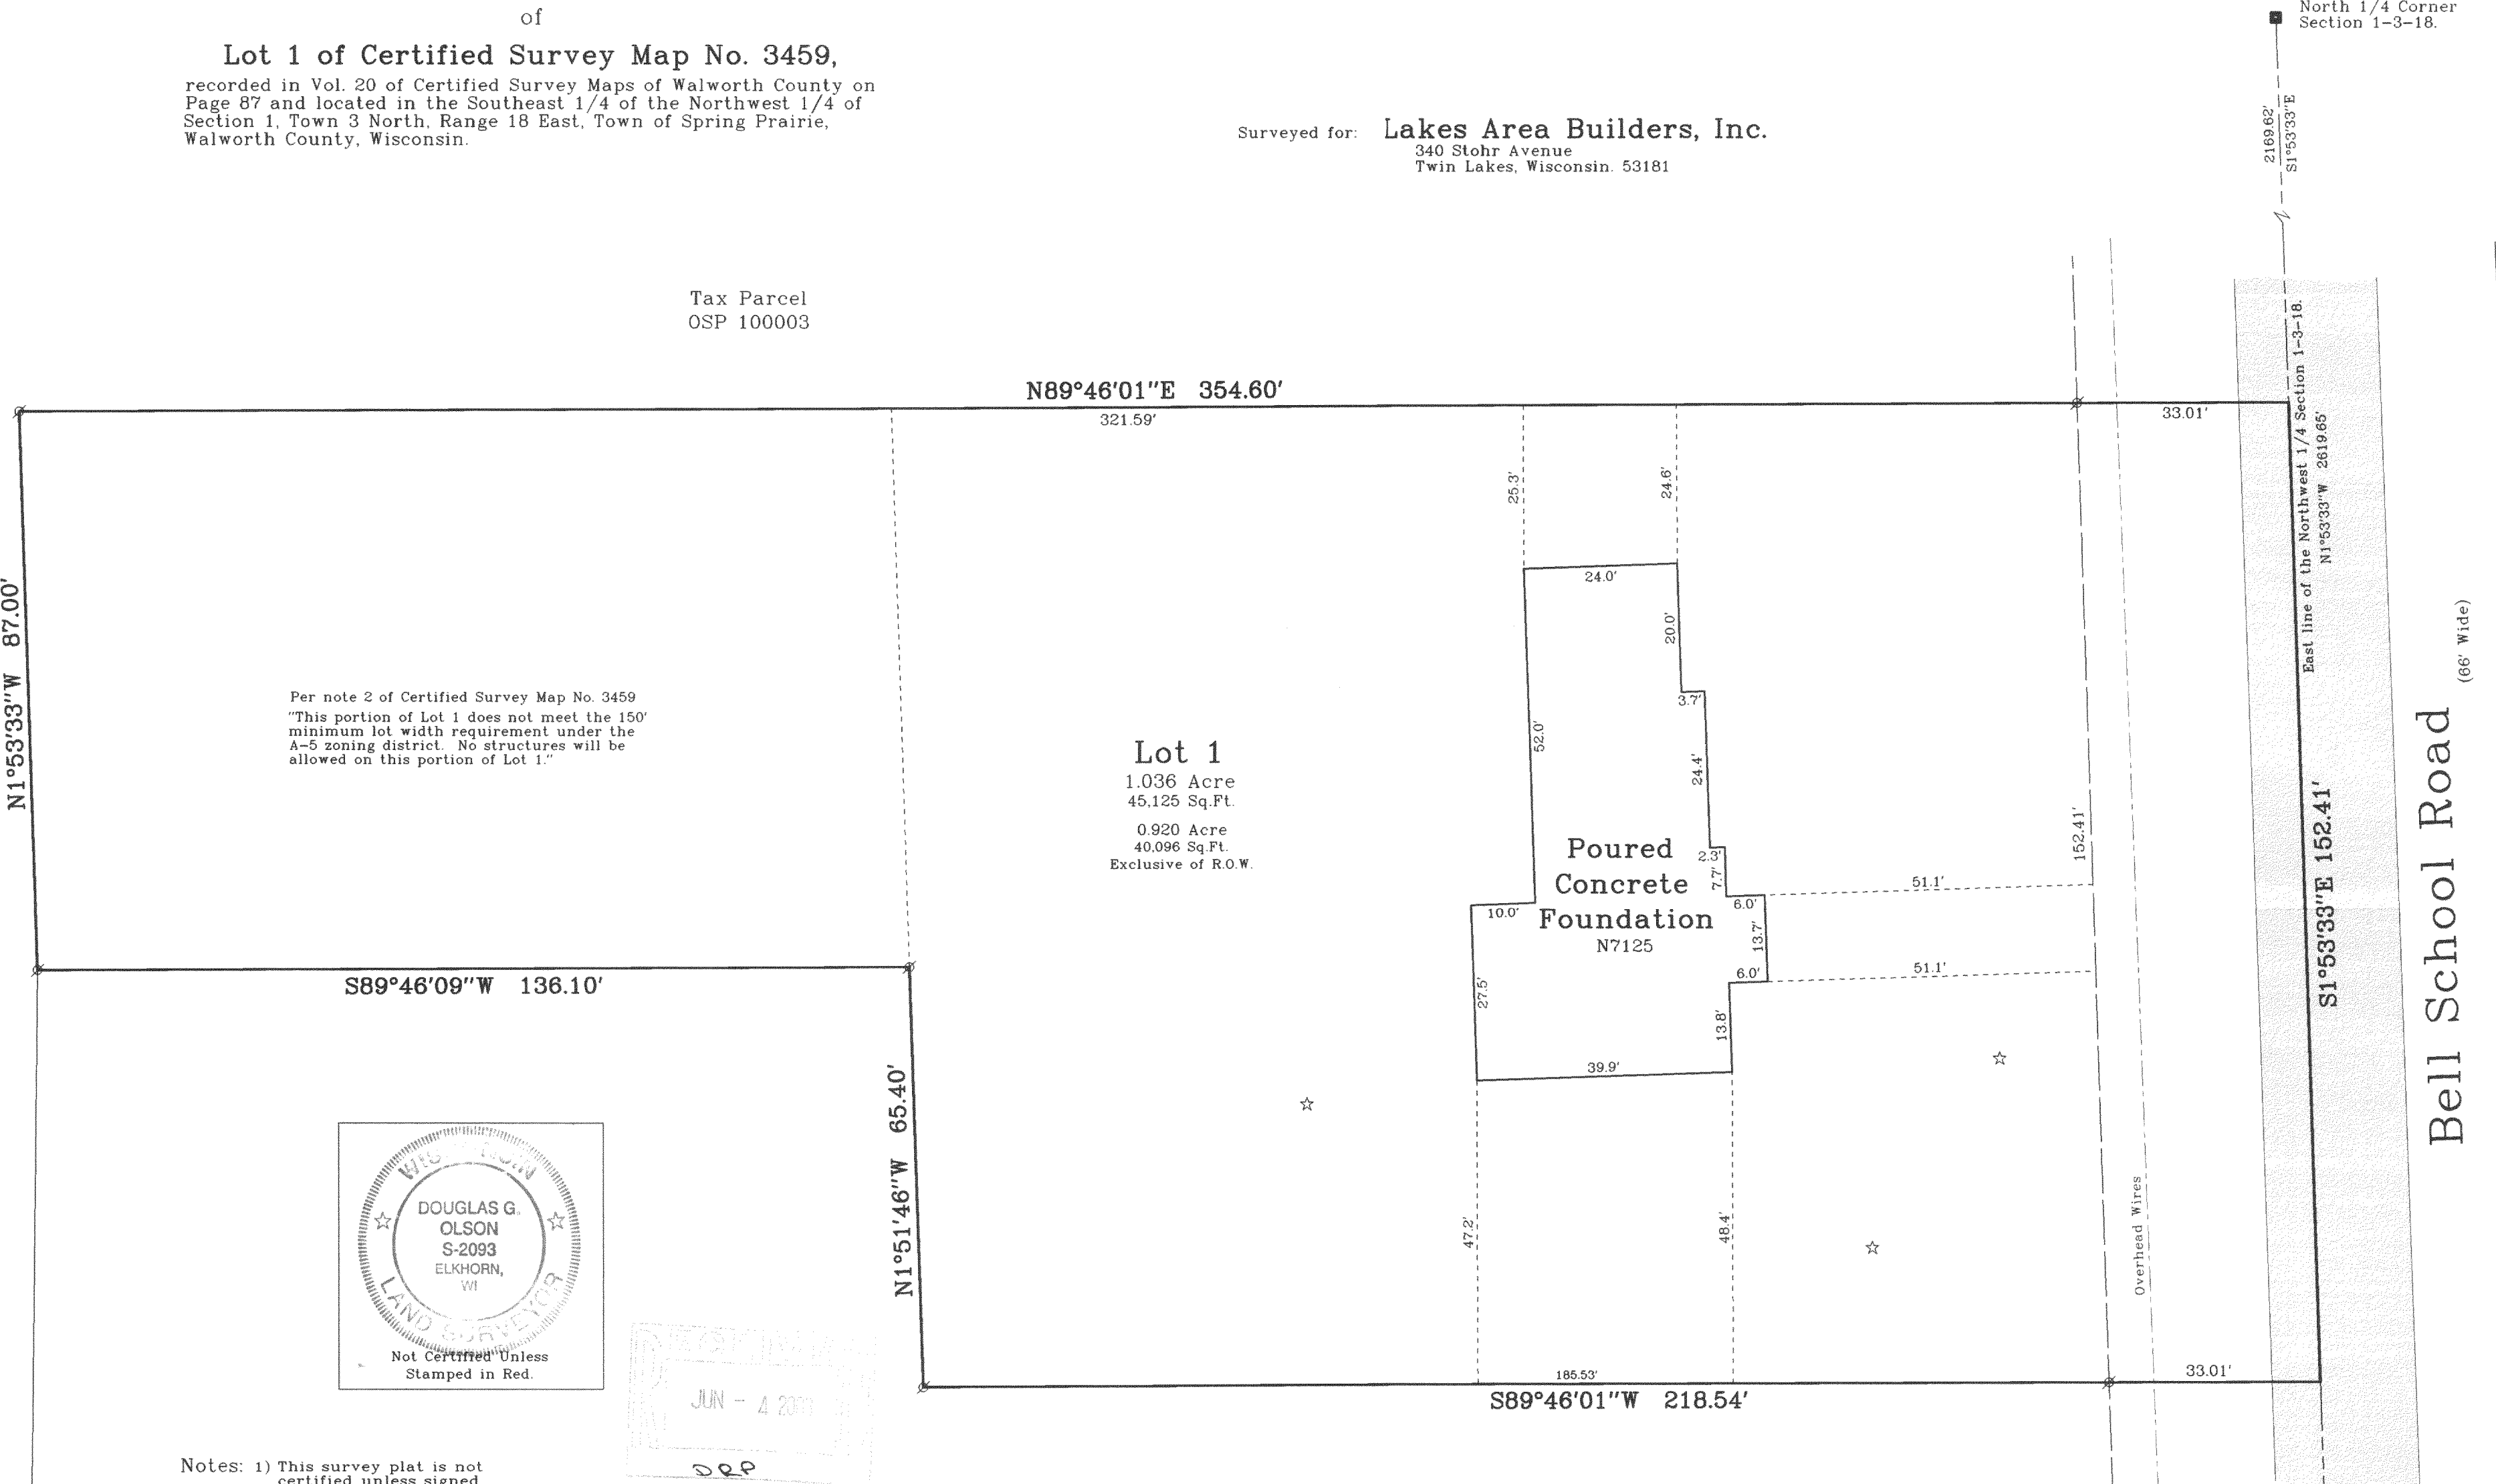

Notes: 1) This survey plat is not certified unless signed and sealed in red ink.
2) This survey is subject to Wisconsin lien laws. This Plat of Survey is the notice of intent to file lien. Lien waiver required.

Copyright c 2002 by Jensen & Olson Land Surveying, LLC.

All rights reserved. No part of this survey plat may be reproduced or transmitted in any form by any means - graphic, electronic, or mechanical, including photocopying, tracing, or information storage and retrieval systems - without permission in writing from Douglas G. Olson, Jensen & Olson Land Surveying, LLC.

I, Douglas G. Olson, Wisconsin Registered Land Surveyor, do hereby certify that this survey was performed by me or under my direction in full compliance with the owner's/agent's instructions and Chapter A-E 7 of the Wisconsin Administrative Code "Minimum Standards for Property Surveys"; and that this map is an accurate representation thereof to the best of my knowledge and belief.

Douglas G. Olson
Wisconsin Registered Land Surveyor - 2093

Survey Date: July 2, 2002
Revisions: No. 1 - Set stakes
No. 2 - CSM plat info
No. 3 - Foundation

Scale in Feet
1" = 20'
0 10' 20' 40'

Jensen & Olson Land Surveying, LLC

45 South Wisconsin Street
Elkhorn, Wisconsin. 53121
Telephone (262) 723-3434
Facsimile (262) 723-8044

P.O. Box 322

Legend

Found County Section Corner
Found Iron Rod, 3/4" dia.
Recorded Information
Soil Surface
Asphalt Surface

Sheet 1 of 1 Sheets

Job Reference Number
2002.144

2002.144