


"RECERTIFICATION"

# Plat of Survey

Survey For: FIRST HORIZON CONSTRUCTION LENDING  
Location: W. 994 SKI HILL DRIVE


LOVRINE

Description: UNIT 15, PHASE TWO THE HIGHLANDS OF PARADISE VALLEY, located in the Northeast 1/4 of Section 15, Town 3 North, Range 18 East, Town of Spring Prairie, Walworth County, Wisconsin.

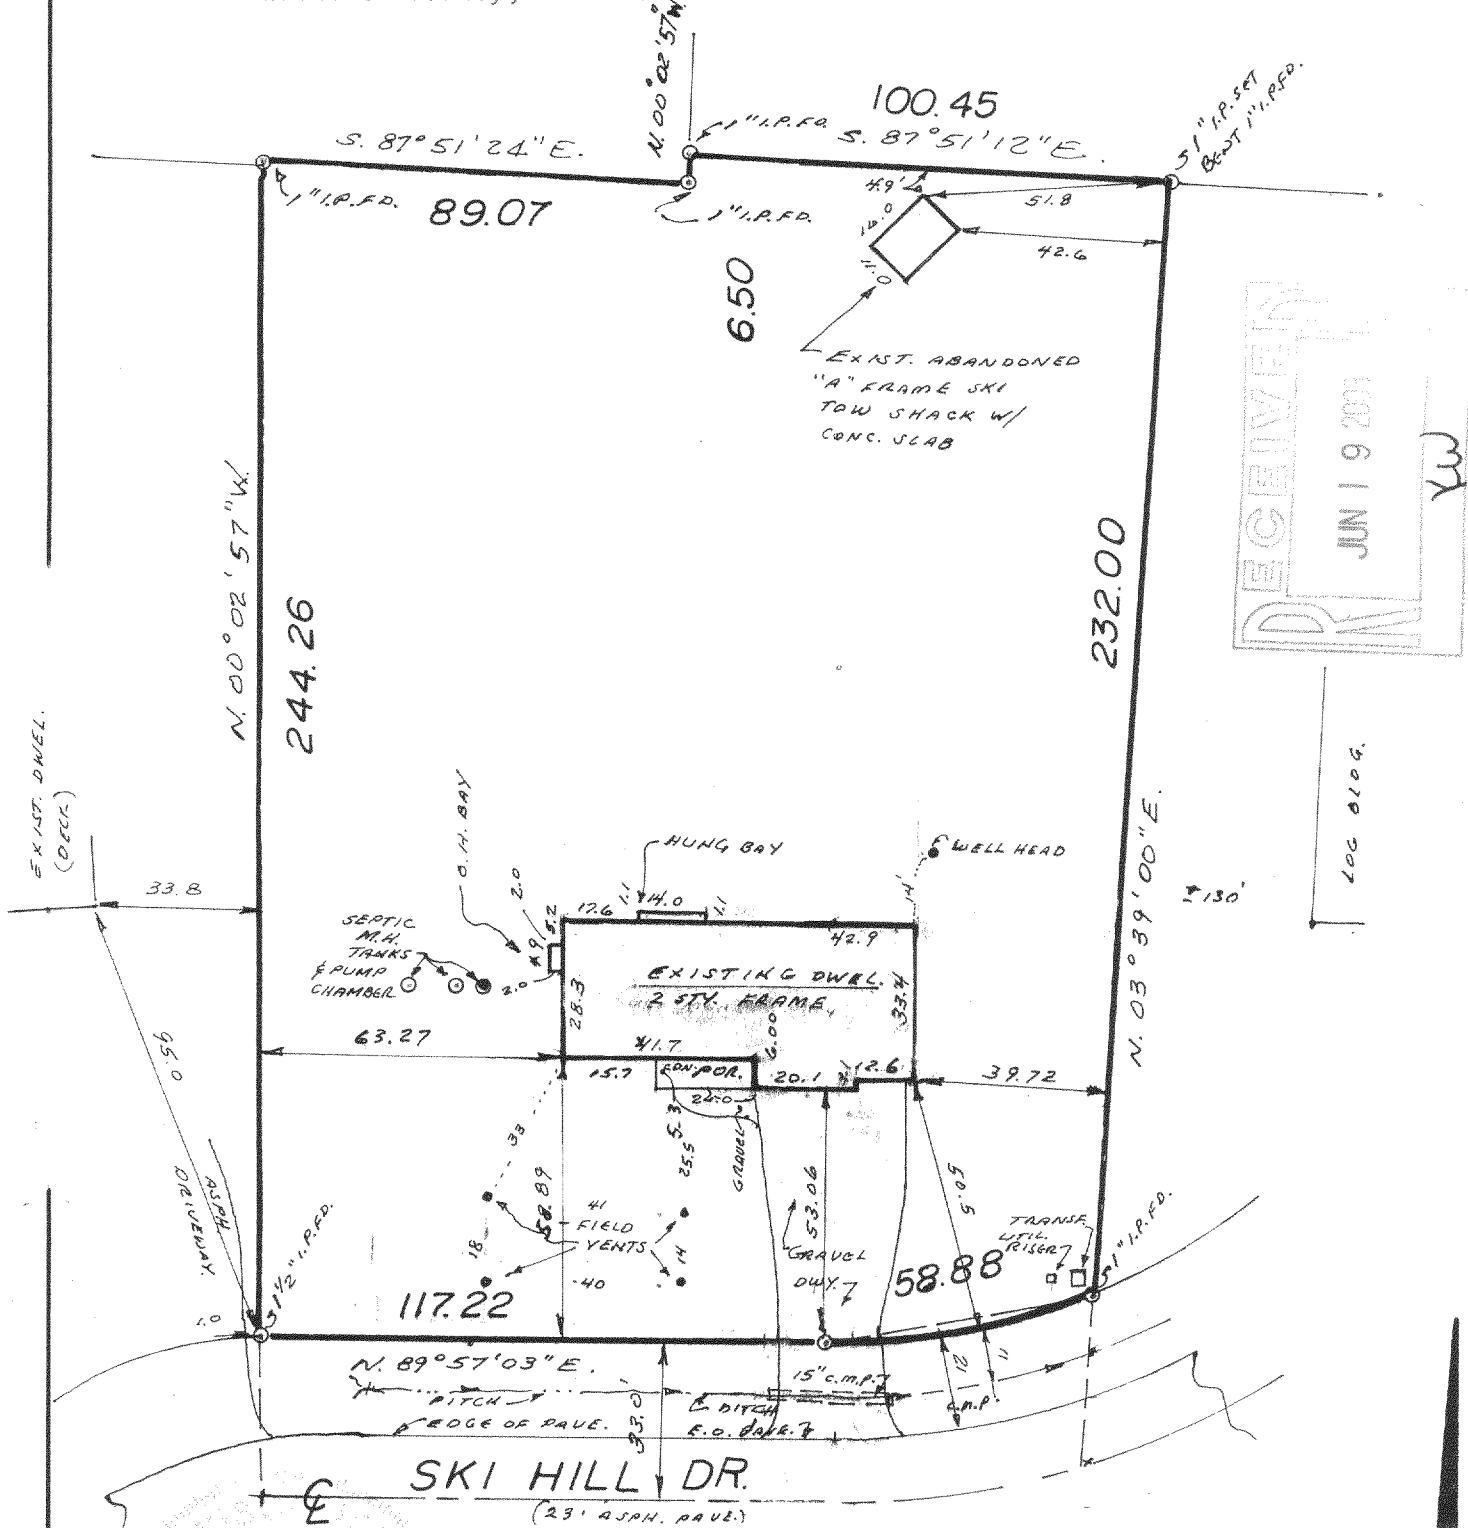

RECEIVED  
JUN 19 2003  
YW

SKI HILL DR.  
(23' ASPH. PAVE.)

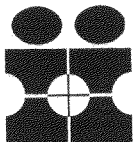

INTERLINE SURVEY  
SERVICES, INC.

10521 W. FOREST HOME AVE. STE. 201  
HALES CORNERS, WI 53130  
PHONE 425-2060

SURVEY CERTIFICATE

Scale: 1" = 40'

State of Wisconsin) ss  
Milwaukee County

We, Interline Survey Services, Inc., certify that we have surveyed the above described property and the above map is a true representation thereof, and shows the size and location of the property, its exterior boundaries, the location and dimensions of all visible structures thereon, fences, apparent easements and roadways and visible encroachments, if any.

This survey is made for the exclusive use of the present owners of the Property, and also those who purchase, mortgage, or guarantee the title thereto, within one (1) year from date hereof.

*Gary J. Smith*  
Wisconsin Registered Land Surveyor

Date: 5/19/03  
Job No.: 29398

N069272

042-15

318-845