

PLAT OF SURVEY

FOR: WOLTER BROS. BUILDERS


EBBOTT

LOCATION:

POTTER ROAD

DESCRIPTION:

LOT 2 OF WALWORTH COUNTY CERTIFIED SURVEY MAP NO. 1958, LOCATED IN PART OF THE N.E. 1/4 OF THE S.W. 1/4 & PART OF THE S.E. 1/4 OF THE S.W. 1/4 & PART OF THE S.W. 1/4 OF THE S.W. 1/4 & PART OF THE N.W. 1/4 OF THE S.W. 1/4, ALL IN SECTION 13, TOWNSHIP 3 NORTH, RANGE 18 EAST, OF THE 4TH R.M., IN THE TOWNSHIP OF SPRING PRAIRIE, WALWORTH COUNTY, WISCONSIN.

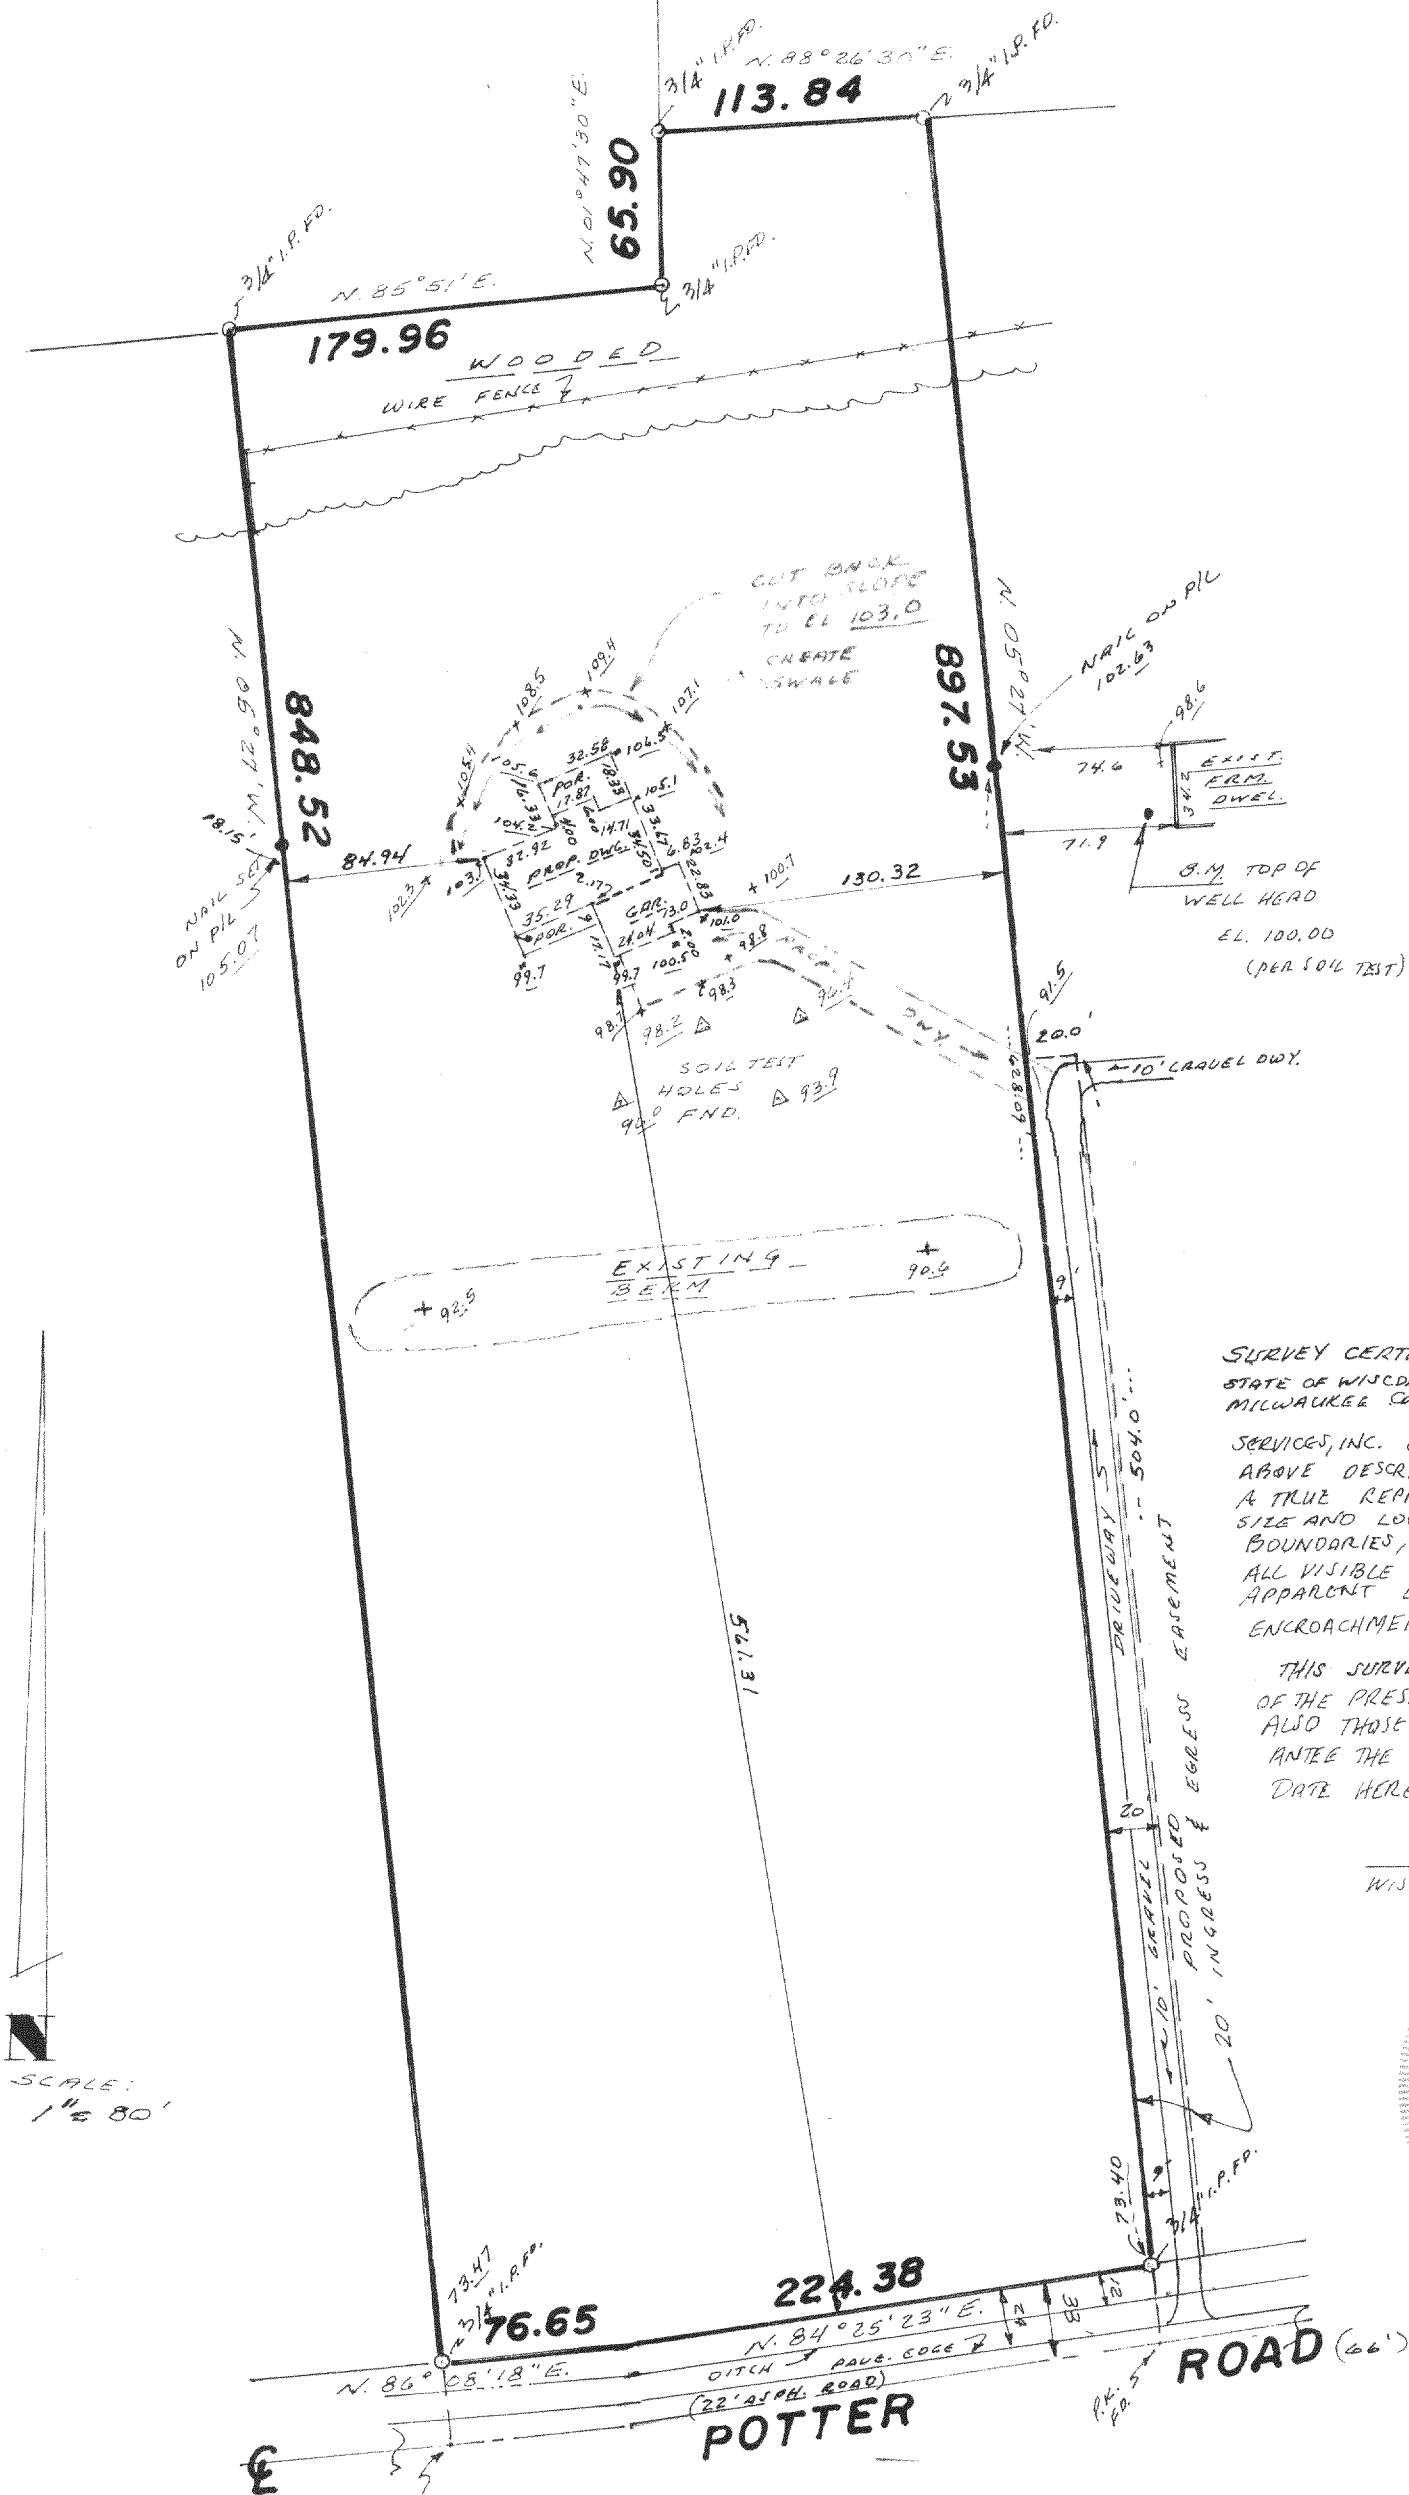

SURVEY CERTIFICATE

STATE OF WISCONSIN) SS
MILWAUKEE COUNTY)

WE, INTERLINE SURVEYING

SERVICES, INC. CERTIFY THAT WE HAVE SURVEYED THE ABOVE DESCRIBED PROPERTY AND THE ABOVE MAP IS A TRUE REPRESENTATION THEREOF, AND SHOWS THE SIZE AND LOCATION OF THE PROPERTY, ITS EXTERIOR BOUNDARIES, THE LOCATION AND DIMENSIONS OF ALL VISIBLE STRUCTURES THEREON, FENCES, APPARENT EASEMENTS AND ROADWAYS, AND VISIBLE ENCROACHMENTS, IF ANY.



THIS SURVEY IS MADE FOR THE EXCLUSIVE USE OF THE PRESENT OWNERS OF THE PROPERTY, AND ALSO THOSE WHO PURCHASE, MORTGAGE, OR GUARANTEE THE TITLE THEREON, WITHIN (1) ONE YEAR FROM DATE HEREOF.

Gary J. Smith
WISCONSIN REGISTERED LAND SURVEYOR



* PROPOSED DWELLING IS STATED 10' LARGE

* PROPOSED FINISHED YARD GRADE = 104.2

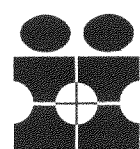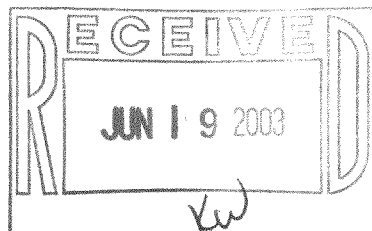

INTERLINE SURVEY SERVICES, INC.

10521 W. FOREST HOME AVE. STE. 201
HALES CORNERS, WI 53130
PHONE 425-2060

JOB NO. 29074
DATED 10-1-02

0A1958-2

318-847