
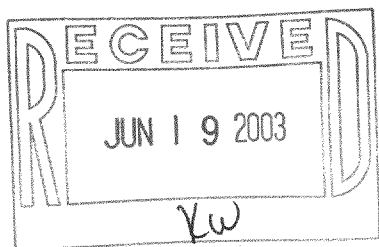


"RECERTIFICATION"
PLAT OF SURVEY

SURVEY FOR: WOLTER BROS. BUILDERS
LOCATION: C.T.H. "D"

RINDFLEISCH

DESCRIPTION: LOT 1 CERTIFIED SURVEY MAP NO. 2962, part of the Northeast 1/4 and the Southeast 1/4 of the Southeast 1/4 of Section 3, Town 3 North, Range 18 East of the Fourth Principal Meridian, Town of Spring Prairie, Walworth County, Wisconsin.

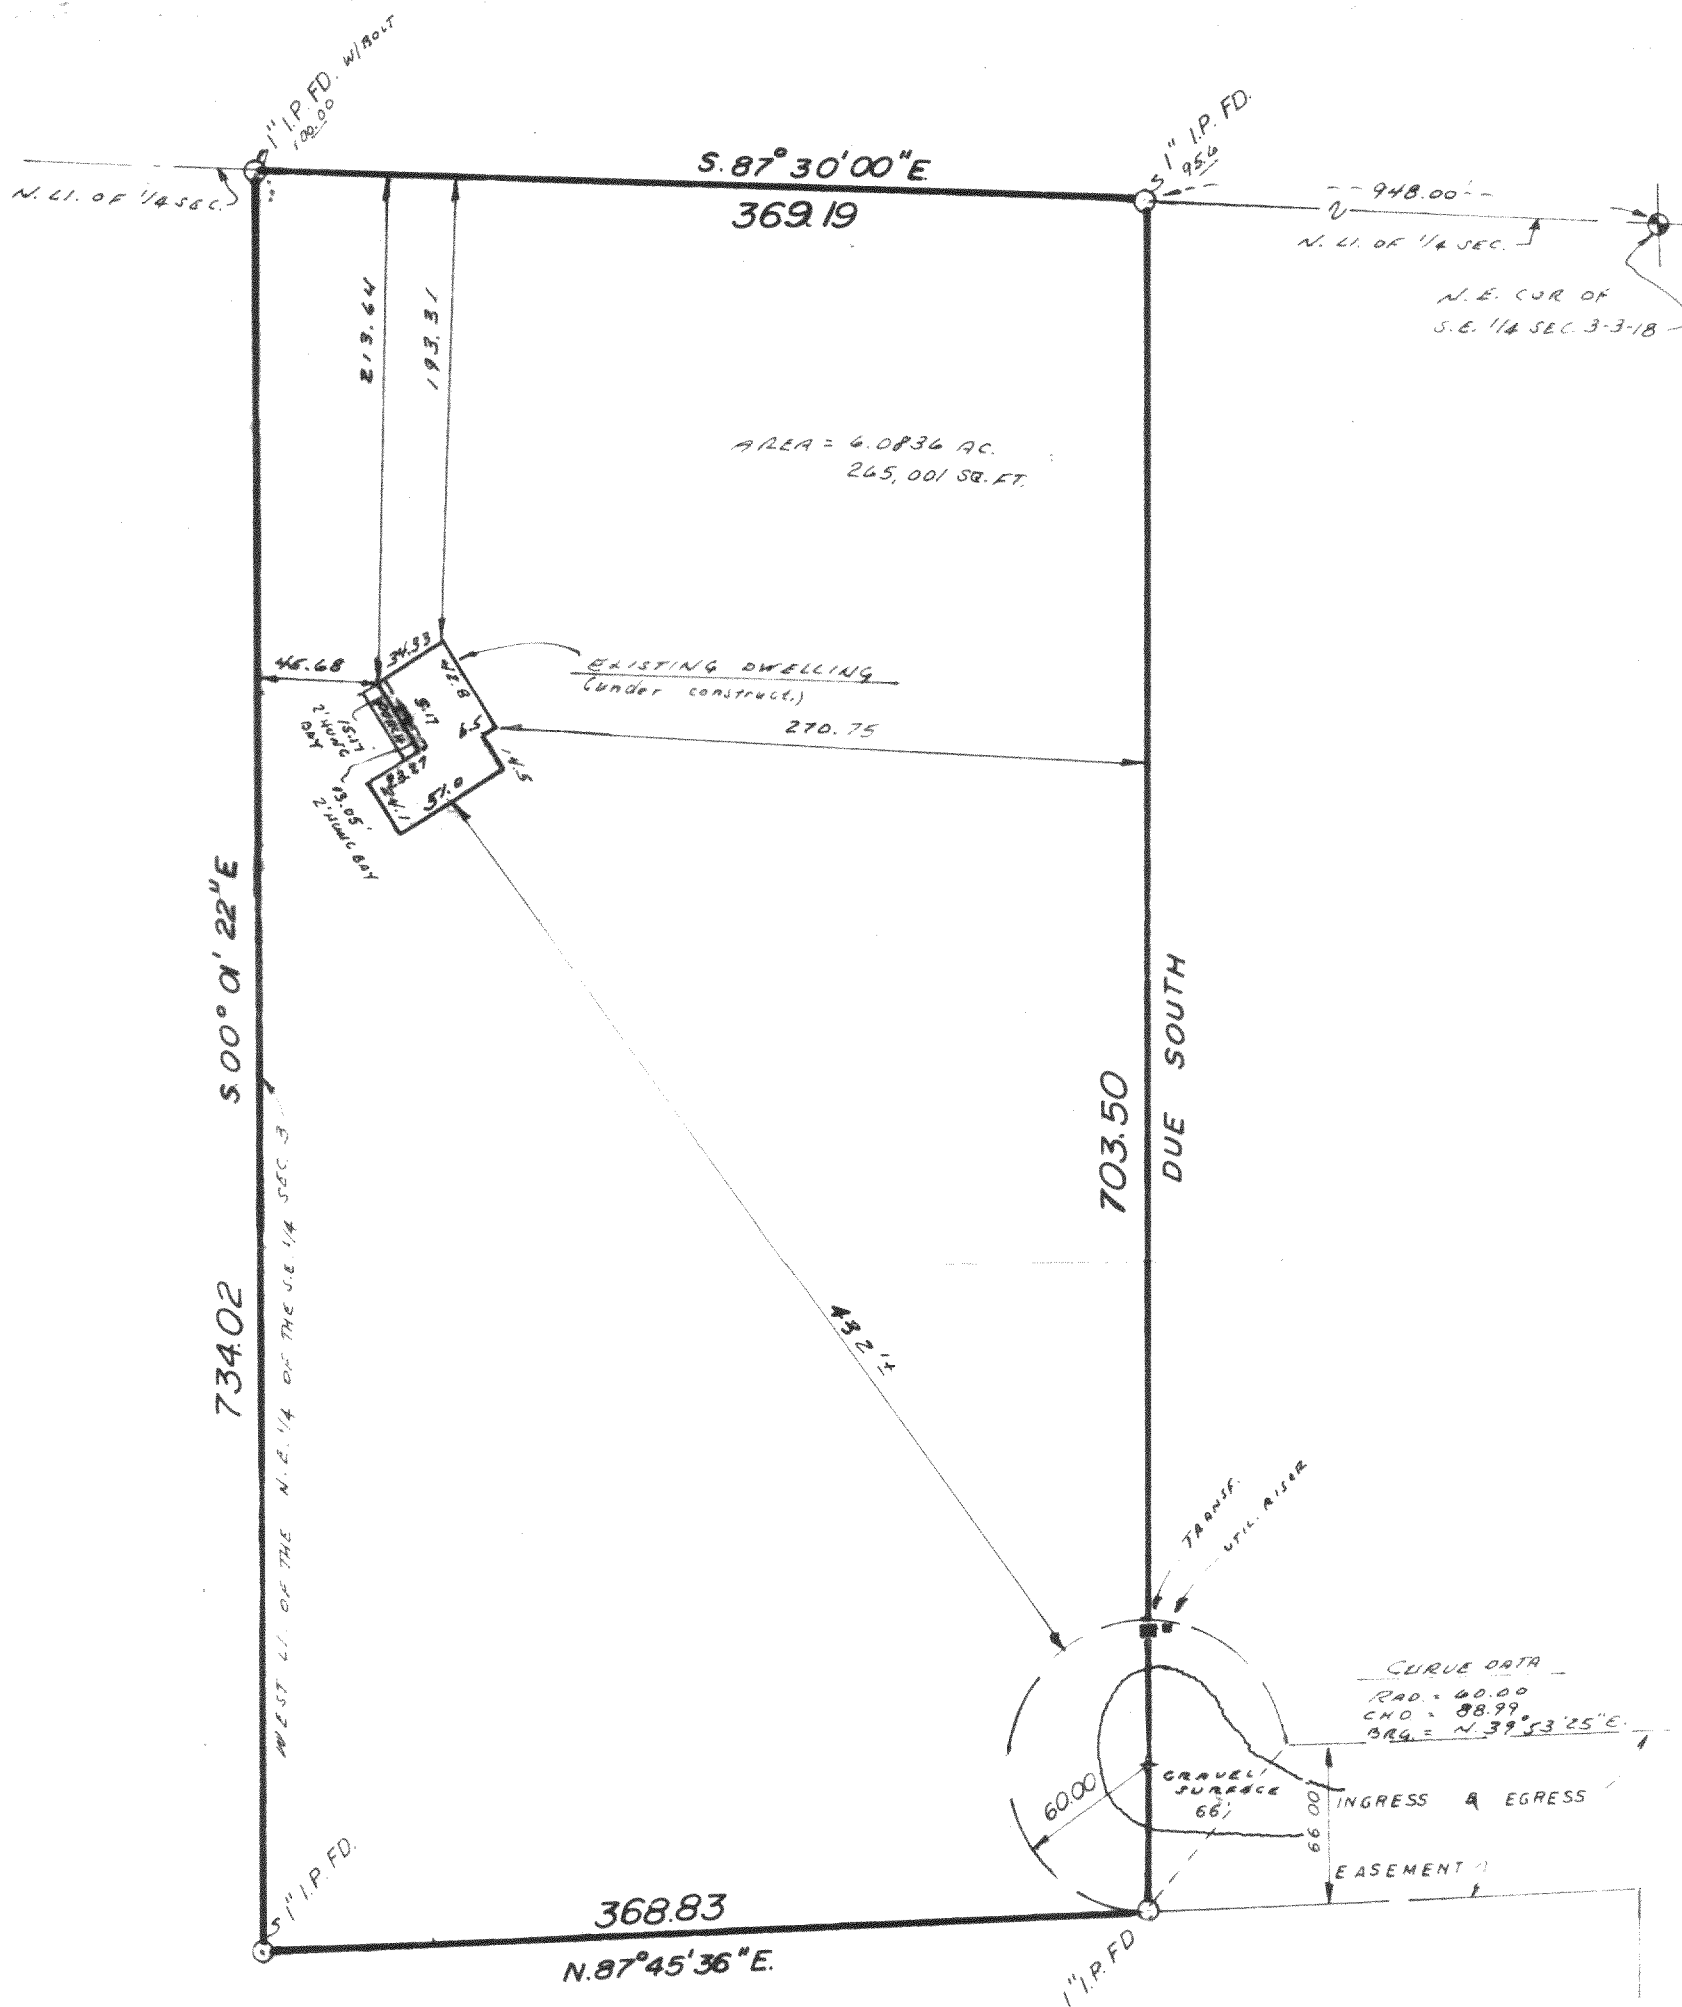


SURVEY CERTIFICATE

State of Wisconsin)
Milwaukee County)ss

We, Interline Survey Services, Inc., certify that we have surveyed the above described property and the above map is a true representation thereof, and shows the size and location of the property, its exterior boundaries, the location and dimensions of all visible structures thereon, fences, apparent easements and roadways and visible encroachments, if any.

This survey is made for the exclusive use of the present owners of the Property, and also those who purchase, mortgage, or guarantee the title thereto, within one (1) year from date hereof.

Bary J. Smith
Wisconsin Registered Land Surveyor

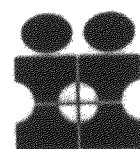

INTERLINE SURVEY SERVICES, INC.
11221 W. FOREST HOME AVE
FRANKLIN, WISCONSIN 53132
PHONE 428-2060

JOB NO. 88931
DATED: 7/8/02

318-848

0A2962-1