
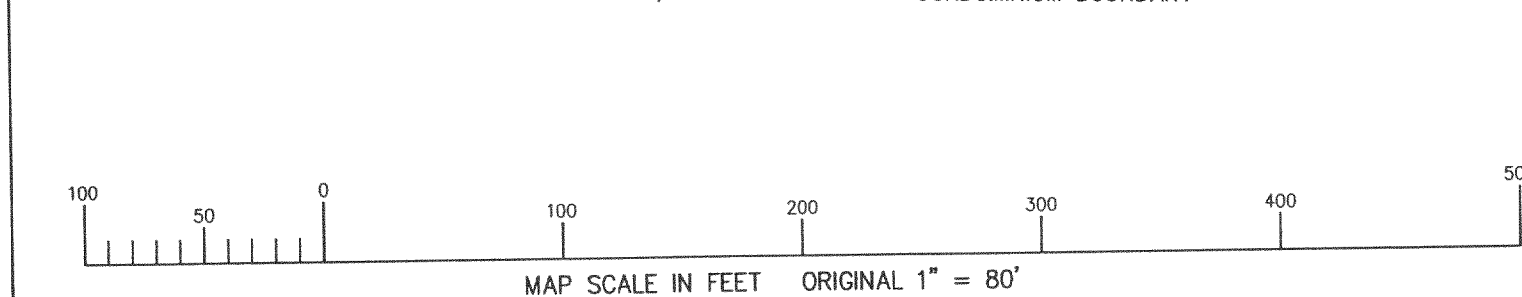


AS BUILT GARAGE LOCATION

SUGAR CREEK WOODS ADDENDUM NO. 5

TO REDEFINE THE LIMITED COMMON ELEMENT AREA WITHIN
UNIT 5 OF SUGAR CREEK WOODS, A CONDOMINIUM

A CONDOMINIUM LOCATED IN THE NW 1/4, SW 1/4, AND THE SE 1/4 OF
SECTION 7, TOWN 3 NORTH, RANGE 18 EAST, WALWORTH COUNTY, WISCONSIN

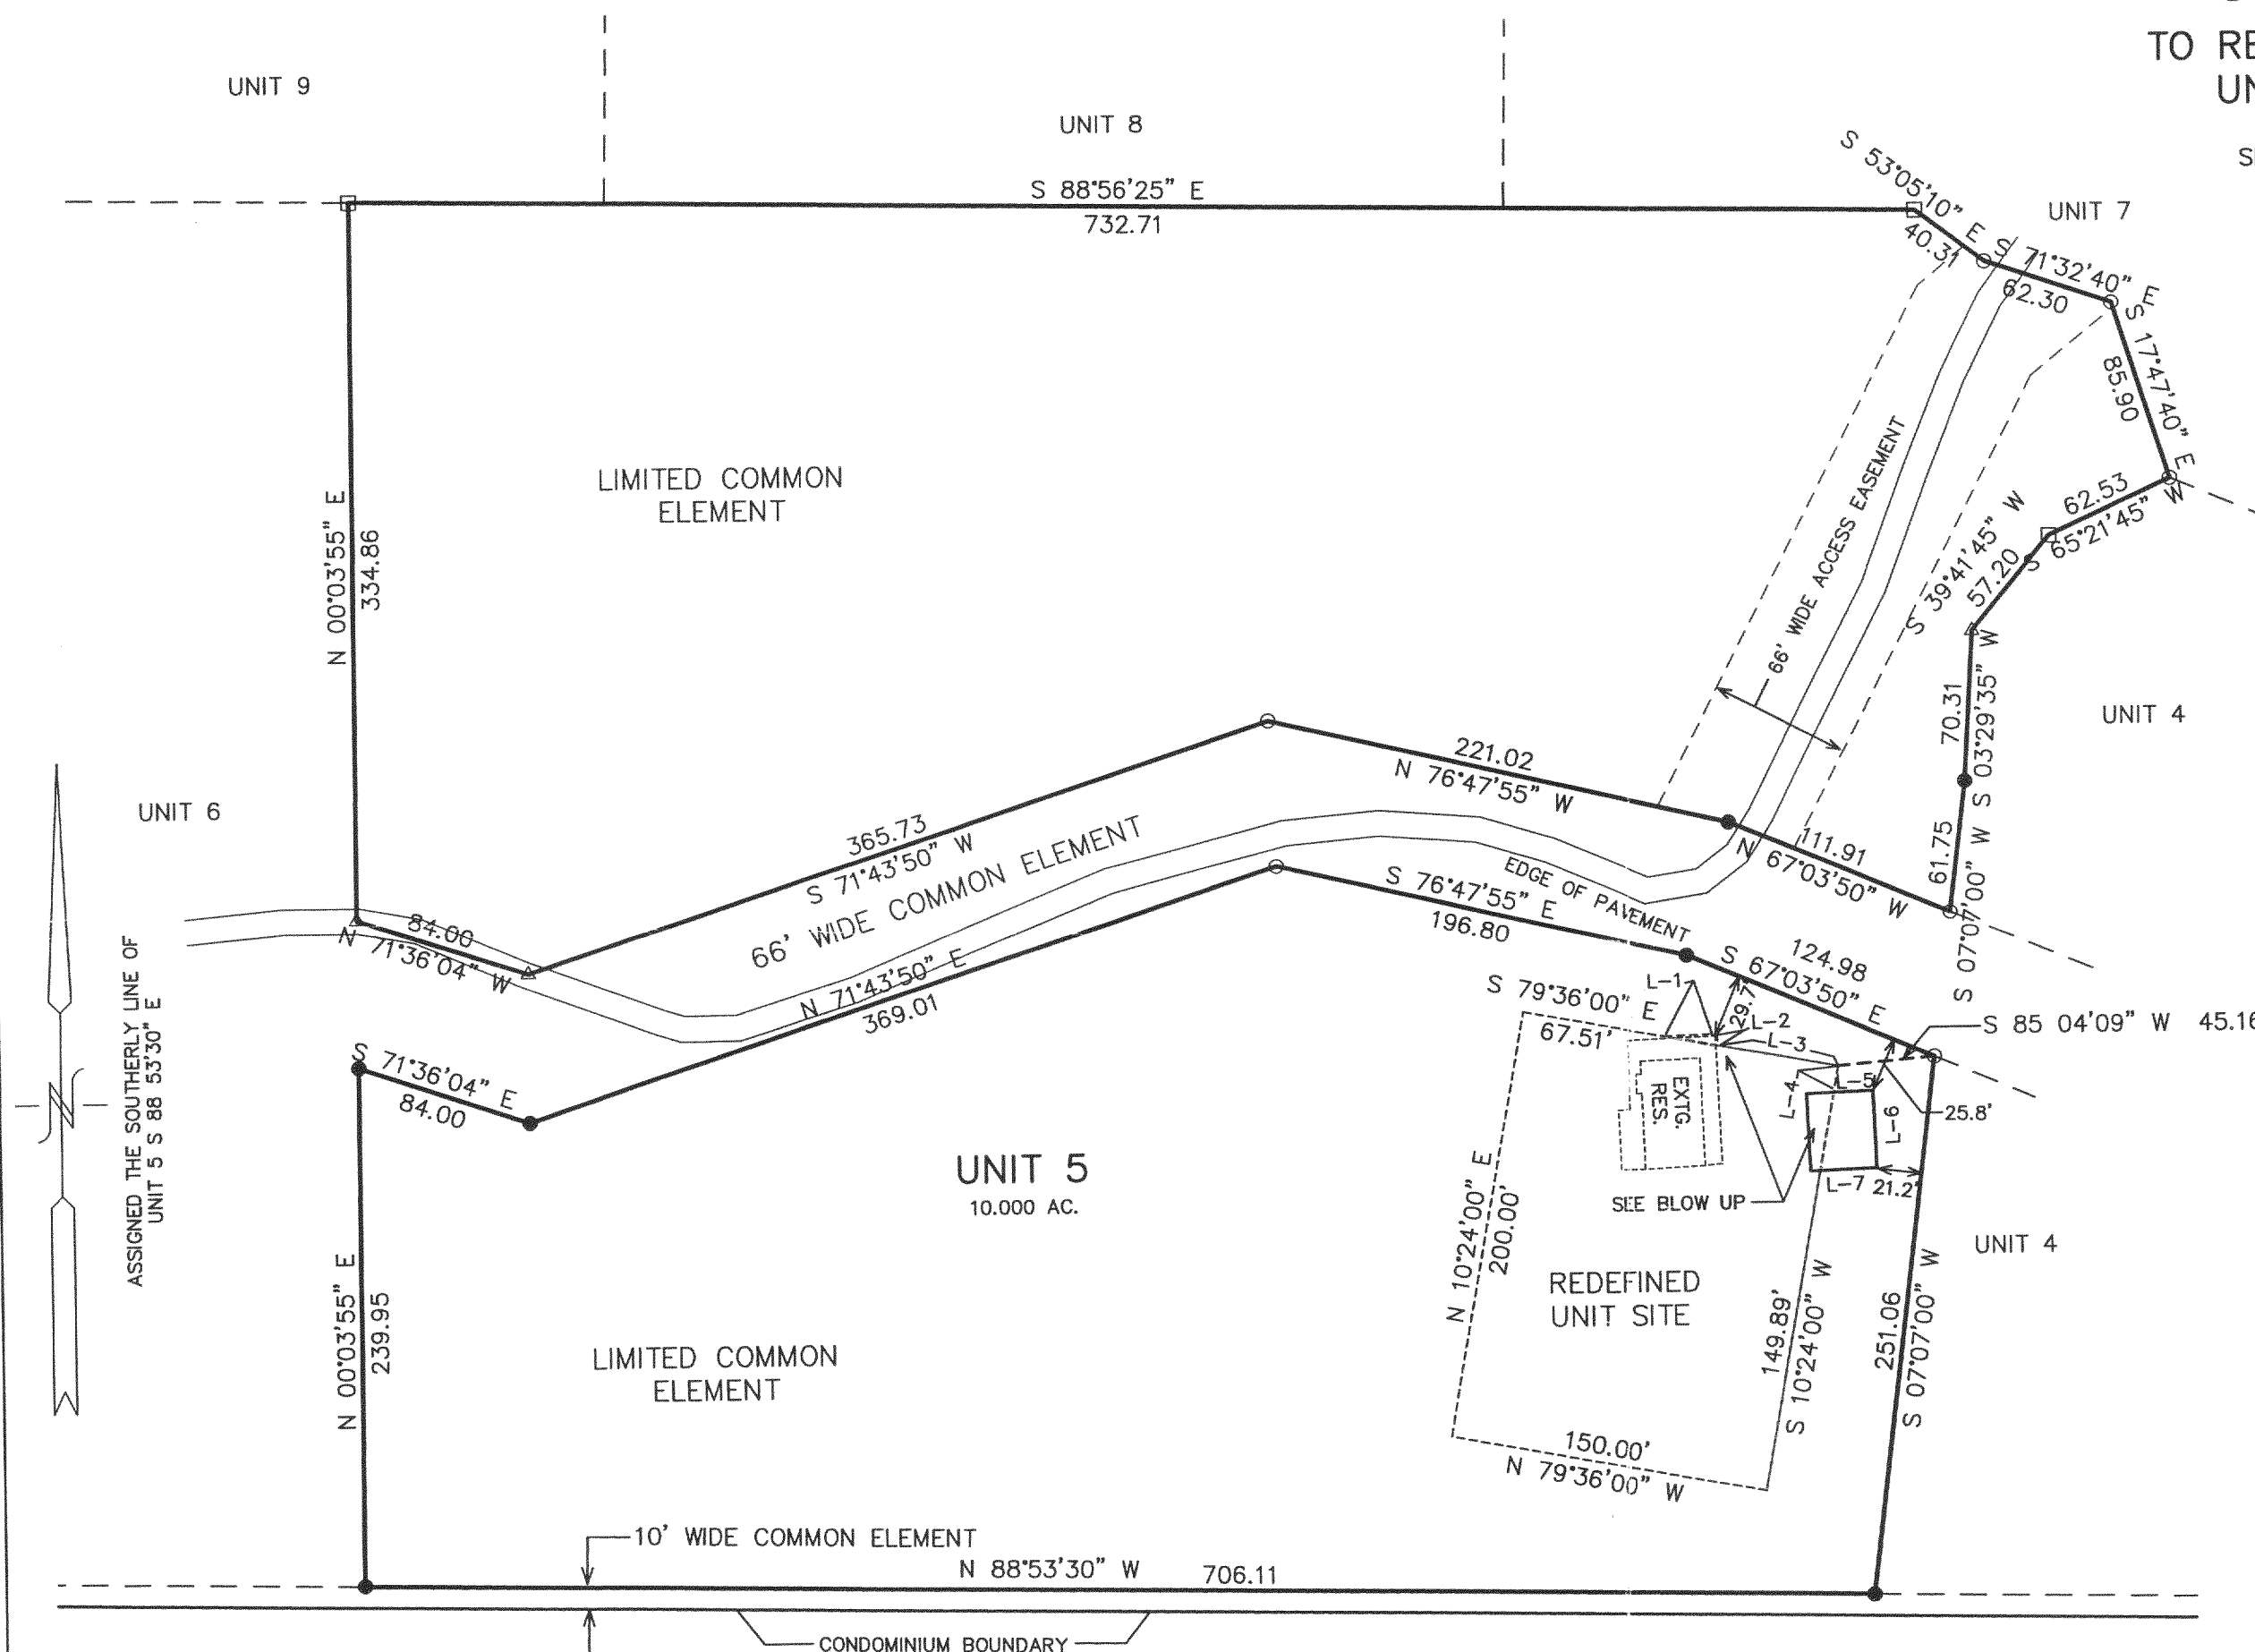

- LEGEND**
- = FOUND IRON PIPE STAKE
 - = SET IRON REBAR STAKE, 3/4" x 24" x 1.50 lbs./ft.
 - = RECORD UNIT CORNER
 - △ = SET NAIL
 - (xxx) = RECORDED AS

LINE	BEARING	DISTANCE
L1	N 87°45'28" E	24.97'
L2	S 02°23'34" E	5.60'
L3	S 79°36'00" E	56.89'
L4	S 10°24'00" W	12.19'
L5	N 87°44'43" E	18.79'
L6	S 02°15'17" E	37.00'
L7	S 87°44'43" W	27.09'

"I, PETER S. GORDON, A WISCONSIN REGISTERED LAND SURVEYOR, S-2101, DO HEREBY CERTIFY THAT THIS CONDOMINIUM PLAT IS A CORRECT REPRESENTATION OF THE CONDOMINIUM DESCRIBED AND THE IDENTIFICATION AND LOCATION OF EACH UNIT AND THE COMMON ELEMENTS CAN BE DETERMINED FROM THIS PLAT."

Peter S. Gordon
PETER S. GORDON R.L.S. 2101

REVISED 04/24/2003 - TO SHOW 25' UNIT SITE SETBACK
REVISED 07/28/2003 - TO SHOW SIZE & LOCATION OF AS-BUILT GARAGE

FARRIS, HANSEN & ASSOCIATES, INC.

ENGINEERING - ARCHITECTURE - SURVEYING

7 RIDGWAY COURT, PO BOX 437

ELKHORN, WISCONSIN 53121

PHONE: (262) 723-2098

FAX: (262) 723-5886

PROJ. NO. 6132 | DATE: 01/08/2003 | SHEET: 1 OF 1

OSCA-5

AUG 21 2003

W

318-854