

-OF-

SURVEY FOR: BOB RIGGS CONSTRUCTION

SURVEY LOCATION: _____ SKI HILL DRIVE


EXISTING TOP OF FOUNDATION: 130.5

Robert J. Wetzel
ROBERT J. WETZEL S-1778

LEGEND


- FOUND IRON PIPE
- SET IRON PIPE
- 120.0 EXISTING ELEVATION
- △ SOIL BORING

"This survey is made for the use of the present owners of the property, and those who purchase, mortgage, or guarantee the title thereto within one year from date hereof."

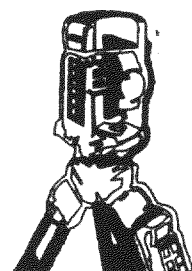

B.W. SURVEYING, INC.

LAND SURVEYS
MAPPING AND PLANNING
412 N. PINE STREET
BURLINGTON, WI 53105
(262)-767-0225

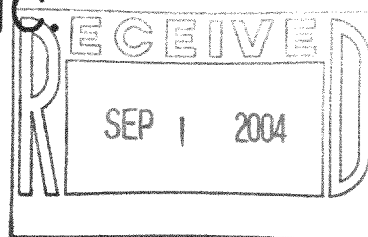

CURVE DATA

F.i.p. is 0.14' north
and 0.49' west
of actual corner.

10' WIDE LIMITED COMMON ELEMENT
-N83°28'51"E- -291.86'-

N00°02'57"W

240.00


220.92'
S62°53'57"W

F.i.p. is 0.28' north
and 0.85' west
of actual corner.

EXISTING FOUNDATION
(see detail)

DETAIL

SCALE: 1" = 30'

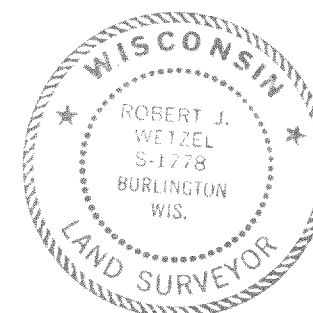

THIS IS NOT AN ORIGINAL PRINT
UNLESS THIS SEAL IS RED.

Robert J. Wetzel
ROBERT J. WETZEL S-1778

APRIL 6, 2004
DATE

6293
JOB NUMBER

OH2 00020

318-896