


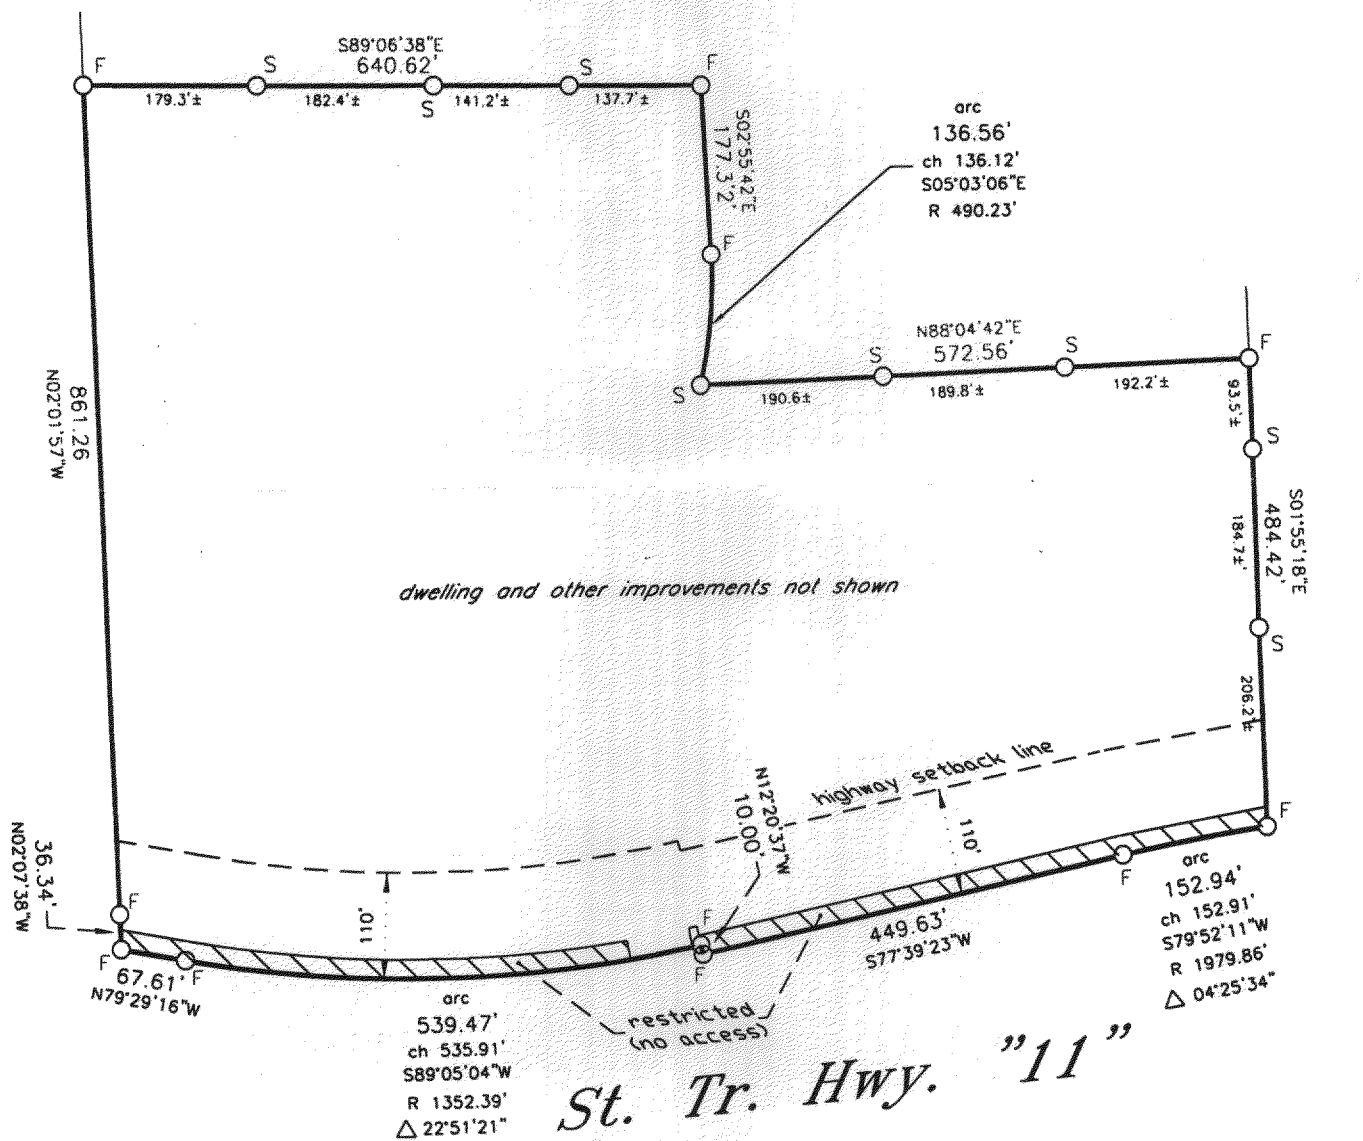

Bearings refer to grid north,
Wisconsin Plane coordinate
system, south zone.


Scale
1" = 200'

denotes iron stake
(F) found (S) set

Refer to a current title report for a complete legal description and for any easements or restrictions which may affect this site.

Reference: prior survey by
R.J. Wetzel (S-1778) in 1999.

MARESCALCO COUNTYWIDE SURVEYING, INC.
1120 80TH STREET KENOSHA, WI 53143
(262) 654 6809 FAX (262) 654 1120

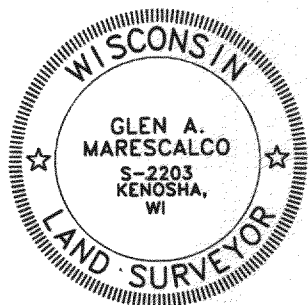

I hereby certify that
the intermediate iron
stakes shown hereon,
were set under my
direction.


[Signature]

Reg. Land Surveyor
May 30, 2002

Plat of Survey Showing
INTERMEDIATE IRON STAKES
SET ALONG PROPERTY LINES

in SE1/4 Section 27-3-18

TOWN OF SPRING PRAIRIE
WALWORTH COUNTY, WIS.

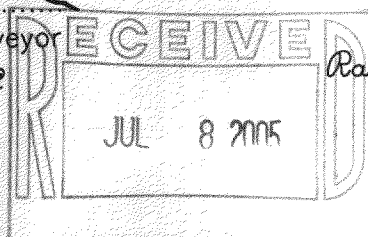

-for-
Randy Marescalco

OA 323700004

318-919