
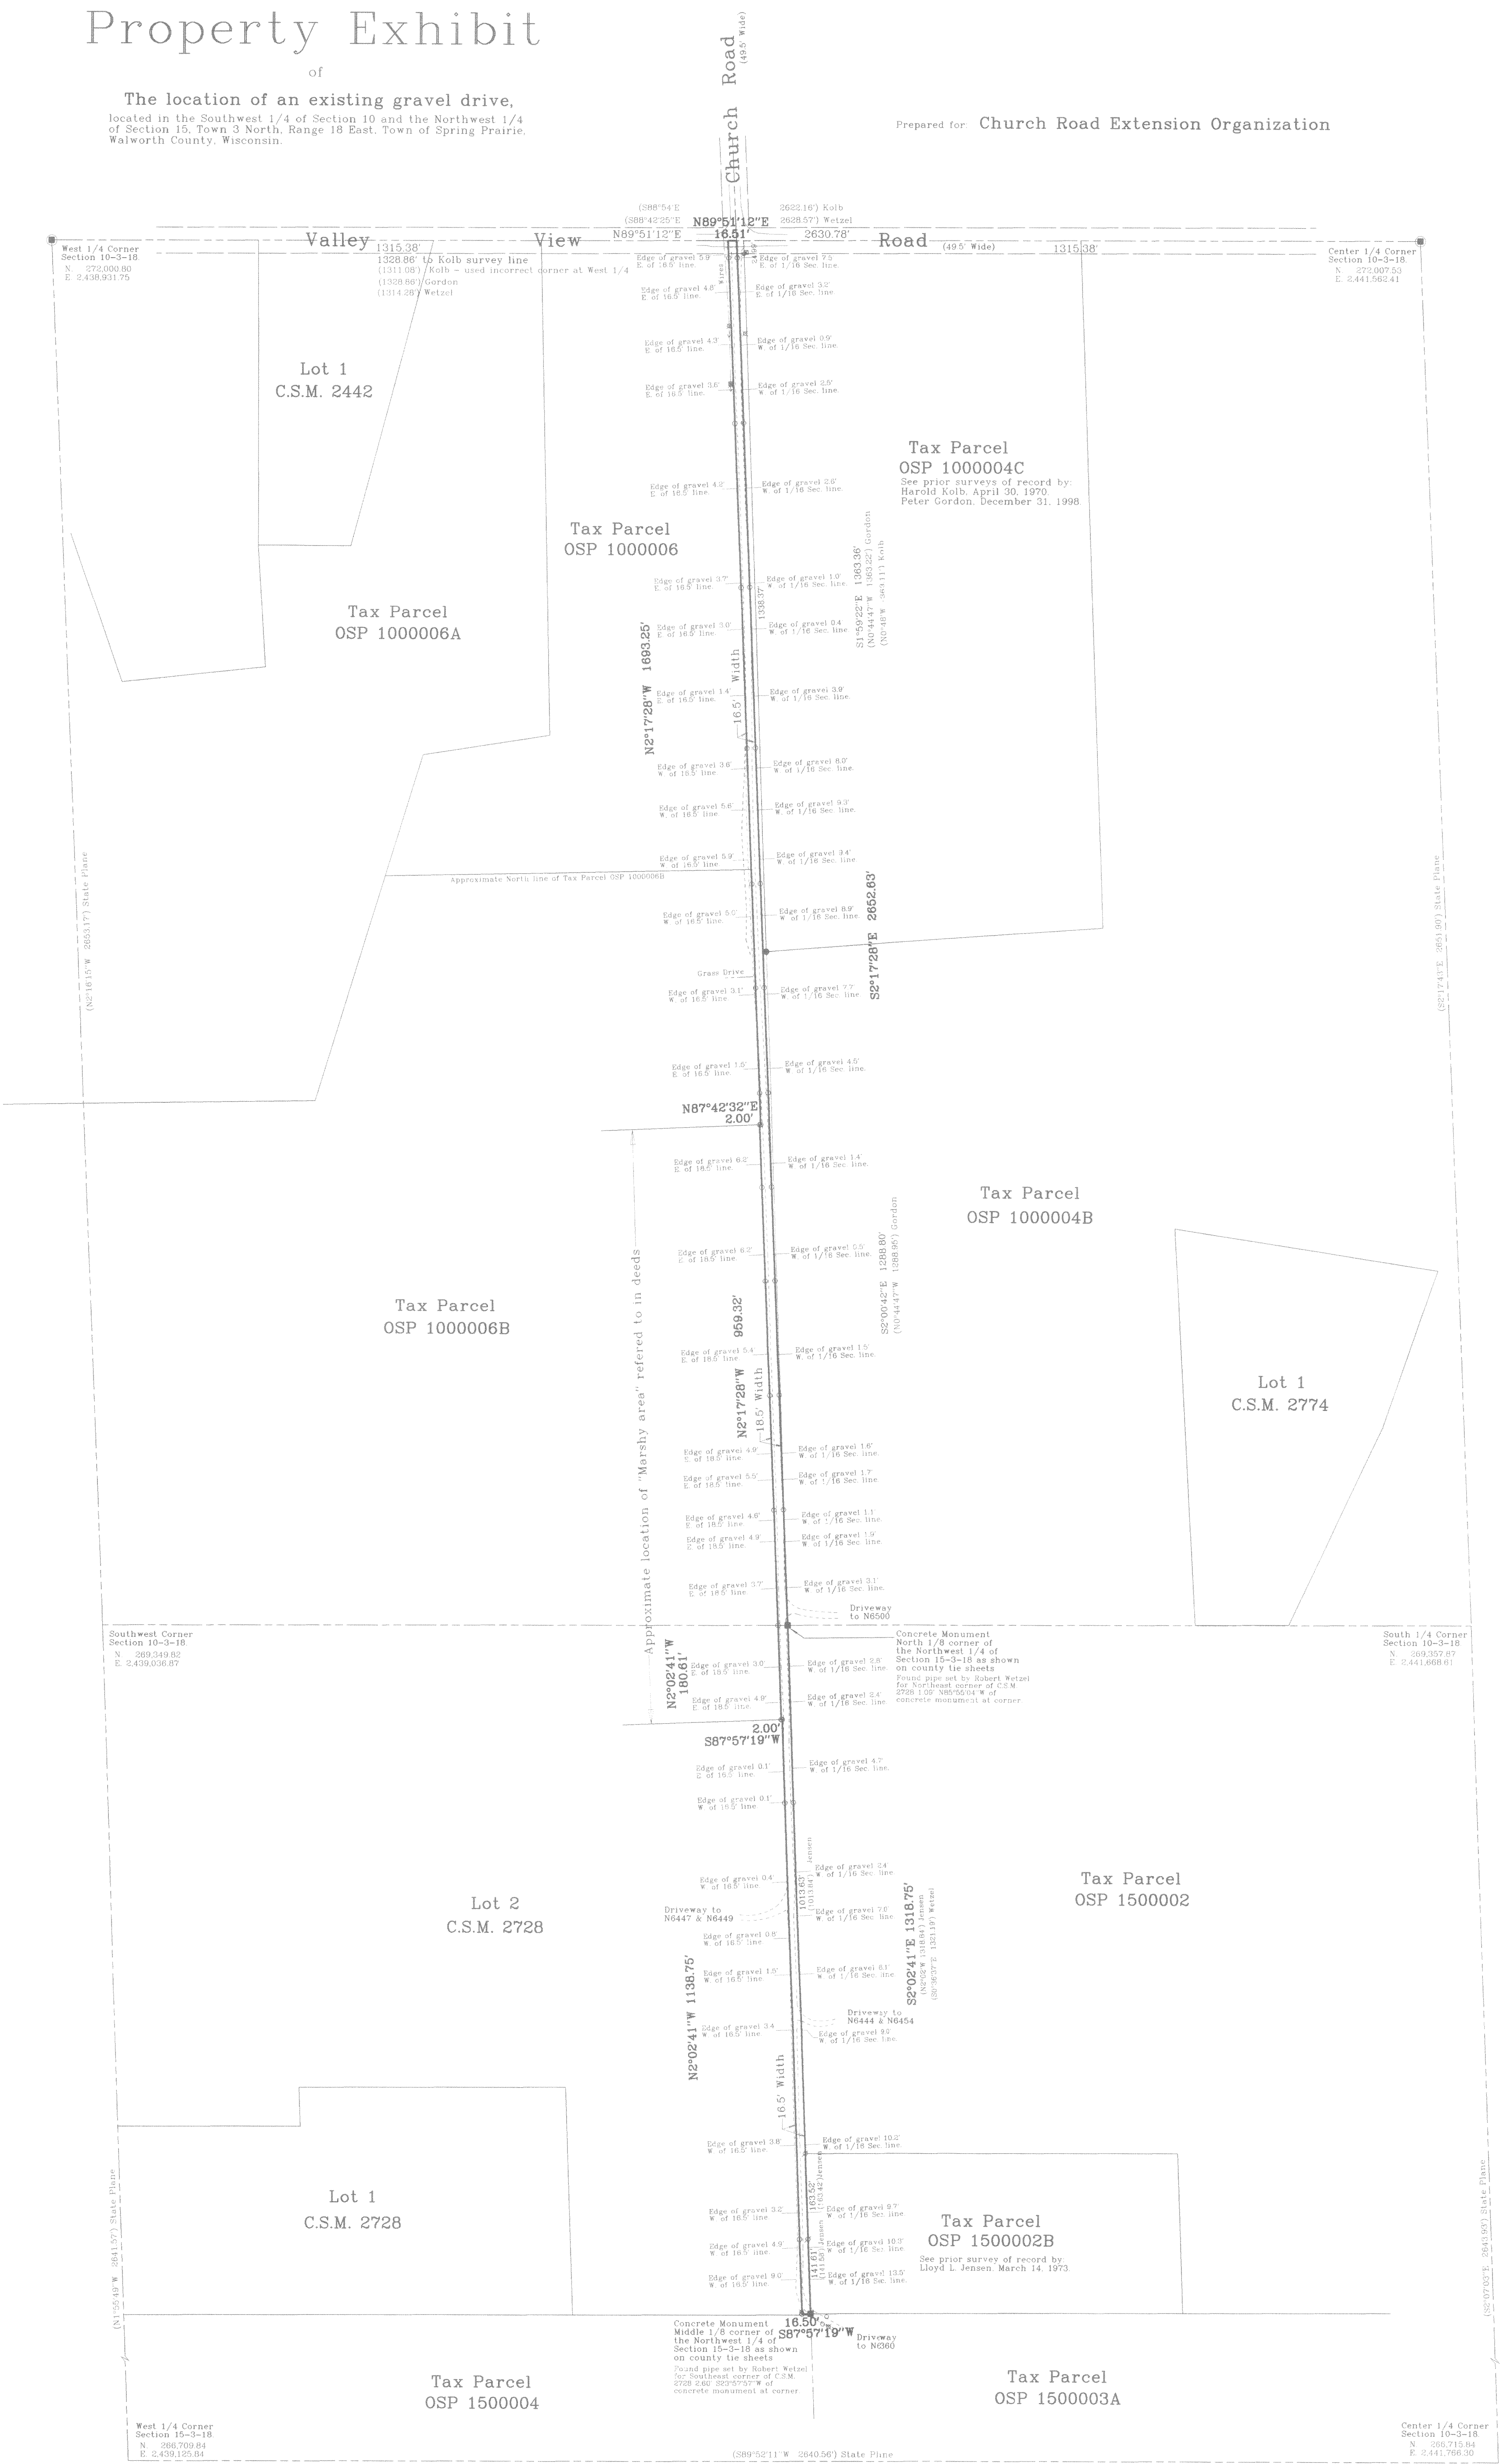


Property Exhibit


The location of an existing gravel drive,
located in the Southwest 1/4 of Section 10 and the Northwest 1/4
of Section 15, Town 3 North, Range 18 East, Town of Spring Prairie,
Walworth County, Wisconsin.

Prepared for: Church Road Extension Organization

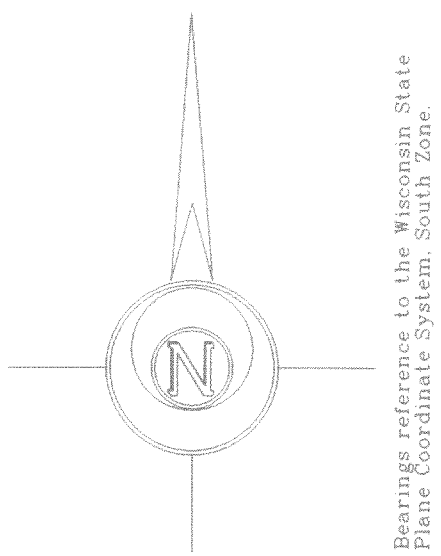

See Detail of This
Portion on Sheet 2

See Detail of This
Portion on Sheet 3

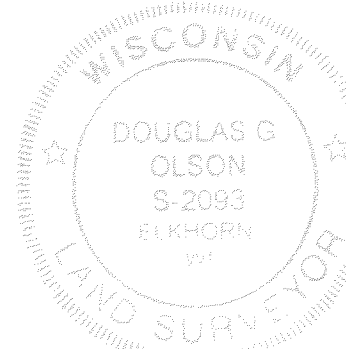

2004.127

Sheet 1 of 3 Sheets.

Job Reference Number

2004.127

Legend

- Found Concrete Monument
- Found Iron Pipe
- Found Iron Rod
- Set Wood Lath
- Set Iron Rod
- Recorded Information
- Utility Pole
- Utility Pedestal
- Asphalt Surface
- Gravel Surface




Jensen & Olson Land Surveying, LLC

45 South Wisconsin Street P.O. Box 322
Elkhorn, Wisconsin 53121
Telephone: (262) 723-3434
Facsimile: (262) 723-8044

Scale in Feet

1" = 150'

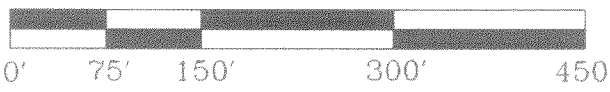

Survey date: September 17, 2004.
Revisions: No. 1 - Set Iron Rods
No. 2 - Corrections

OSP 1-4C OSP 1-6 OSP 1-6B OSP 1-4B OSP 15-2 OSP 15-2B
OA 2728 - 2


318-948

Property Exhibit



of

The location of an existing gravel drive,
located in the Southwest 1/4 of Section 10 and the Northwest 1/4
of Section 15, Town 3 North, Range 18 East, Town of Spring Prairie,
Walworth County, Wisconsin.

Prepared for: Church Road Extension Organization

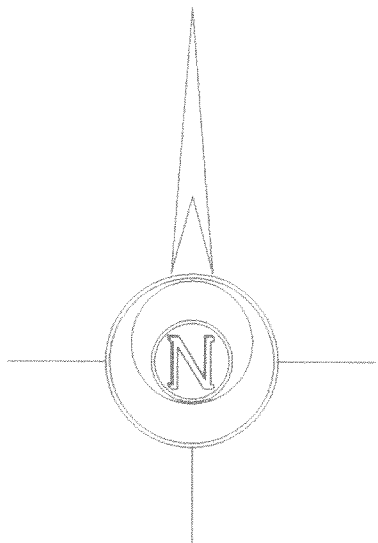

Beating reference to the Wisconsin State
Plane Coordinate System, South Zone

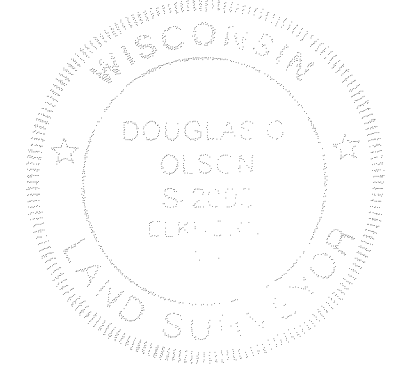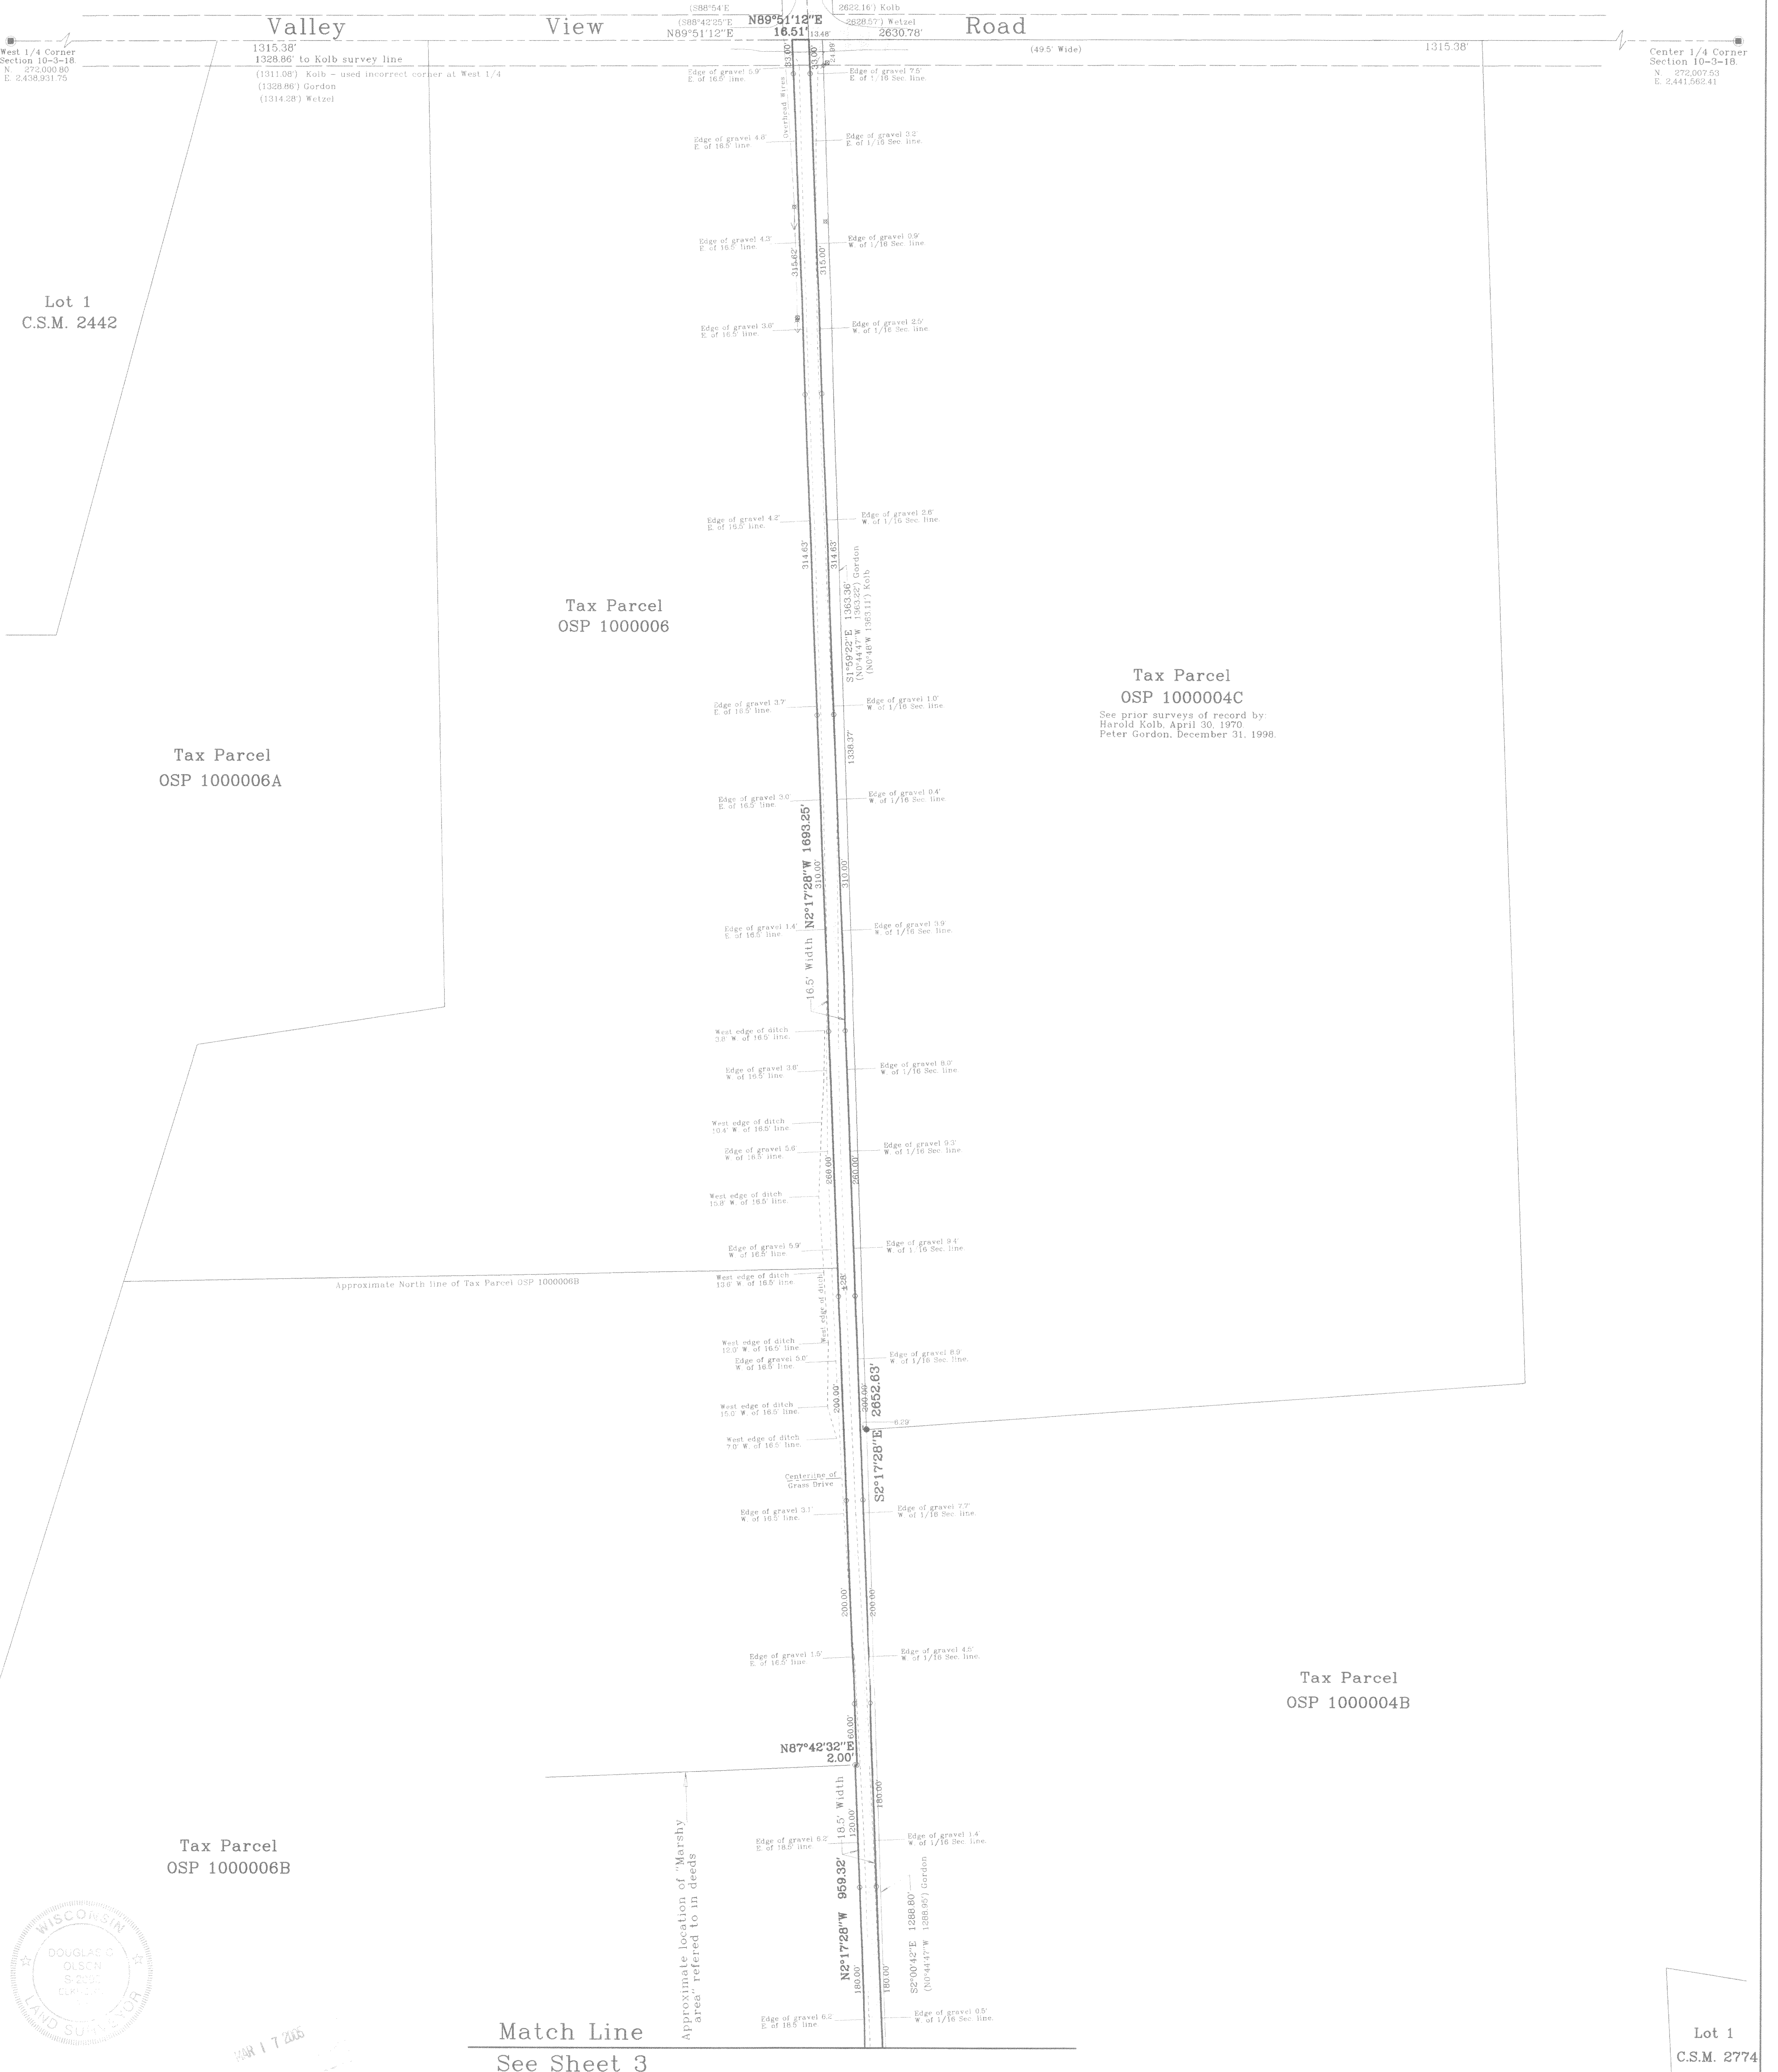

2004.127

Property Exhibit

See Sheet 2
Match Line

The location of an existing gravel drive,
located in the Southwest 1/4 of Section 10 and the Northwest 1/4
of Section 16, Town 3 North, Range 18 East, Town of Spring Prairie,
Walworth County, Wisconsin.

Prepared for: Church Road Extension Organization

Tax Parcel
OSP 1000006B

Tax Parcel
OSP 1000004B

Lot 2
C.S.M. 2728

Tax Parcel
OSP 15000002


Lot 1
C.S.M. 2728

Tax Parcel
OSP 1500002B



See prior survey of record by
Lloyd L. Jensen, March 14, 1973.

Tax Parcel
OSP 15000004

Tax Parcel
OSP 1500003A

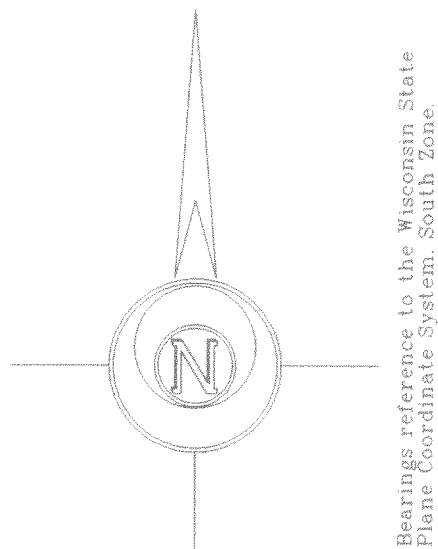

Approximate location of "Marshy area" referred to in deeds

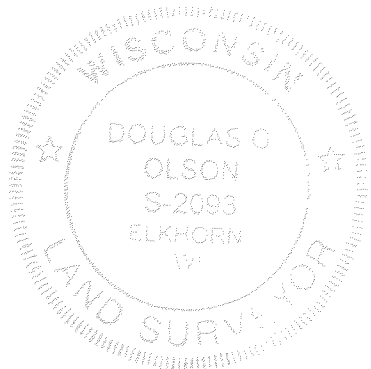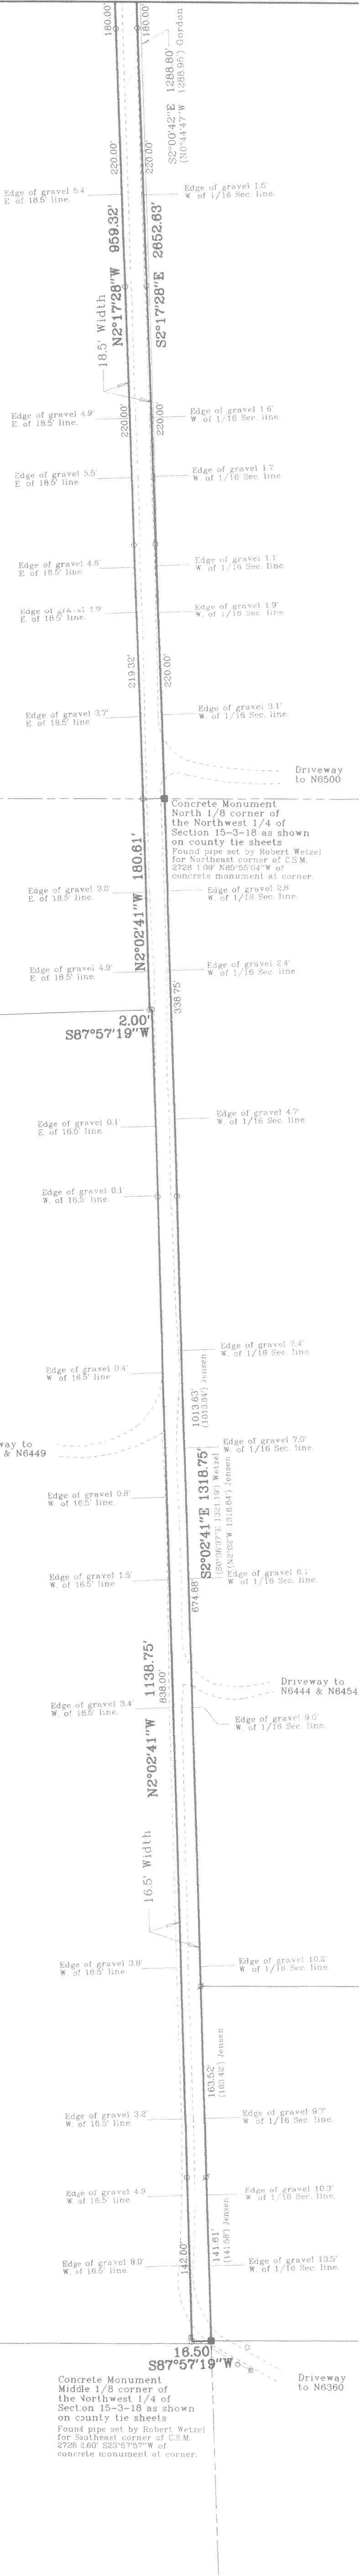

MAP 17-03

Sheet 3 of 3 Sheets

Legend

- Found Concrete Monument
- Found Iron Pipe
- Found Iron Rod
- Set Wood Lath -> Set Iron Rod
- Recorded Information
- Utility Pole
- Utility Pedestal
- Asphalt Surface
- Gravel Surface

Job Reference Number
2004.127



Jensen & Olson Land Surveying, LLC

45 South Wisconsin Street P.O. Box 322
Elkhorn, Wisconsin, 53121
Telephone: (262) 723-3434
Facsimile: (262) 723-8044

Scale in Feet

1" = 75'



Survey date: September 17, 2004.
Revisions: No. 1 - Set Iron Rods
No. 2 - Corrections