

# LAND-MARK SURVEYING

**Mark L. Miritz**


Wisconsin Registered Land Surveyor S-2582

**N9330 Knuteson Drive  
Whitewater, WI 53190  
Phone: (262) 495-3284  
FAX: (262) 495-8421  
AND-MARKSURVEYING.COM**

# PLAT OF SURVEY

**Lot 2 of Certified survey Map Number 1999,  
as recorded in Volume 9 of Certified Survey  
Maps as Pages 277 and 278 as Document No.  
206054, Being located in the Northeast 1/4  
of Section 22, Town 3 North, Range 18 East,  
Town of Spring Prairie, County of Walworth,  
State of Wisconsin.**

**Owners: David and Susan Laskowski  
N5948 Lyons Road  
Burlington, Wi. 53105**

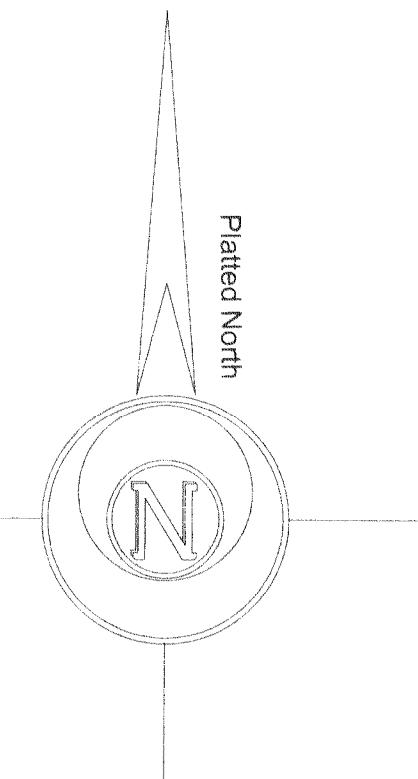

LOT 5 PRAIRIE ESTATES


S 88°25'00" E 288,99'

LOT 2

45,355 S.F.

3

LOT 4

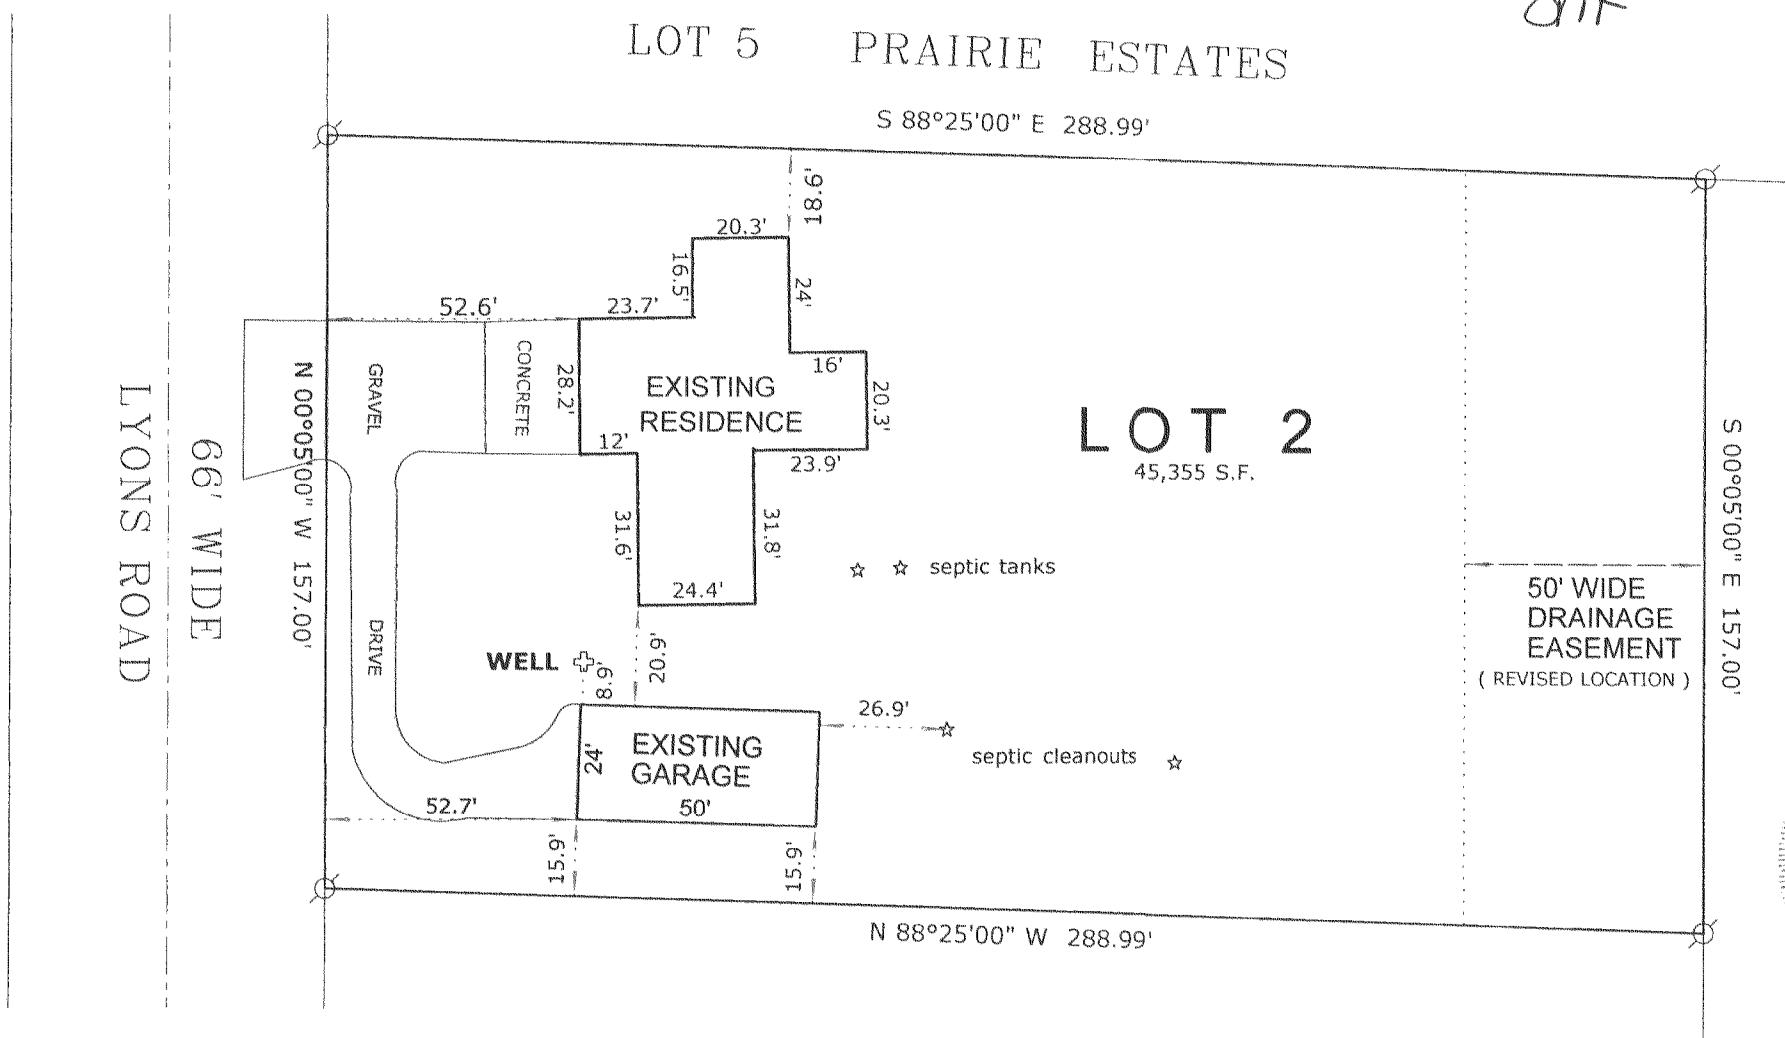

## LEGEND

- ∅ FOUND IRON PIPE
- Ⓐ FOUND IRON ROD
- ☒ FOUND COUNTY MONUMENT
- ☐ FOUND CONCRETE MONUMENT
- ⊕ CHISEL CUT IN CONCRETE
- SET IRON ROD, 24" LONG, WEIGHING 1.5 LBS./LINEAL FT., 3/4" DIA.
- ( x x ) RECORDED AS DIMENSION

---

— V — X — EXISTING FENCE

SCALE: 1" = 40 FEET

"I hereby certify that the above described property has been surveyed by me or under my direction and that the above map is a true representation thereof and shows the size and location of the property, its exterior boundaries, the location of all visible structures and dimensions of all principal buildings thereon, boundary fences, apparent enclosures, roadways and visible encroachments, if any."

ements, roadways and visible encroachments, if any. This survey is made for the use of the present owners of the property, and also those who purchase, mortgage, or guarantee the title thereto within one year from date of record.

MARK L. MIRITZ  
WISCONSIN REGISTERED  
LAND SURVEYOR S-2582

REVISED SEPT. 12, 2006 TO SHOW GARAGE "AS BUILT"

REVISED 4/27/06 PROPOSED GARAGE ADDED DATE: August 24, 2004 JOB NO. 04.812

318-984

0A1999-2