


Plat of Survey

of

Lot 2 of Certified Survey Map No. 3348,
recorded in Vol. 18 of Certified Survey Maps of Walworth
County on Pages 161 and 162 as Document No. 453589
and located in the Southwest 1/4 of the Southwest 1/4
of Section 19, Town 3 North, Range 18 East, Town of Spring
Prairie, Walworth County, Wisconsin.

Surveyed for: **John Zenner**
N2444 Broad Street
Delavan, Wisconsin. 53115

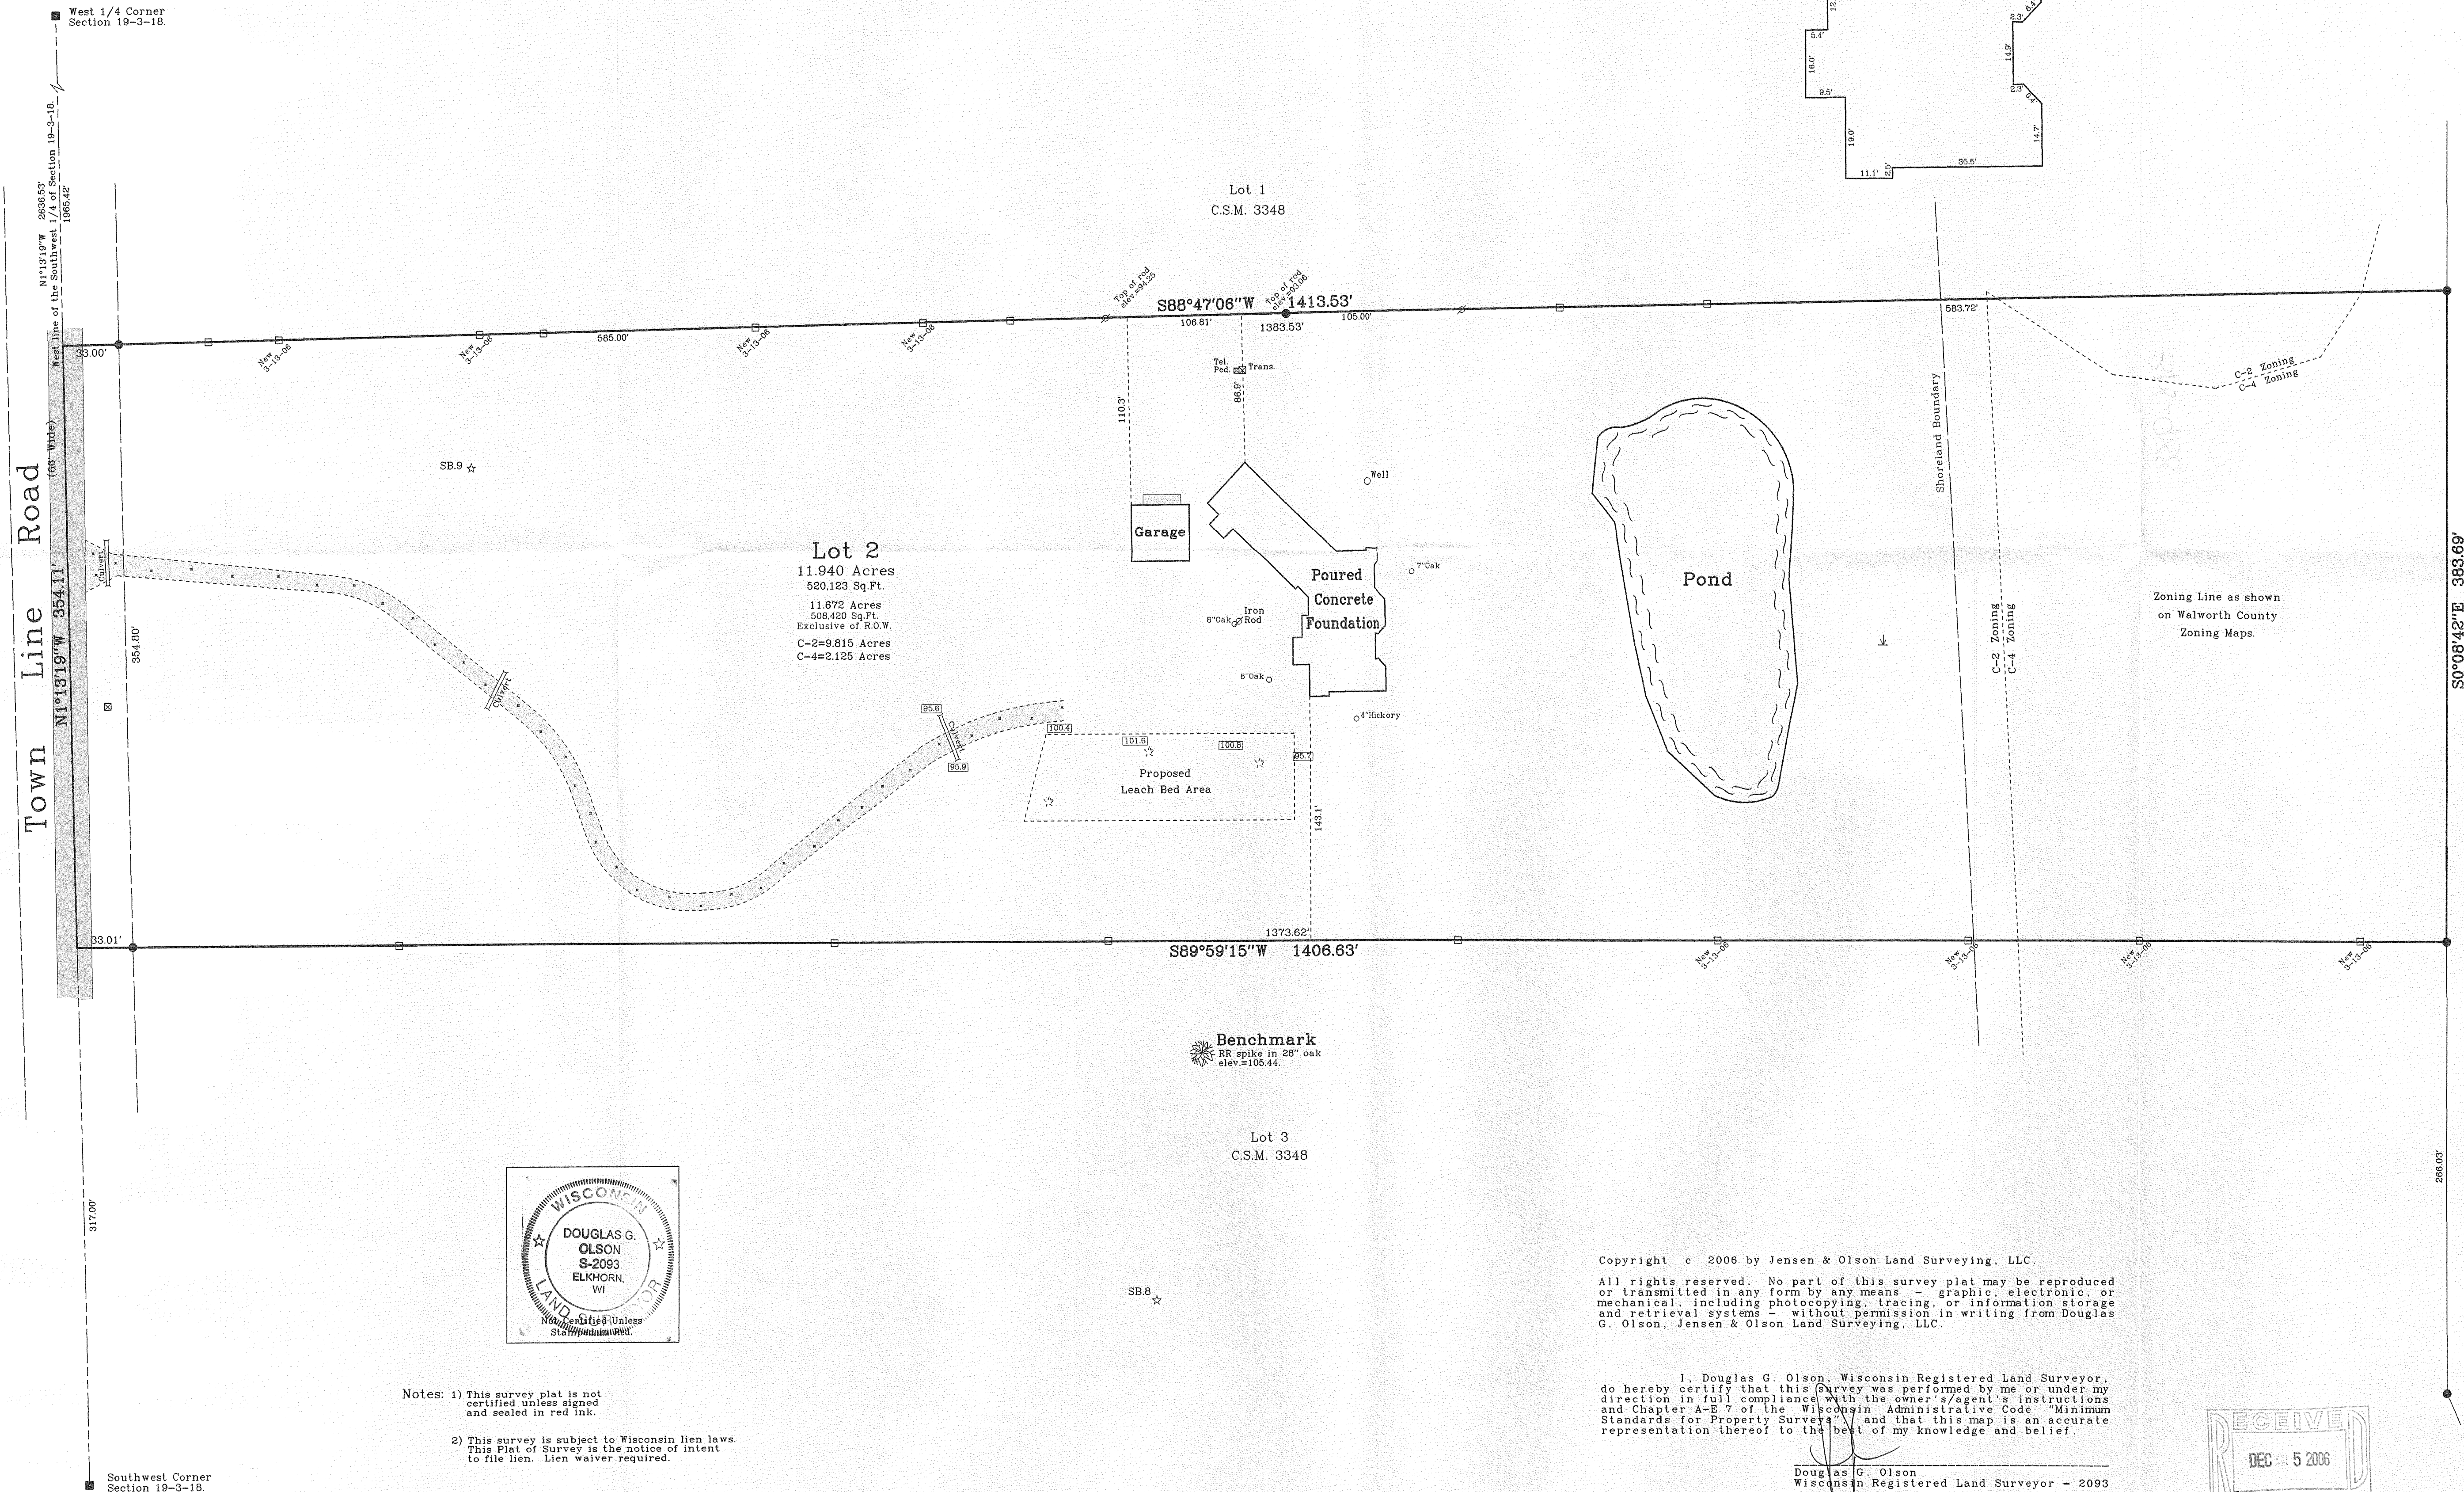


Notes: 1) This survey plat is not
certified unless signed
and sealed in red ink.
2) This survey is subject to Wisconsin lien laws.
This Plat of Survey is the notice of intent
to file lien. Lien waiver required.


Copyright © 2006 by Jensen & Olson Land Surveying, LLC.
All rights reserved. No part of this survey plat may be reproduced
or transmitted in any form by any means - graphic, electronic, or
mechanical, including photocopying, tracing, or information storage
and retrieval systems - without permission in writing from Douglas
G. Olson, Jensen & Olson Land Surveying, LLC.

I, Douglas G. Olson, Wisconsin Registered Land Surveyor,
do hereby certify that this Survey was performed by me or under my
direction in full compliance with the owner's/agent's instructions
and Chapter A-E 7 of the Wisconsin Administrative Code "Minimum
Standards for Property Surveys" and that this map is an accurate
representation thereof to the best of my knowledge and belief.

Douglas G. Olson
Wisconsin Registered Land Surveyor - 2093

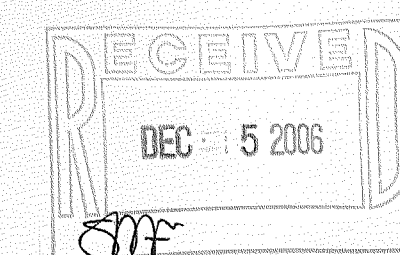

Survey date: October 2, 2003.
Revisions: No. 1 - Proposed Improvements
No. 2 - Contours
No. 3 - Field Notes
No. 4 - Field Notes & Trees
No. 5 - Field Notes & Trees
No. 6 - New House Location
No. 7 - Foundations
No. 8 - Foundations

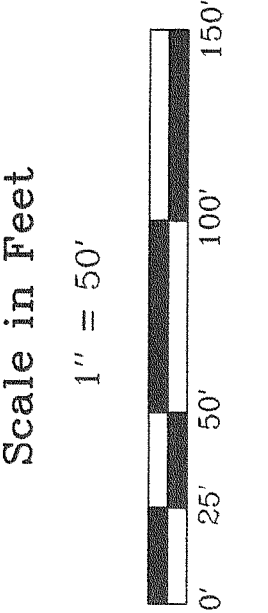

Jensen & Olson Land Surveying, LLC
45 South Wisconsin Street P.O. Box 322
Elkhorn, Wisconsin 53121
Telephone: (262) 723-3434
Facsimile: (262) 723-8044

Legend
Found County Section Corner.
Found Iron Rod, 3/4" dia. Set Wood Stake
Recorded Information X shown on CSM
Utility Pole
Applied Surface
Gravel Surface
Wisconsin Wetland Inventory Map

Sheet 1 of 1 Sheets.
Job Reference Number
2006.070

2006.070

CA3348-2

318-988