

ABERNATHY and ASSOCIATES

Kenneth B. Abernathy Jr.

Wisconsin Registered Land Surveyor S-1594


Rt. 3, Box 273
 Elkhorn, Wisconsin 53121
 Phone: (414) 723-4260 (office)
 (414) 723-4813 (residence)

PLAT OF SURVEY

**LOT 10 OF BAY VIEW ESTATES, LOCATED IN
 GOVERNMENT LOTS 1 & 2, IN THE SE 1/4 OF
 SECTION 26, T4N, R15E, COUNTY OF
 WALWORTH, STATE OF WISCONSIN.**

LOT 9

LOT 10
 0.78 ACRES ±

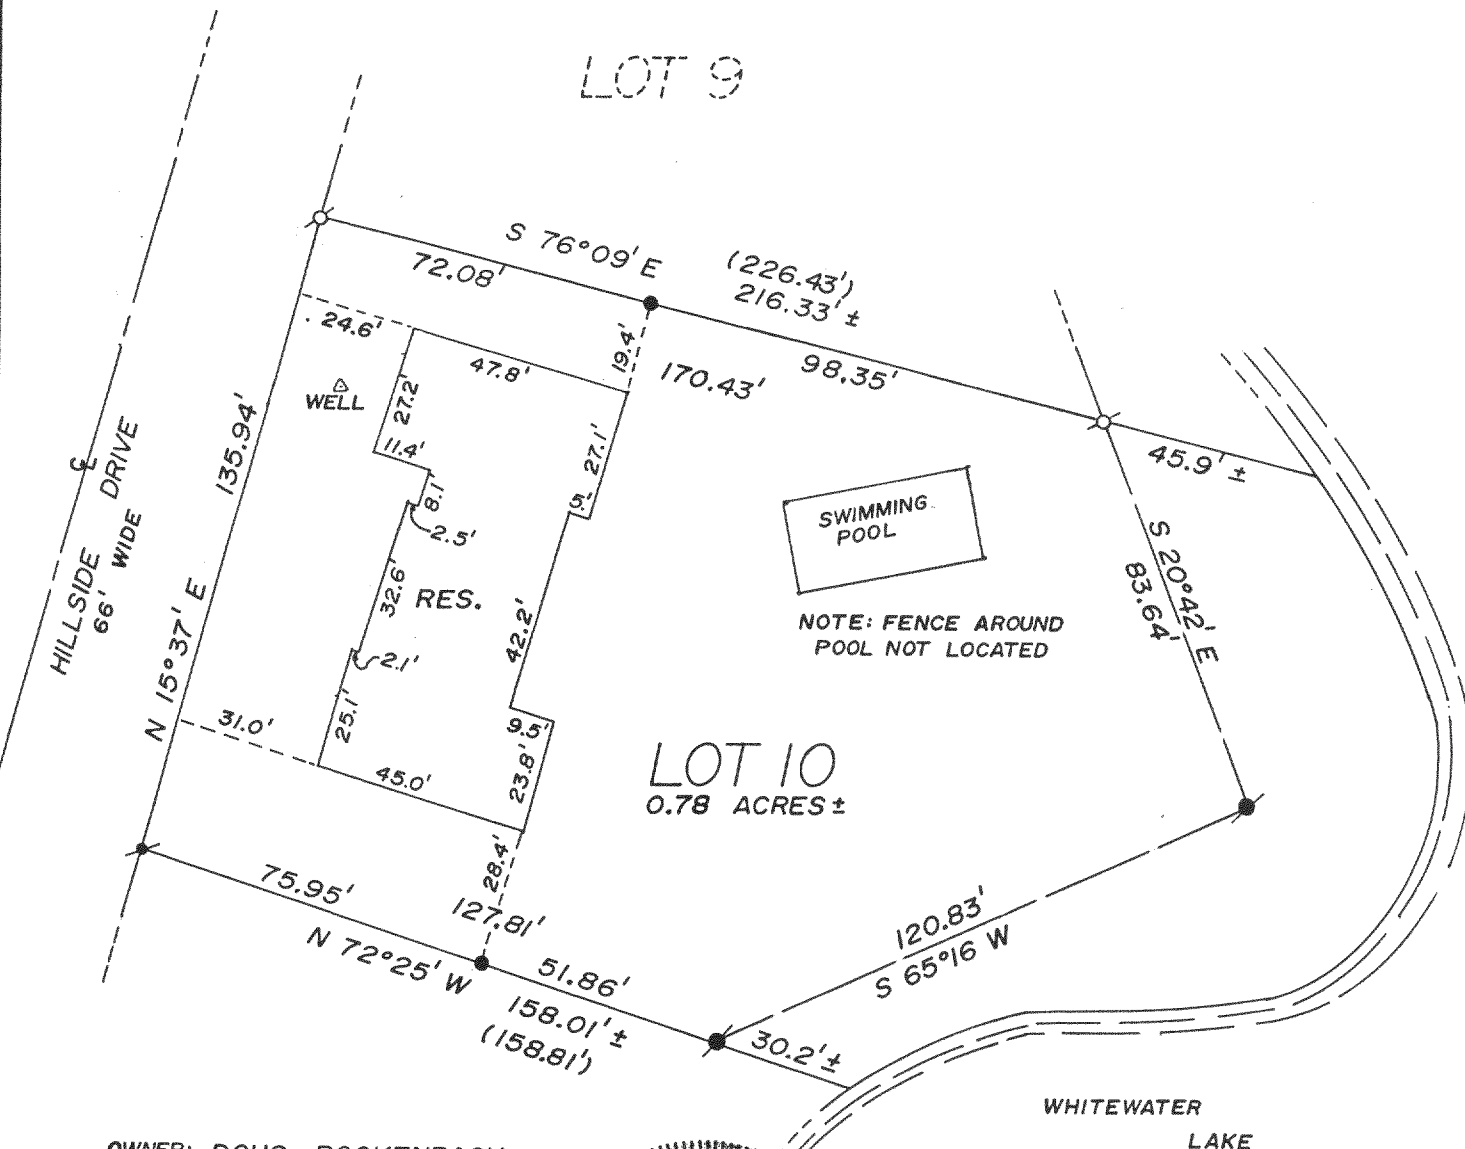

OWNER: DOUG ROCKENBACH
 P.O. BOX 1308
 GRAYSLAKE, IL. 60030



SCALE: 1" = 40' FEET

Legend

- FOUND IRON PIPE
- FOUND IRON ROD 1 1/16" DIA.
- FOUND BRASS CAPPED MONUMENT
- ⊕ FOUND CONCRETE MONUMENT
- + CHISEL CUT IN CONCRETE
- SET IRON ROD, 24" LONG, WEIGHING 1.5 LBS./LINEAL FT., 3/4" DIA.
- SET IRON ROD, 30" LONG, WEIGHING 4.5 LBS./LINEAL FT., 1-11/16" DIA.
- (xx) RECORDED AS DIMENSION
- x-x- EXISTING FENCE
- FOUND IRON ROD 1/2" DIA.


"I hereby certify that I have surveyed the above described property and that the above map is a true representation thereof and shows the size and location of the property, its exterior boundaries, the location of all visible structures and dimensions of all principal buildings thereon, boundary fences, apparent easements, roadways and visible encroachments, if any."

"This survey is made for the use of the present owners of the property, and also those who purchase, mortgage, or guarantee the title thereto within one year from date hereof."

Kenneth B. Abernathy Jr.

KENNETH B. ABERNATHY, JR.
 WISCONSIN REGISTERED LAND SURVEYOR,
 S-1594

Date: 8/17/88 Job No. 88-406

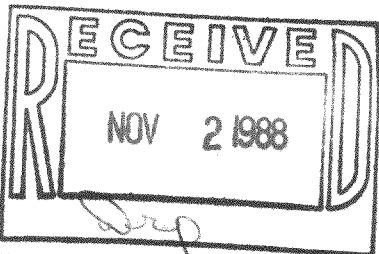

415-299