


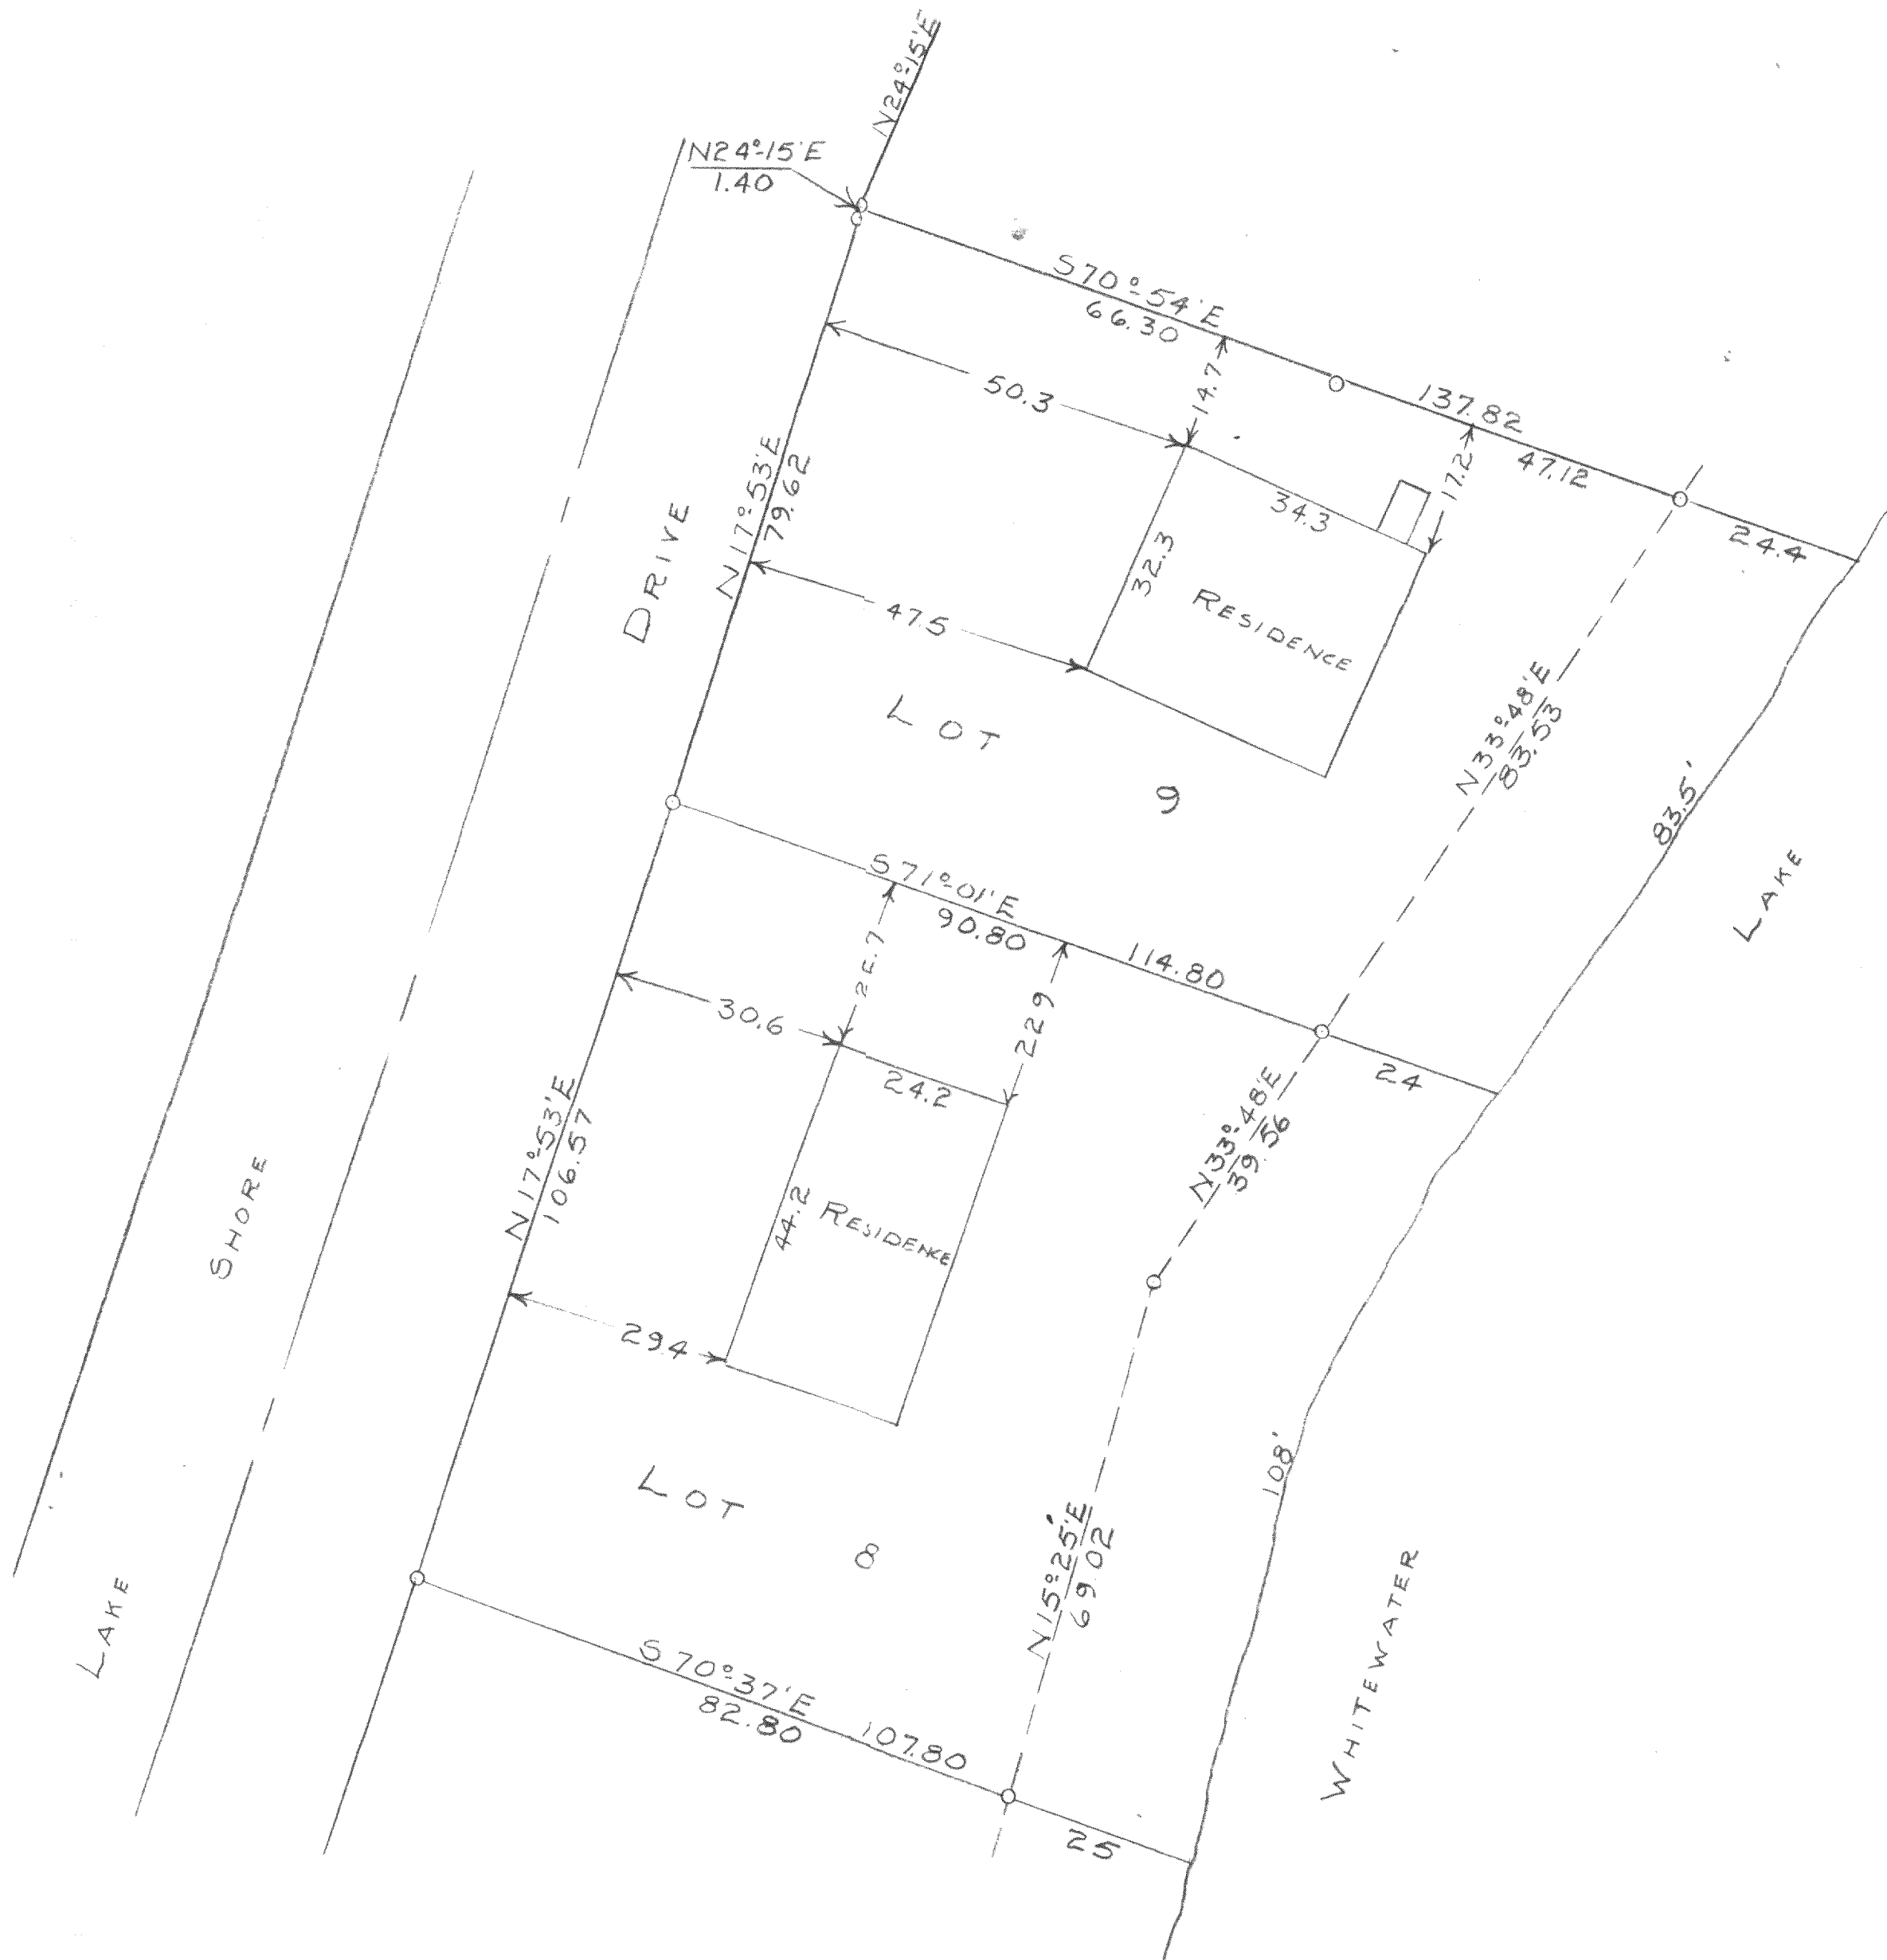

SCALE - 1" = 20'
 O = IRON PIPE

PLAT OF SURVEY OF LOTS 9 AND 8, BLOCK 1 OF MORaine PARK
 SUBDIVISION LOCATED IN SECTION 34, T4NR15E OF WALWORTH COUNTY,
 WISCONSIN
 APRIL 3, 1958

George T. Dunham
 GEORGE T. DUNHAM, SURVEYOR 415-10
 DELAVAN, WISCONSIN