


415-1015

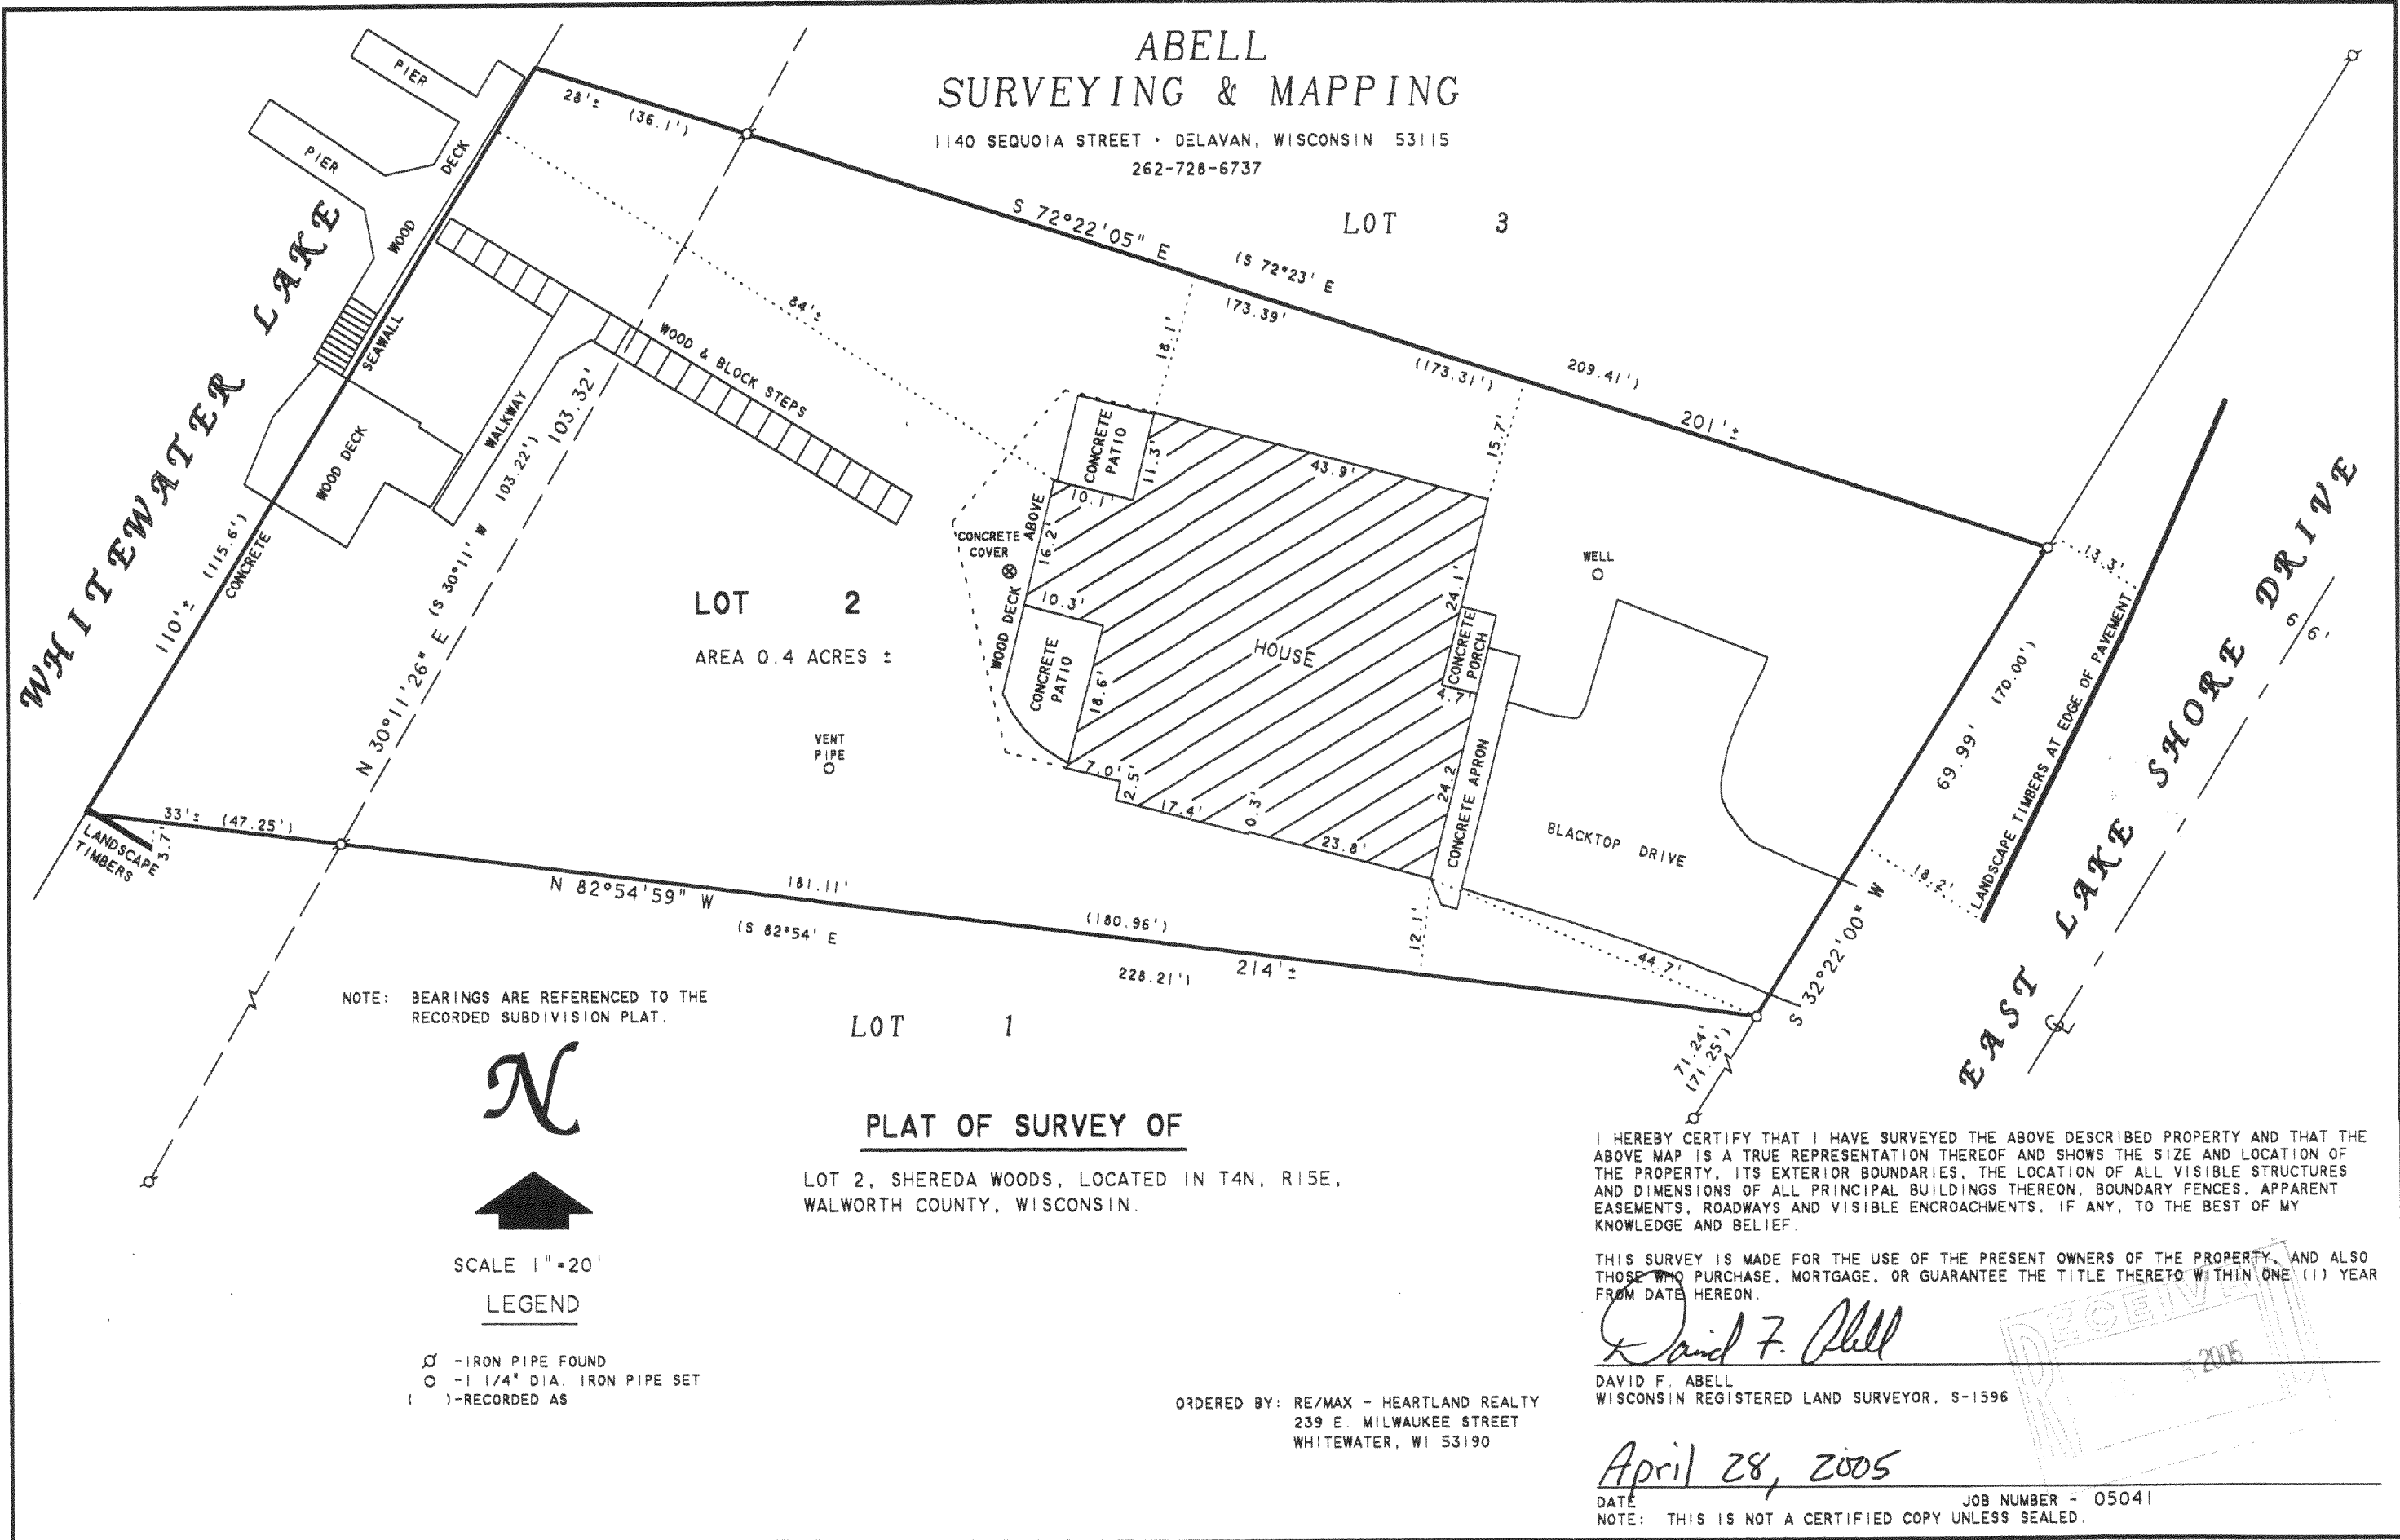

25P0002