

Job No. 60166

HOWARD E. HANSEN


Wisconsin Land Surveyor
1632 DOUGLAS AVENUE
RACINE, WISCONSIN

Res. Phone MEIrose 4-0565
Office Phone MEIrose 7-3346

PLAT OF SURVEY

OF PROPERTY OF THRIFTY BUILDERS INC.

described as follows: LOT #7 ROSE CREST ADDITION, CITY OF
WHITEWATER, WALWORTH COUNTY, WISCONSIN

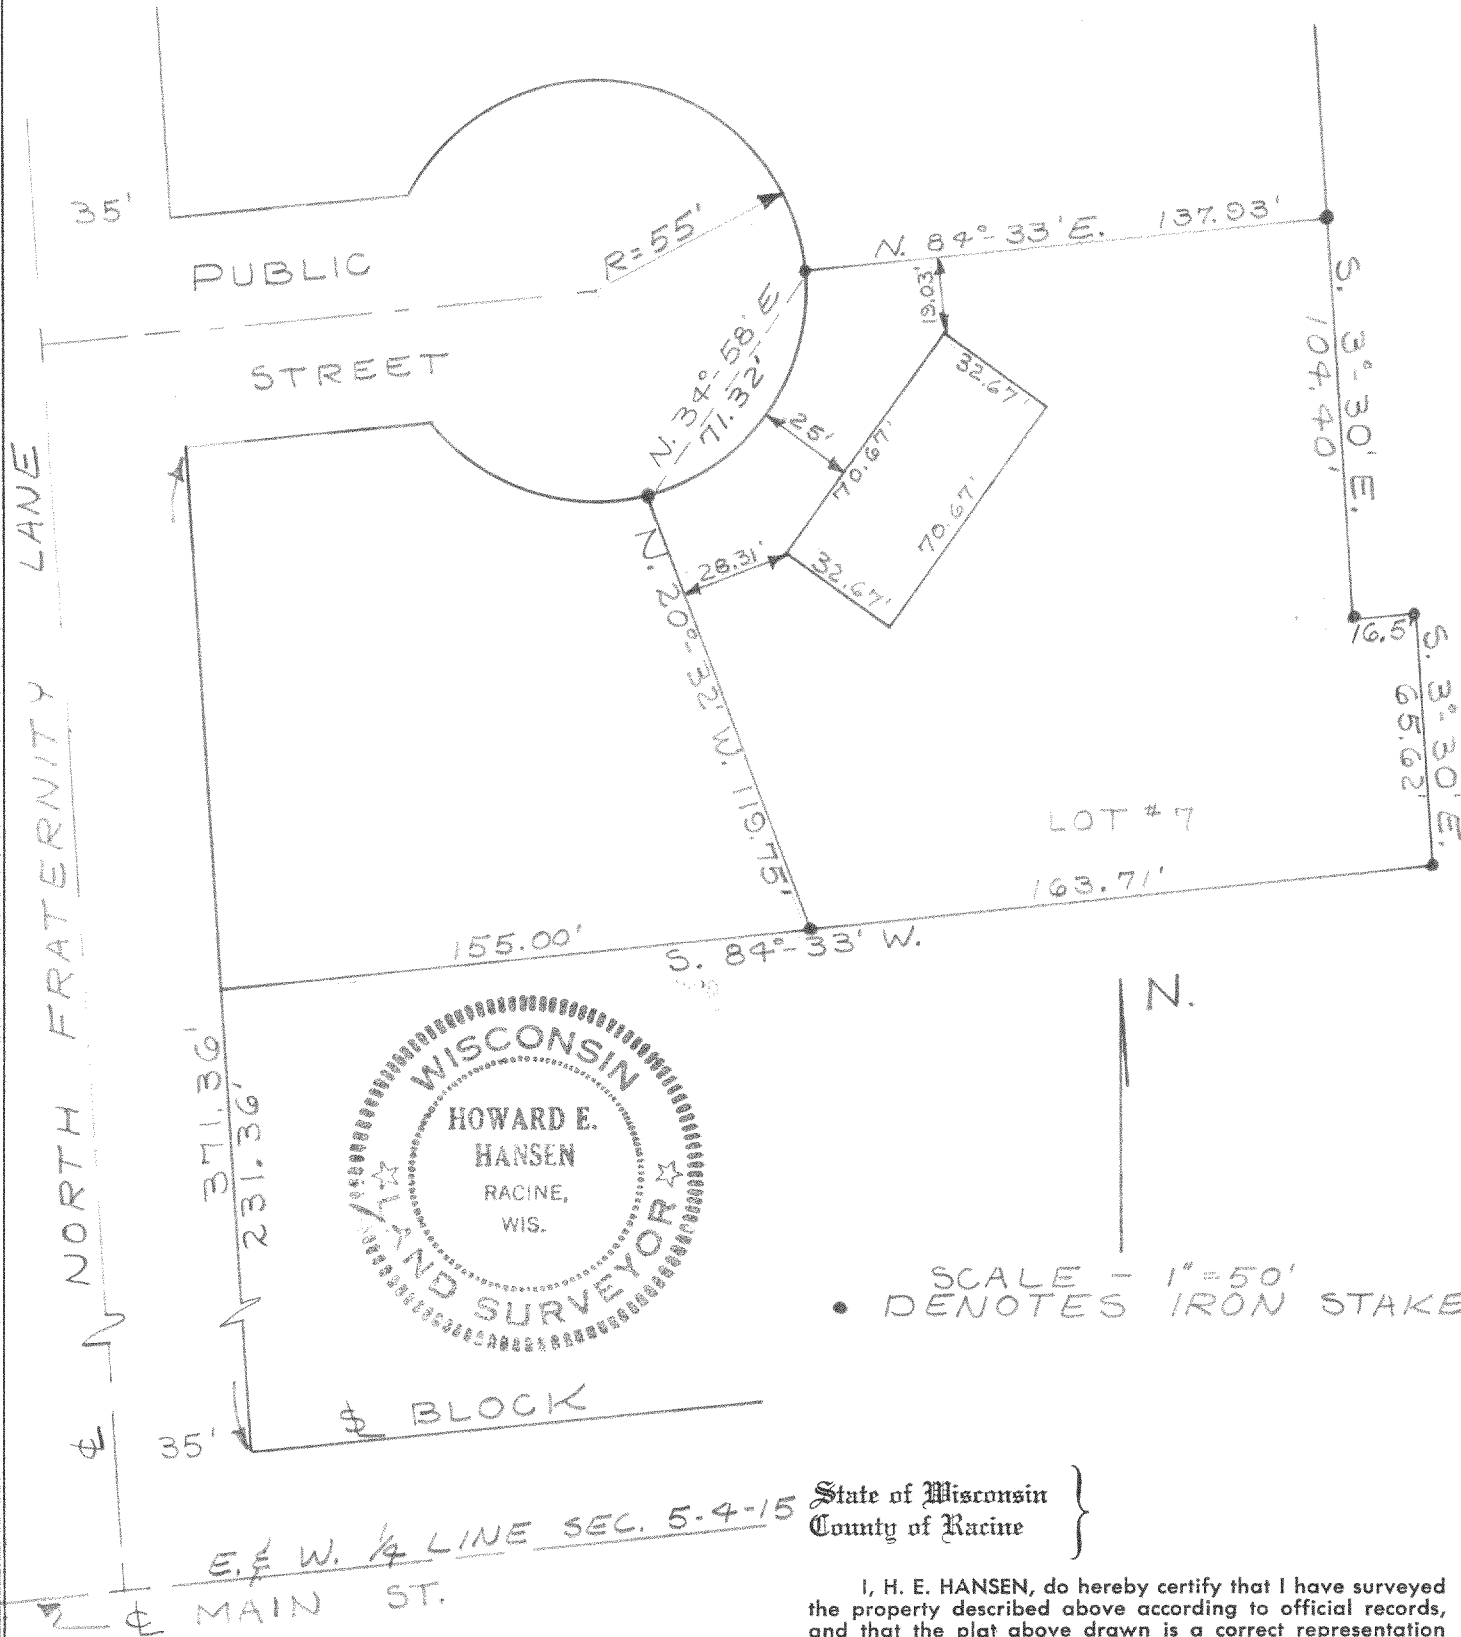

SCALE - 1"=50'
• DENOTES IRON STAKE

State of Wisconsin
County of Racine

I, H. E. HANSEN, do hereby certify that I have surveyed
the property described above according to official records,
and that the plat above drawn is a correct representation
of said survey.

Racine, Wis., 6-2, 1961

Howard E. Hansen

RECEIVED FOR FILING
RACINE COUNTY SURVEYOR
BY Maureen A. Rosati
RECORDS

JAN 29 1975

/RC 00007

RACINE COUNTY SURVEYOR FILE NO. 4450

6201-54