

Job No. 60169

HOWARD E. HANSEN

Wisconsin Land Surveyor
1632 DOUGLAS AVENUE
RACINE, WISCONSIN


Res. Phone MEIrose 4-0565
Office Phone MEIrose 7-3346

PLAT OF SURVEY

OF PROPERTY OF THRIFTY BUILDERS INC.

described as follows: LOT #6 ROSE CREST ADDITION, CITY OF
WHITEWATER, WALWORTH COUNTY WISCONSIN

RECEIVED FOR FILING JAN 29 1975
 MACHINE COUNTY SURVEYOR
 BY Maedene A Rosato
 DEPUTY FOR RECORDS

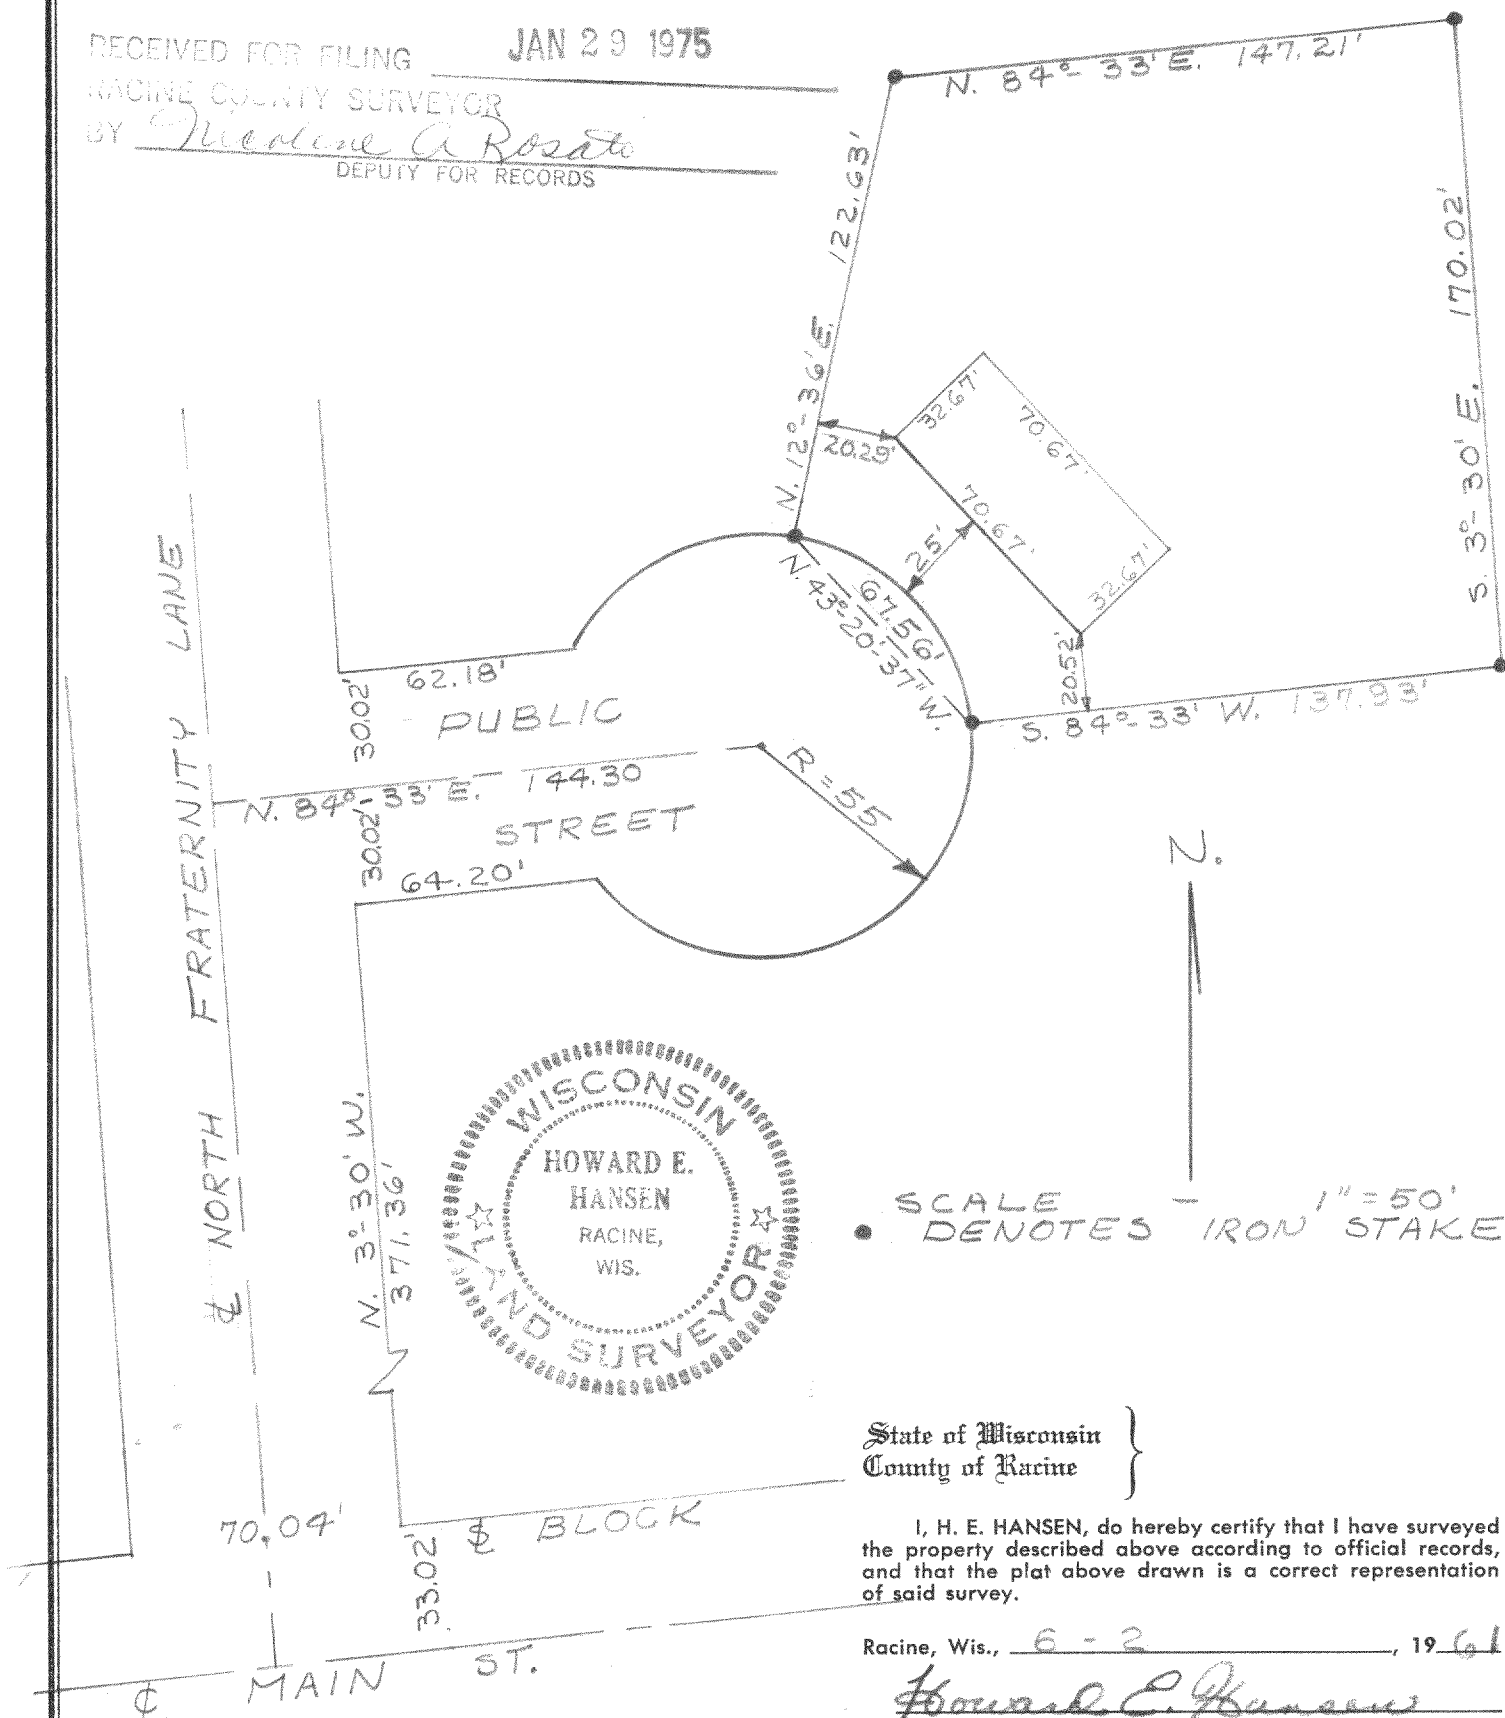

State of Wisconsin
County of Racine

I, H. E. HANSEN, do hereby certify that I have surveyed the property described above according to official records, and that the plat above drawn is a correct representation of said survey.

Racine, Wis., 6 - 2, 1961

Howard E. Hansen

12C 00006

MACHINE COUNTY SURVEYOR FILE NO. 4447

415-1031