


Tax Parcel
DW 3400004



Tax Parcel
DW 3400001

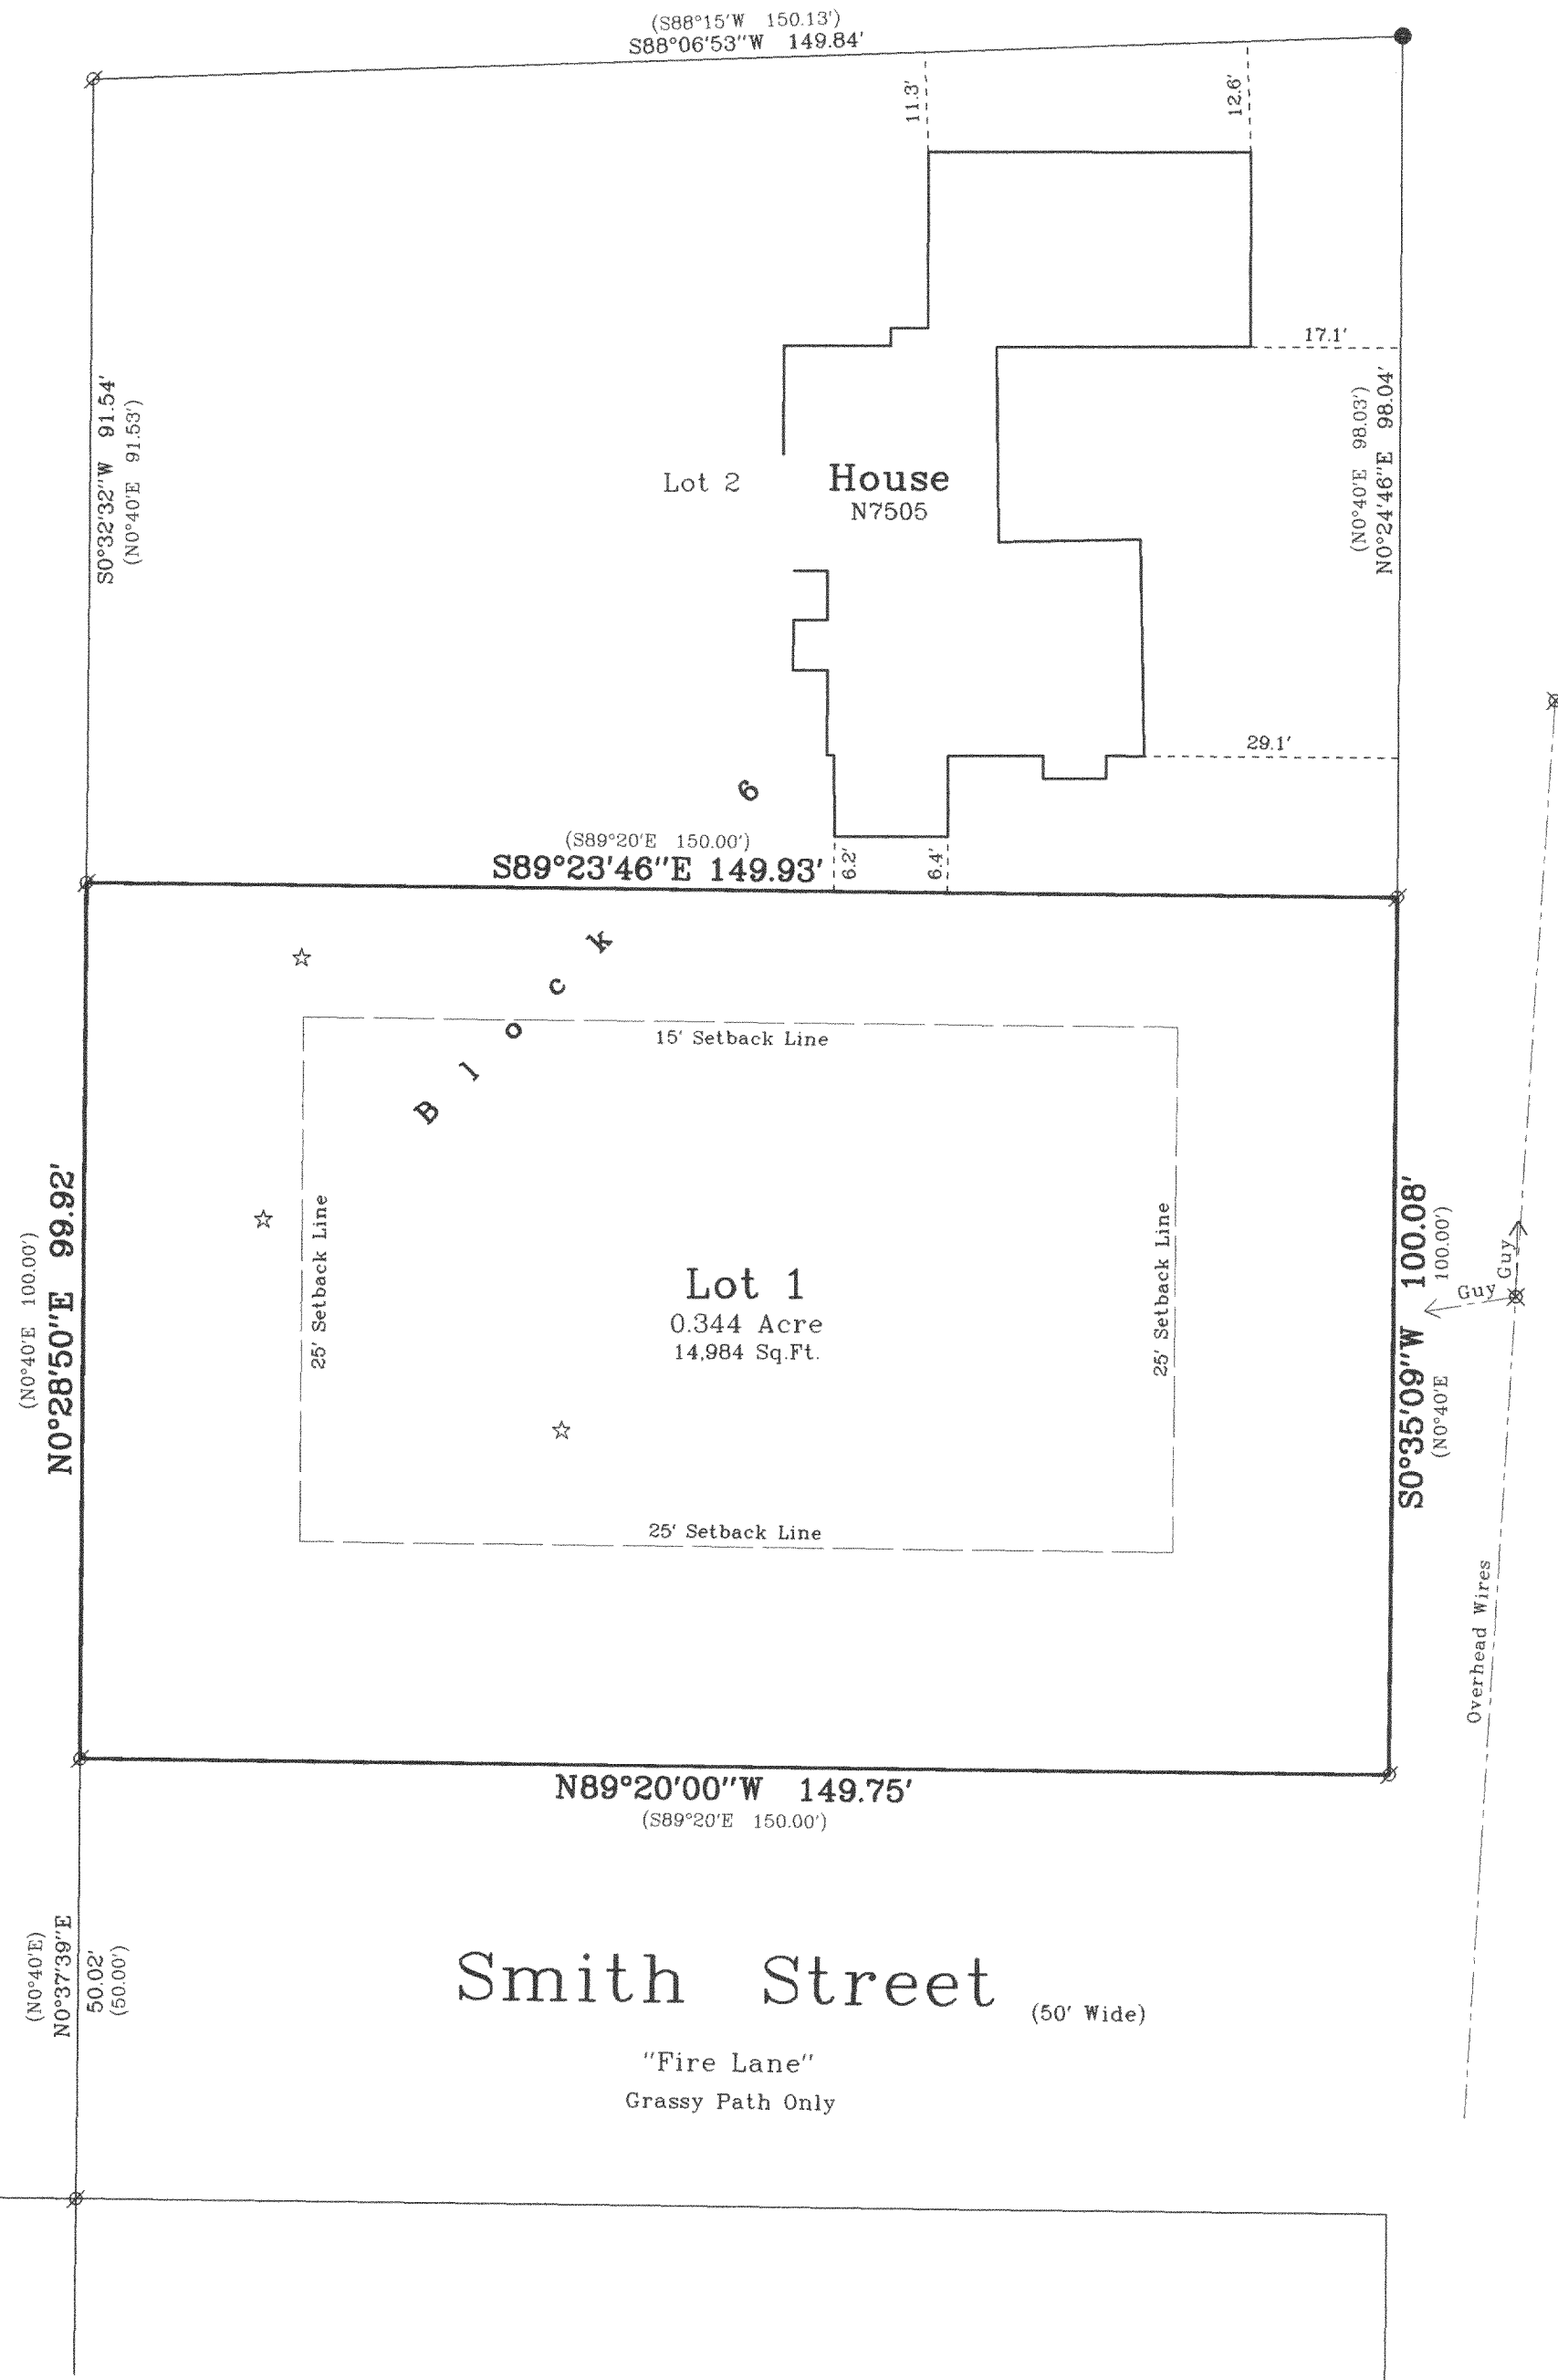

Plat of Survey

of
Lot 1 of Block 6 of Grand View Subdivision,
located in the Southeast 1/4 of Section 34, Town 4 North, Range
15 East, Town of Whitewater, Walworth County, Wisconsin.

Surveyed for: **Krol Construction, Inc.**
916 Fortress Drive
McHenry, Illinois. 60050

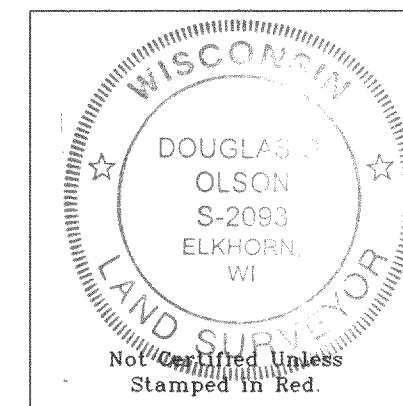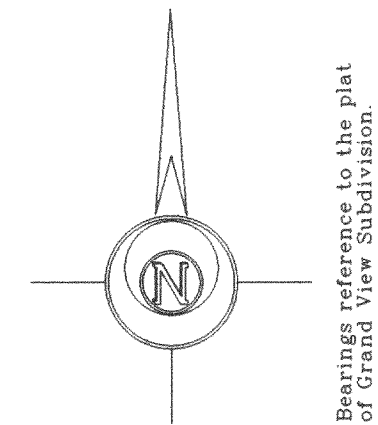

- Notes: 1) This survey plat is not certified unless signed and sealed in red ink.
- 2) This survey is subject to Wisconsin lien laws. This Plat of Survey is the notice of intent to file lien. Lien waiver required.


Copyright © 2005 by Jensen & Olson Land Surveying, LLC.

All rights reserved. No part of this survey plat may be reproduced or transmitted in any form by any means - graphic, electronic, or mechanical, including photocopying, tracing, or information storage and retrieval systems - without permission in writing from Douglas G. Olson, Jensen & Olson Land Surveying, LLC.

I, Douglas G. Olson, Wisconsin Registered Land Surveyor, do hereby certify that this survey was performed by me or under my direction in full compliance with the owner's/agent's instructions and Chapter A-E 7 of the Wisconsin Administrative Code "Minimum Standards for Property Surveys" and that this map is an accurate representation thereof to the best of my knowledge and belief.

Douglas G. Olson
Wisconsin Registered Land Surveyor - 2093

Survey Date: August 17, 2005.
Revisions:

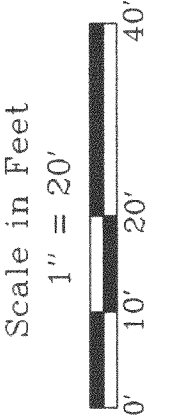

Jensen & Olson Land Surveying, LLC
45 South Wisconsin Street
Elkhorn, Wisconsin 53121
Telephone (262) 723-3434
Facsimile (262) 723-8044

- Legend
- Found Iron Pipe
 - Found Iron Rod
 - Recorded Information
 - Utility Pole
 - Soil Boring
 - Asphalt Surface

Sheet 1 of 1 Sheets
Job Reference Number
2005.113

2005.113

45-1040

DGD 00067