


PREPARED FOR:
ANDY SZYMANSKI
KEEFE REAL ESTATE, INC.
980-A N WISCONSIN ST.
ELKHORN, WI 53121

PLAT OF SURVEY

-OF-

LOT 15 OF SHEREDA WOODS SUBDIVISION, LOCATED IN THE SOUTHWEST 1/4, OF SECTION 25, TOWN 4 NORTH, RANGE 15 EAST, WALWORTH COUNTY, WISCONSIN

PATHFINDER SURVEYING INC.
N3705 WILLOWBEND LANE
LAKE GENEVA, WI, 53147
262-248-3697

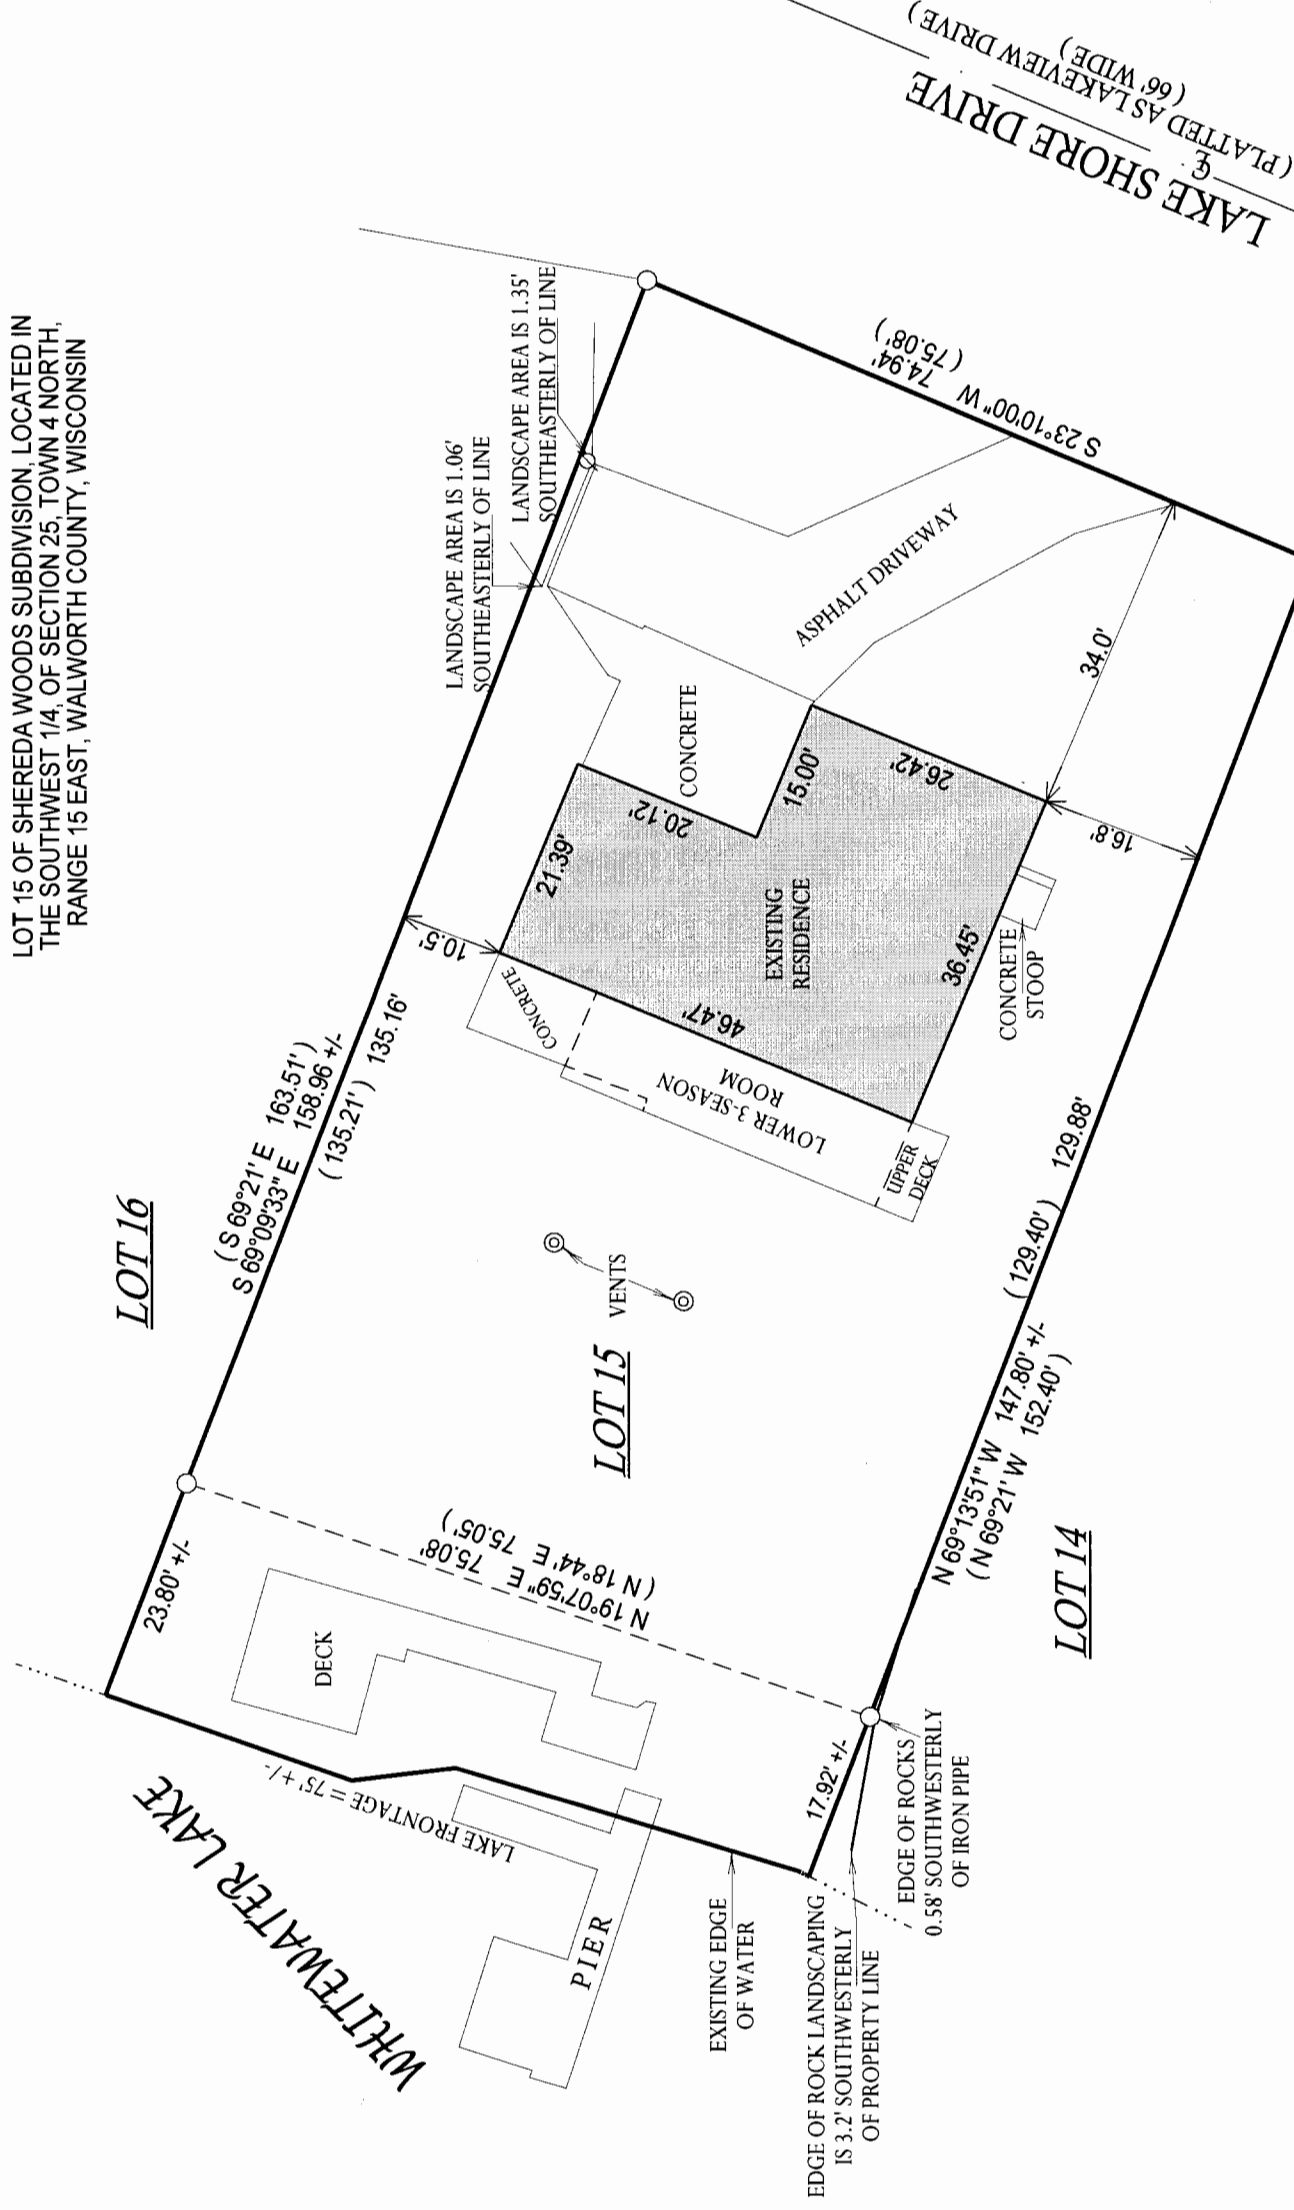

() = RECORDED AS

□ = FOUND IRON BAR

○ = FOUND IRON PIPE

● = SET IRON PIPE

 = SET IRON BAR

SCALE: 1" = 20'

JOB #: 06-188

TAX ID #: DSP 00015

NOTE: BASIS OF BEARING IS RECORD PLAT.

COMPARE LEGAL DESCRIPTION ABOVE AND DRAWING WITH DEED. FOR BUILDING RESTRICTIONS AND EASEMENTS NOT SHOWN REFER TO DEED. ABSTRACT SOURCES AND LOCAL MUNICIPAL CODES. NOTIFY THE SURVEYOR IMMEDIATELY OF ANY DISCREPANCY.

"I hereby certify that the above described property was surveyed under my supervision and that the above map, to the best of my knowledge and belief, is a true representation thereof and shows the size and location of all visible structures, apparent easements and encroachments if any." This survey is made for the present owners of the property, and those who purchase, mortgage, or guarantee the title thereto, within one year from the date hereof.

RECEIVED
JUL 28 2006
SNC

DATED THE 9th DAY OF MAY, 2006.

John C. White

JOHN KROTT S - 2258
Wisconsin Registered Land Surveyor
(original if signed in red)

45-1078