

LAND-MARK SURVEYING


Mark L. Miritz

Wisconsin Registered Land Surveyor S-2582

N9330 Knuteson Drive
Whitewater, WI 53190
Phone: (262) 495-3284
FAX : (262) 495-8421
LAND-MARKSURVEYING.COM

PLAT OF SURVEY

LOT 29, BLOCK 2 OF INDIAN TRAIL SUBDIVISION,
LOCATED IN THE NORTHWEST 1/4 OF THE SOUTHWEST
1/4 OF SECTION 26 AND THE NORTHEAST 1/4 OF THE
SOUTHEAST 1/4 AND THE SOUTHEAST 1/4 OF THE
SOUTHEAST 1/4 OF SECTION 27, TOWN 4 NORTH,
RANGE 15 EAST, WHITEWATER TOWNSHIP,
WALWORTH COUNTY, WISCONSIN.

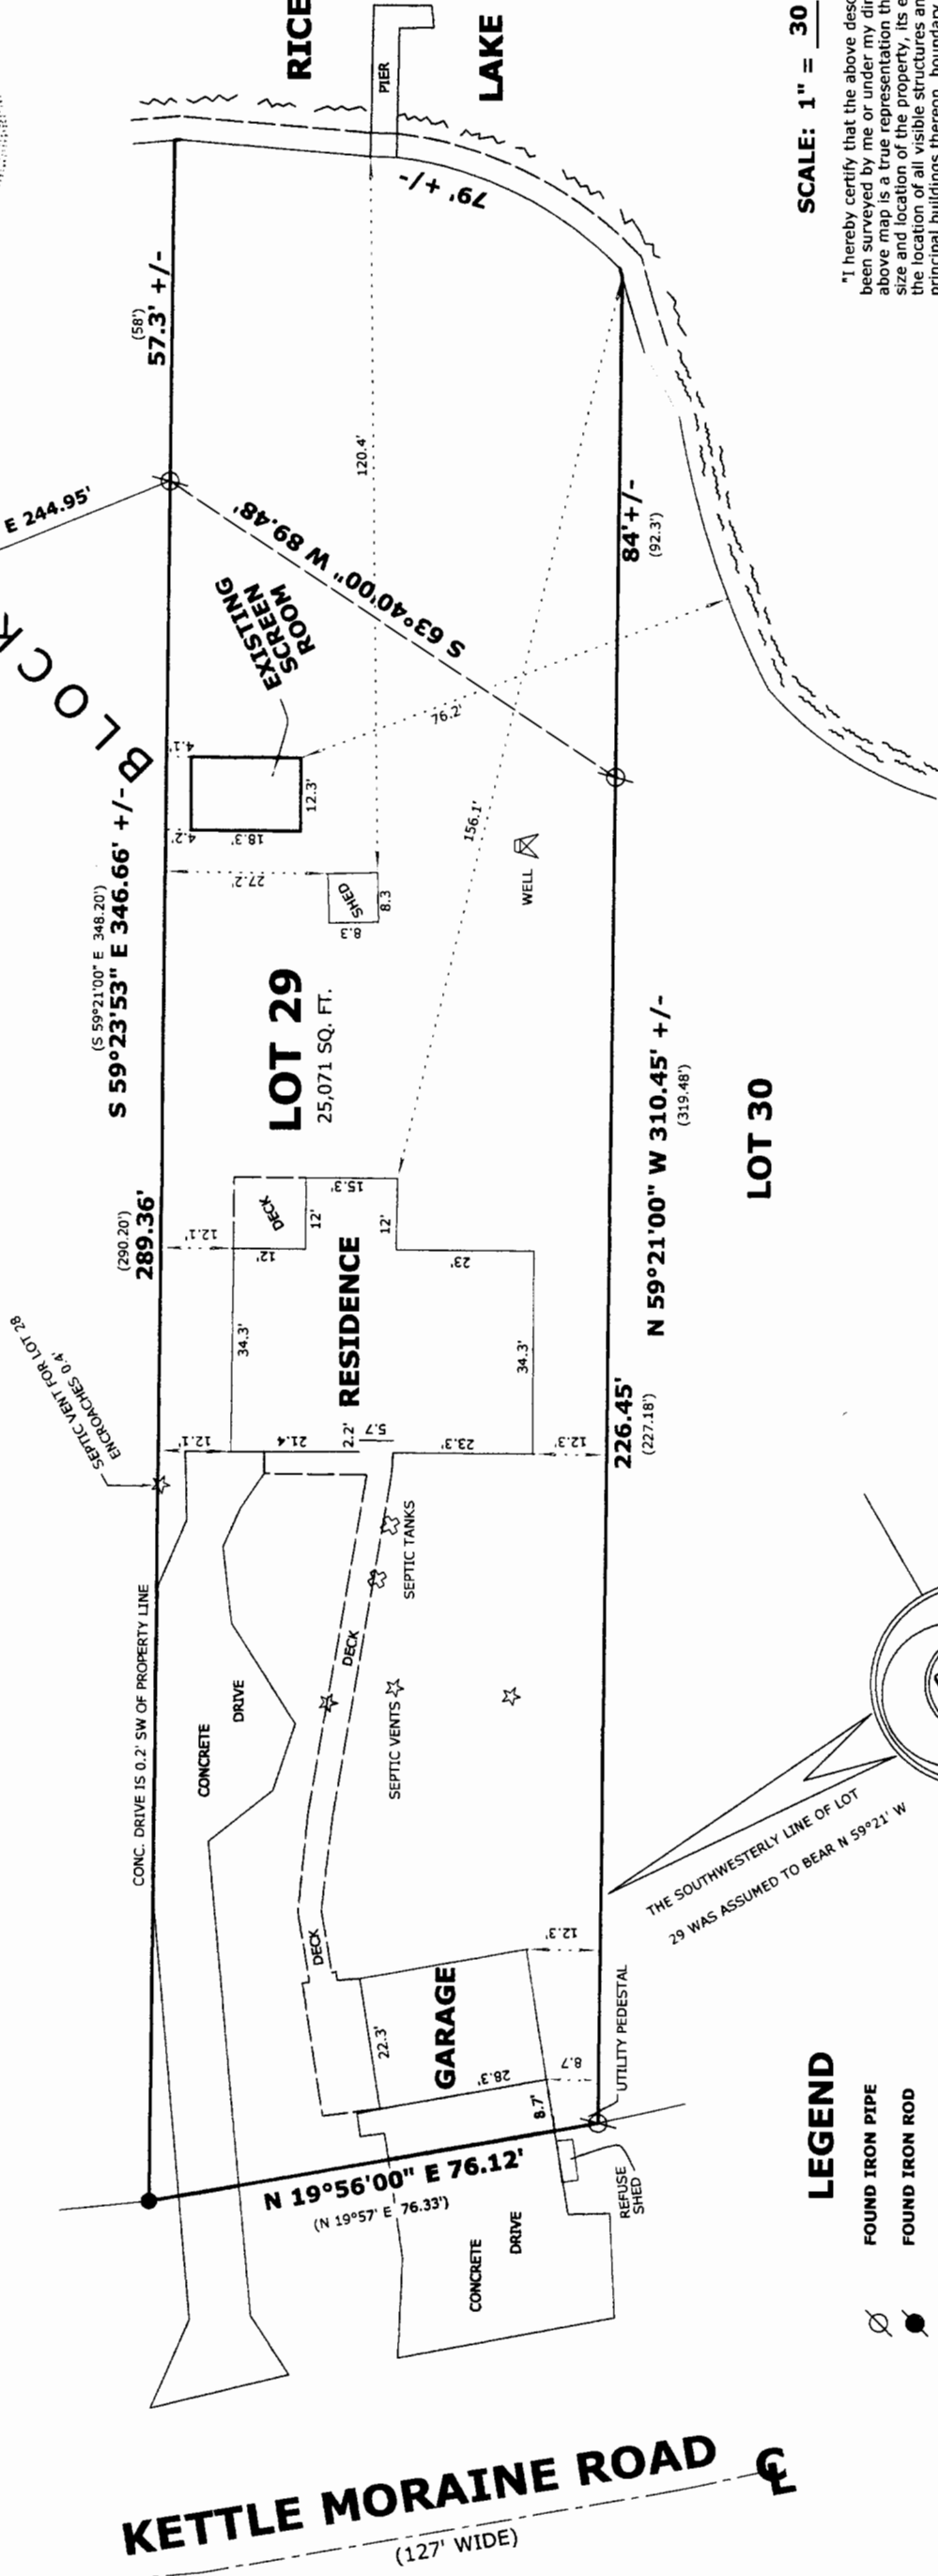

LEGEND

- FOUND IRON PIPE
- FOUND IRON ROD
- FOUND COUNTY MONUMENT
- FOUND CONCRETE MONUMENT
- CHISEL CUT IN CONCRETE
- SET IRON ROD, 24" LONG, WEIGHING 1.5 LBS./LINEAL FT., 3/4" DIA.
- RECORDED AS DIMENSION
- EXISTING FENCE

OWNERS: MICHAEL & JENNIFER ORGAN
N7752 N. KETTLE MORaine DR.
WHITEWATER, WI 53190

REVISED MAY 21, 2006
TO SHOW ALTERED CONC. DRIVE
REVISED AUGUST 20, 2004
TO SHOW SCREEN ROOM "AS BUILT"

MARK L. MIRITZ
WISCONSIN REGISTERED
LAND SURVEYOR S-2582

DATE: APRIL 25, 2004 JOB NO. 04.405

DITS - 53

415-1079