


PLAT OF SURVEY

LEGAL DESCRIPTION:
LOT 10, BLK. 1, CHAPEL HILLS SUB.

REQUESTED BY: EARNEST J. ROY

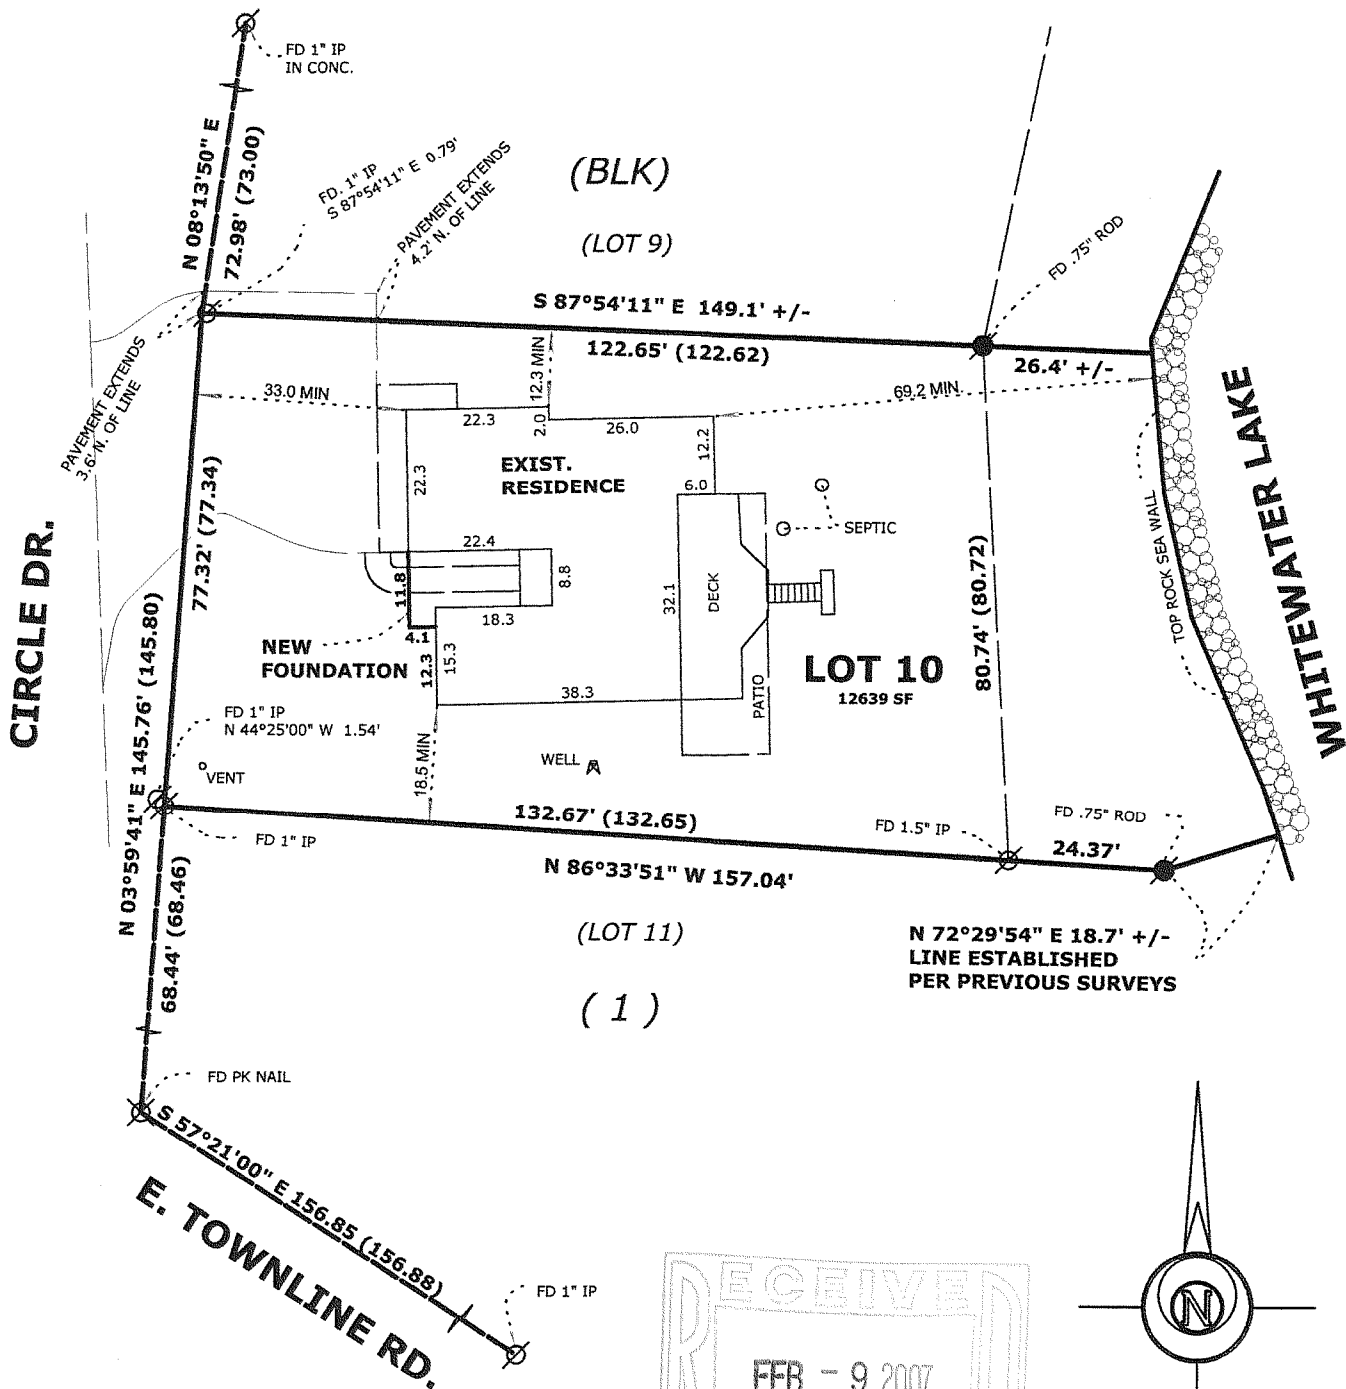

SURVEYOR'S CERTIFICATE:
I JAMES K. LANGONE, REGISTERED LAND SURVEYOR, CERTIFY THAT
I HAVE SURVEYED THE PROPERTY DESCRIBED HEREON AND THAT THIS
PLAT IS A TRUE AND CORRECT REPRESENTATION OF THE BOUNDARIES
THEREOF.

DATE: 2/5/07
JAMES K. LANGONE
REGISTERED LAND SURVEYOR S-1347

AS-BUILT 2/05/07

RE-CERTIFICATION OF SURVEY DATED 04/29/03.
REVISED TO PROVIDE ADDITIONAL DATA FOR
USE AS PLOT PLAN. 9/28/06

JAMES K. LANGONE
LAND SURVEYS & CIVIL ENGINEERING
5 Coburn Ln. Whitewater, WI. 53190 (262) 473-4119

BASIS OF BEARINGS:
THE N'LY LINE OF TOWNLINE RD.
BEING S 57°21'00" E

NOTES:

- (XX) INDICATES RECORD DATA
- ⊗ INDICATES FOUND IRON PIPE
- ⊙ INDICATES FOUND IRON ROD
- ⊕ INDICATES FOUND PK NAIL

