


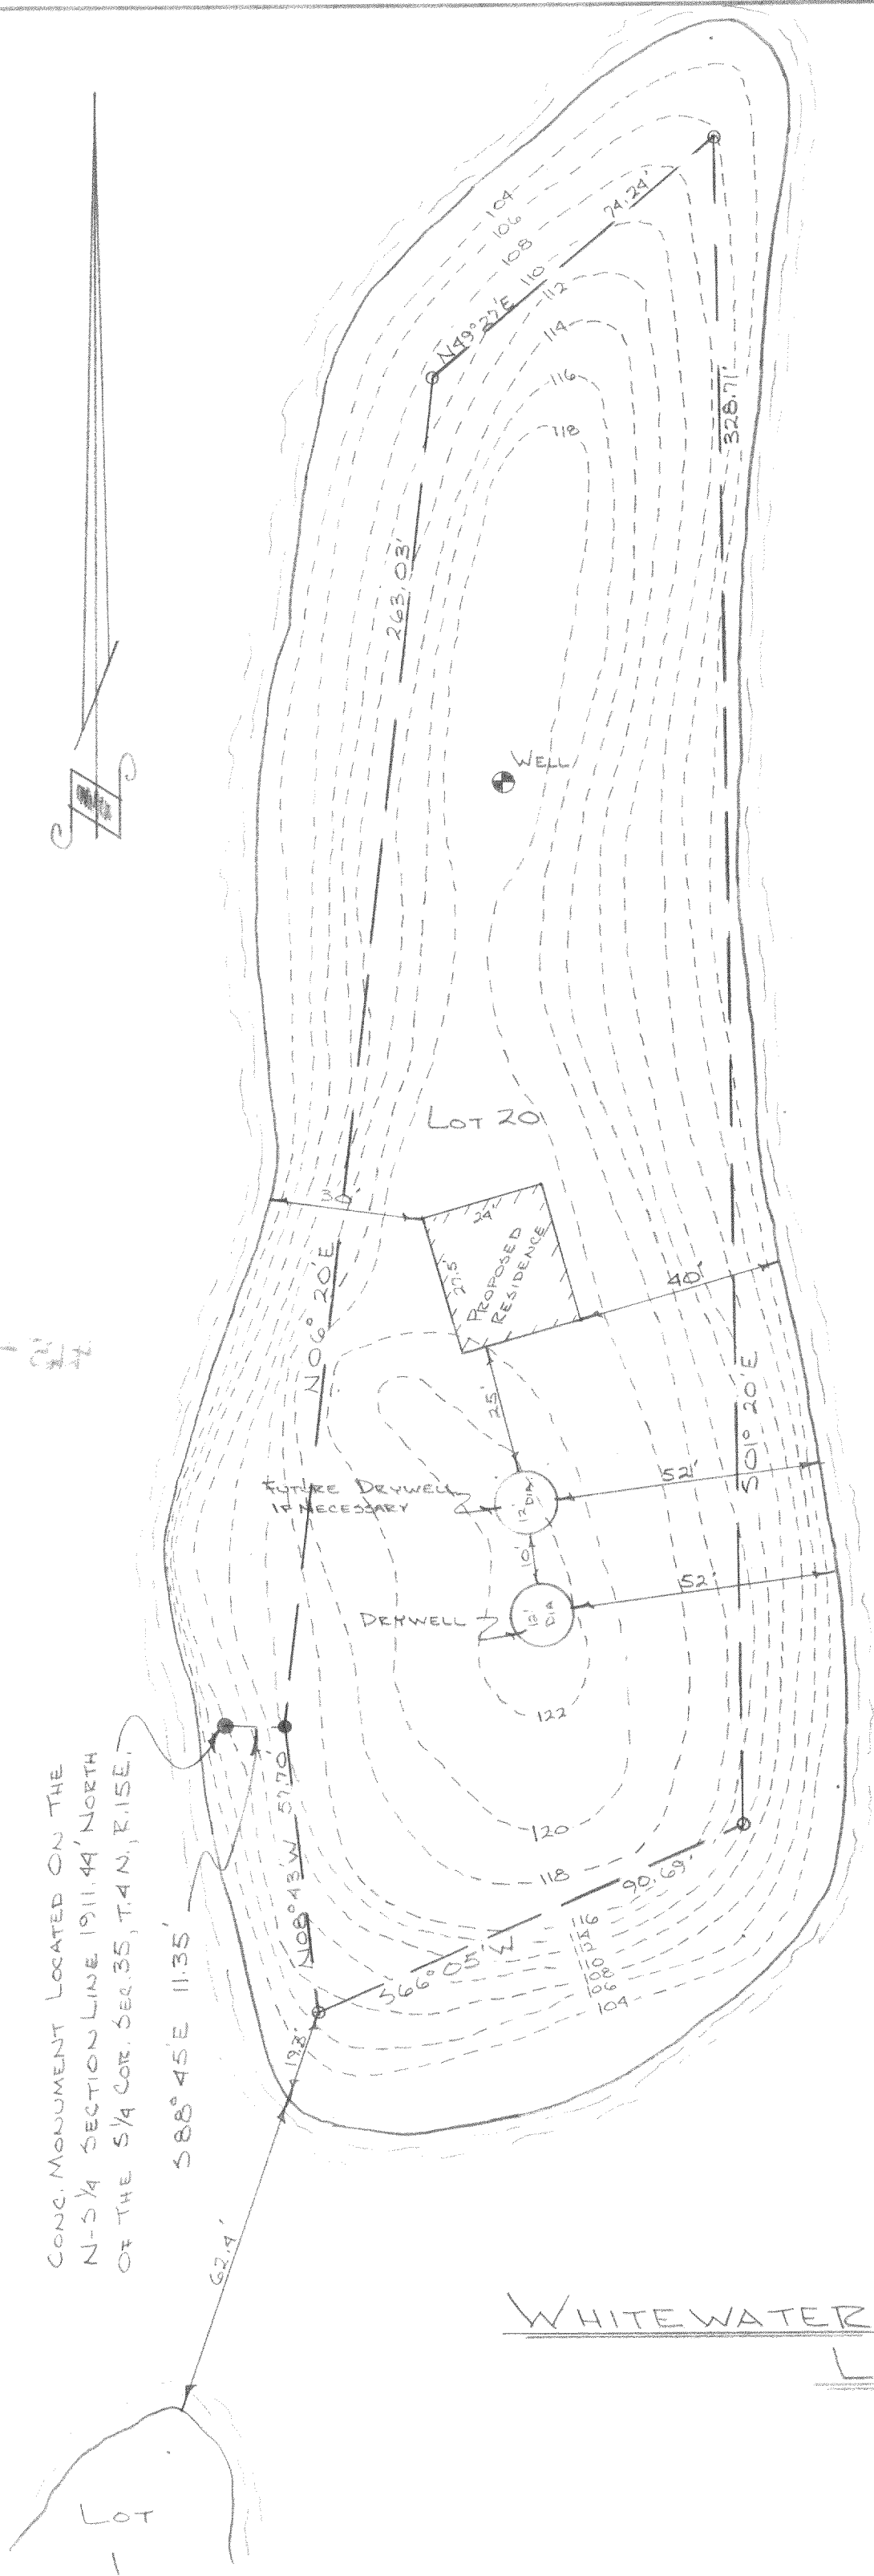

DESCRIPTION:

Lot number Twenty (20) of Thorne Heights Subdivision located in the South $\frac{1}{2}$ of Section 35, T.4N., R.15E., Walworth County, Wisconsin.

CERTIFICATE:

I, Joseph M. Biagi, surveyor, do hereby certify that I have surveyed the property hereon described.

Joseph M. Biagi
Joseph M. Biagi RLS #12

April 8, 1973

LEGEND

- - INDICATES IRON PIPE FOUND
- - INDICATES IRON PIPE SET
- - INDICATES CONCRETE MONUMENT

WHITEWATER
LAKE