


FARRIS, HANSEN & ASSOCIATES, INC.
ENGINEERING — ARCHITECTURE — SURVEYING
7 RIDGWAY COURT P.O. BOX 437
ELKHORN, WISCONSIN 53121
OFFICE: (262) 723-2098 FAX: (262) 723-5886


REVISIONS

PROJECT NO.	7428
DATE:	11-12-07
SHEET NO.	1 OF 1

LOCATED IN THE SE 1/4 SECTION 35
TOWN 4 NORTH, RANGE 15 EAST
WALWORTH COUNTY, WISCONSIN

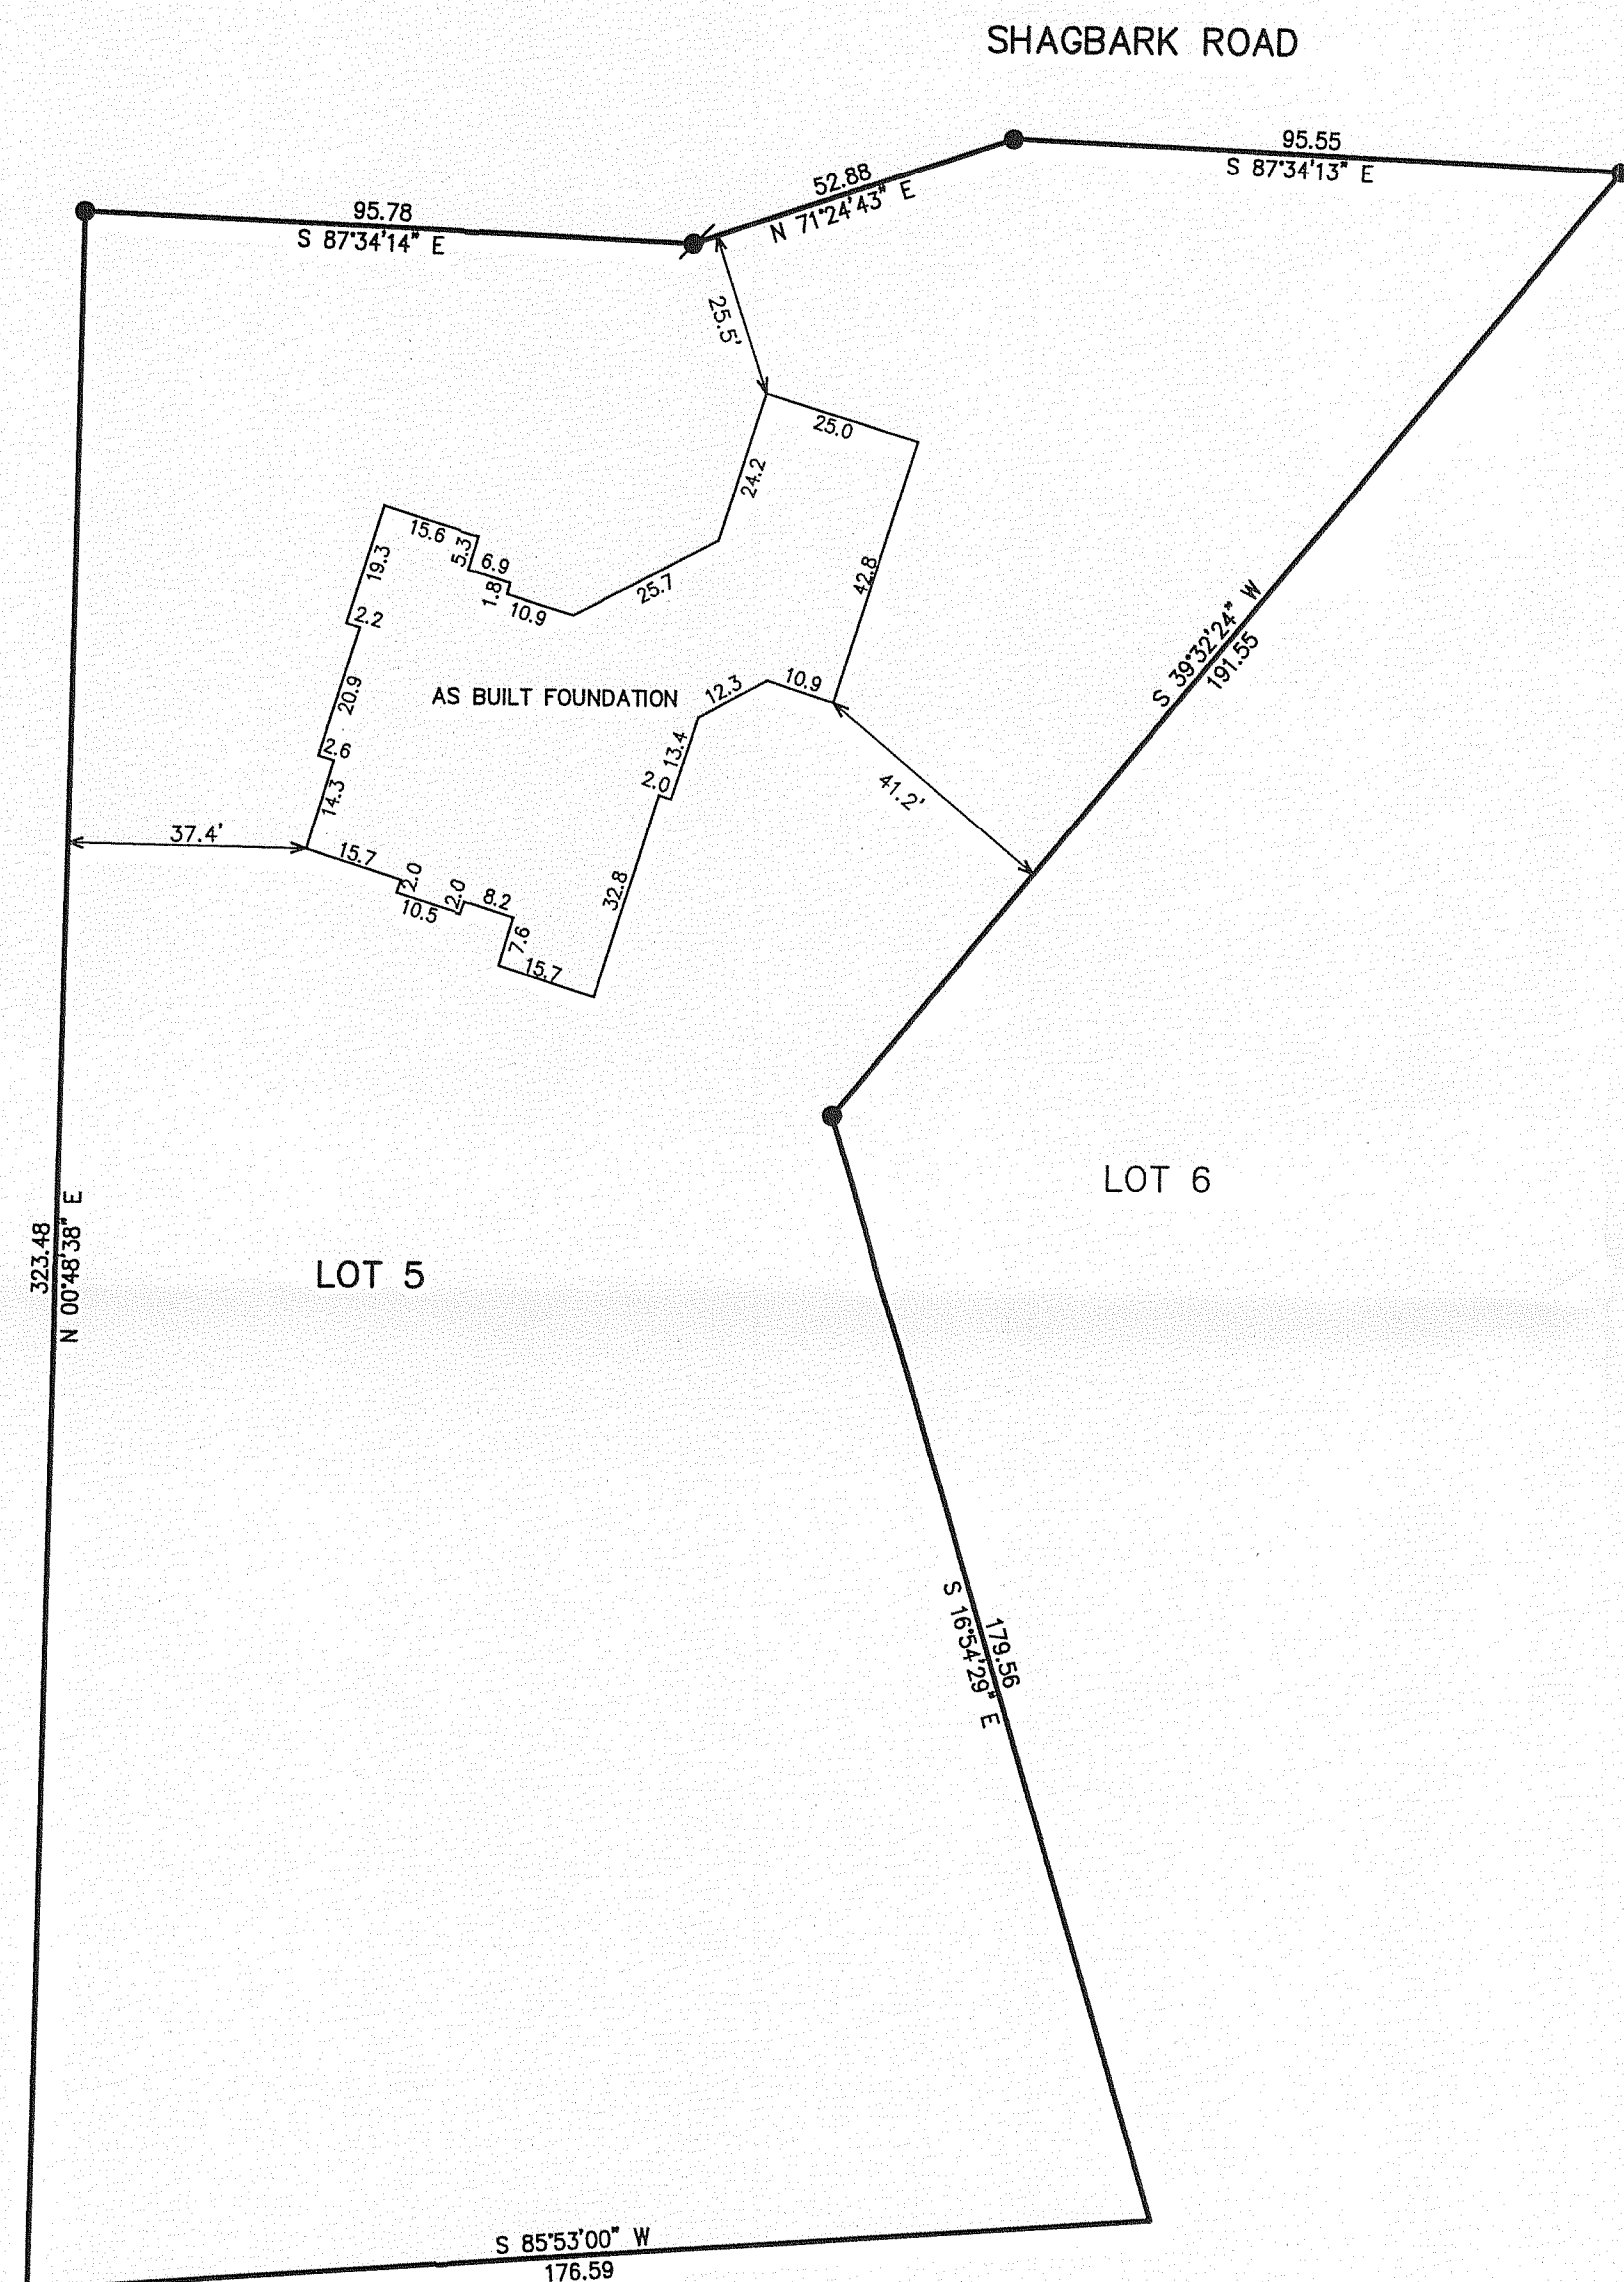

- = FOUND IRON REBAR STAKE
 ●/ = SET IRON REBAR STAKE

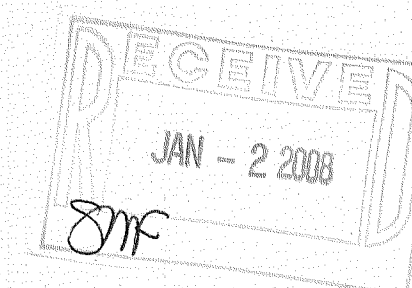

NOTE: COPIES OF THIS MAP TO WHICH THE FOLLOWING CERTIFICATE WILL APPLY SHOW SURVEYOR'S ORIGINAL SEAL AND SIGNATURE IN RED INK. COPIES BY ANY OTHER MEANS MAY HAVE ALTERATIONS WHICH DO NOT REPRESENT THE SURVEYOR'S WORK PRODUCT.

I HEREBY CERTIFY THAT THIS MAP IS A TRUE AND ACCURATE REPRESENTATION OF THE LOCATION OF THE AS BUILT FOUNDATION IN RELATION TO THE MONUMENTS FOUND AND SHOWN REPRESENTING THE NORTHERLY AND EAST CORNERS TO THE BEST OF MY PROFESSIONAL KNOWLEDGE AND BELIEF. THE SURVEYED BOUNDARY INFORMATION SHOWN IS IN RELATION TO A PLAT OF SURVEY OF THE SUBJECT LOT BY PATHFINDER SURVEYING DATED APRIL 10, 2007. NOTE THIS IS NOT A PLAT OF SURVEY AS DEFINED IN CHAPTER A-E 7 OF WISCONSIN ADMINISTRATIVE CODE

DATED: NOVEMBER 12, 2007


PETER S. GORDON RLS 2101

MAP SCALE IN FEET ORIGINAL 1" = 30'

11/12/2007 X:\Projects\7428\dcad\asbuilt.

214

DSO - 5

415-1145