

LAND-MARK SURVEYING

Mark L. Miritz



Wisconsin Registered Land Surveyor S-2582

N9330 Knuteson Drive
Whitewater, WI 53190
Phone: (262) 495-3284
FAX : (262) 495-8421
LAND-MARKSURVEYING.COM

PLAT OF SURVEY

LOT 20, BLOCK 2, MORaine HEIGHTS SUBDIVISION,
LOCATED IN THE NORTHWEST 1/4 OF SECTION 35,
TOWN 4 NORTH, RANGE 16 EAST, WHITEWATER
TOWNSHIP, WALWORTH COUNTY, WISCONSIN.

OWNERS: JAMES F. HOLDERMAN
PAULA H. HOLDERMAN
915 COUNTRY CLUB DR.
LAGRANGE, IL 60525

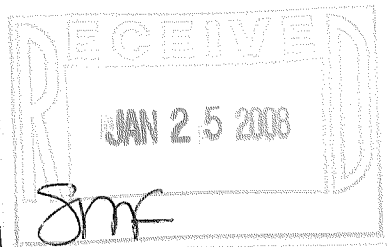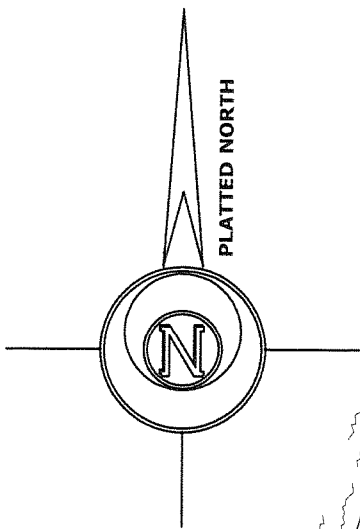

WHITEWATER LAKE

BLOCK 2

LOT 19

LOT 20
9,318 SQ. FT.

RIDGE ROAD

50' WIDE

SOUTH 75.00'

LOT 21

LEGEND



FOUND IRON PIPE

(x x)

RECORDED AS DIMENSION

SCALE: 1" = 20 FEET

"I hereby certify that the above described property has been surveyed by me or under my direction and that the above map is a true representation thereof and shows the size and location of the property, its exterior boundaries, the location of all visible structures and dimensions of all principal buildings thereon, boundary fences, apparent easements, roadways and visible encroachments, if any."

"This survey is made for the use of the present owners of the property, and also those who purchase, mortgage, or guarantee the title thereto within one year from date hereof."

Mark L. Miritz
MARK L. MIRITZ
WISCONSIN REGISTERED
LAND SURVEYOR S-2582

DATE: NOV. 29, 2007 JOB NO. 07.1106

RESIDENCE SHOREYARD SETBACK LOT 19 = 45.7'
RESIDENCE SHOREYARD SETBACK LOT 21 = 41.1'
AVERAGE SHOREYARD SETBACK = 43.4'



DMH-54

415-1118