



PLAT OF SURVEY

ERSV
ENGINEERING, INC.
Engineers-Land Surveyors-Environmental Scientists
4201 175TH AVE. S.W. • 516 2540 • W 55103 1-202-862-4703

FOR: MARK W. SONNEBORN

DATE: 10/08/2007


DESCRIPTION:
ALL OF LOT 5, BLOCK 1, MORaine HEIGHTS SUBDIVISION, LOCATED IN THE SOUTHEAST 1/4 OF SECTION 26,
TOWNSHIP 4 NORTH, RANGE 15 EAST, TOWN OF WHITEWATER, WALWORTH COUNTY, WISCONSIN.

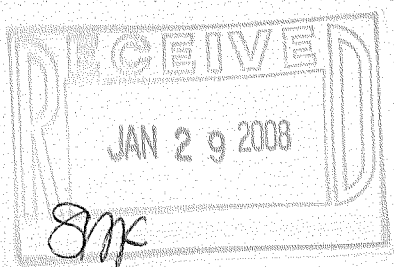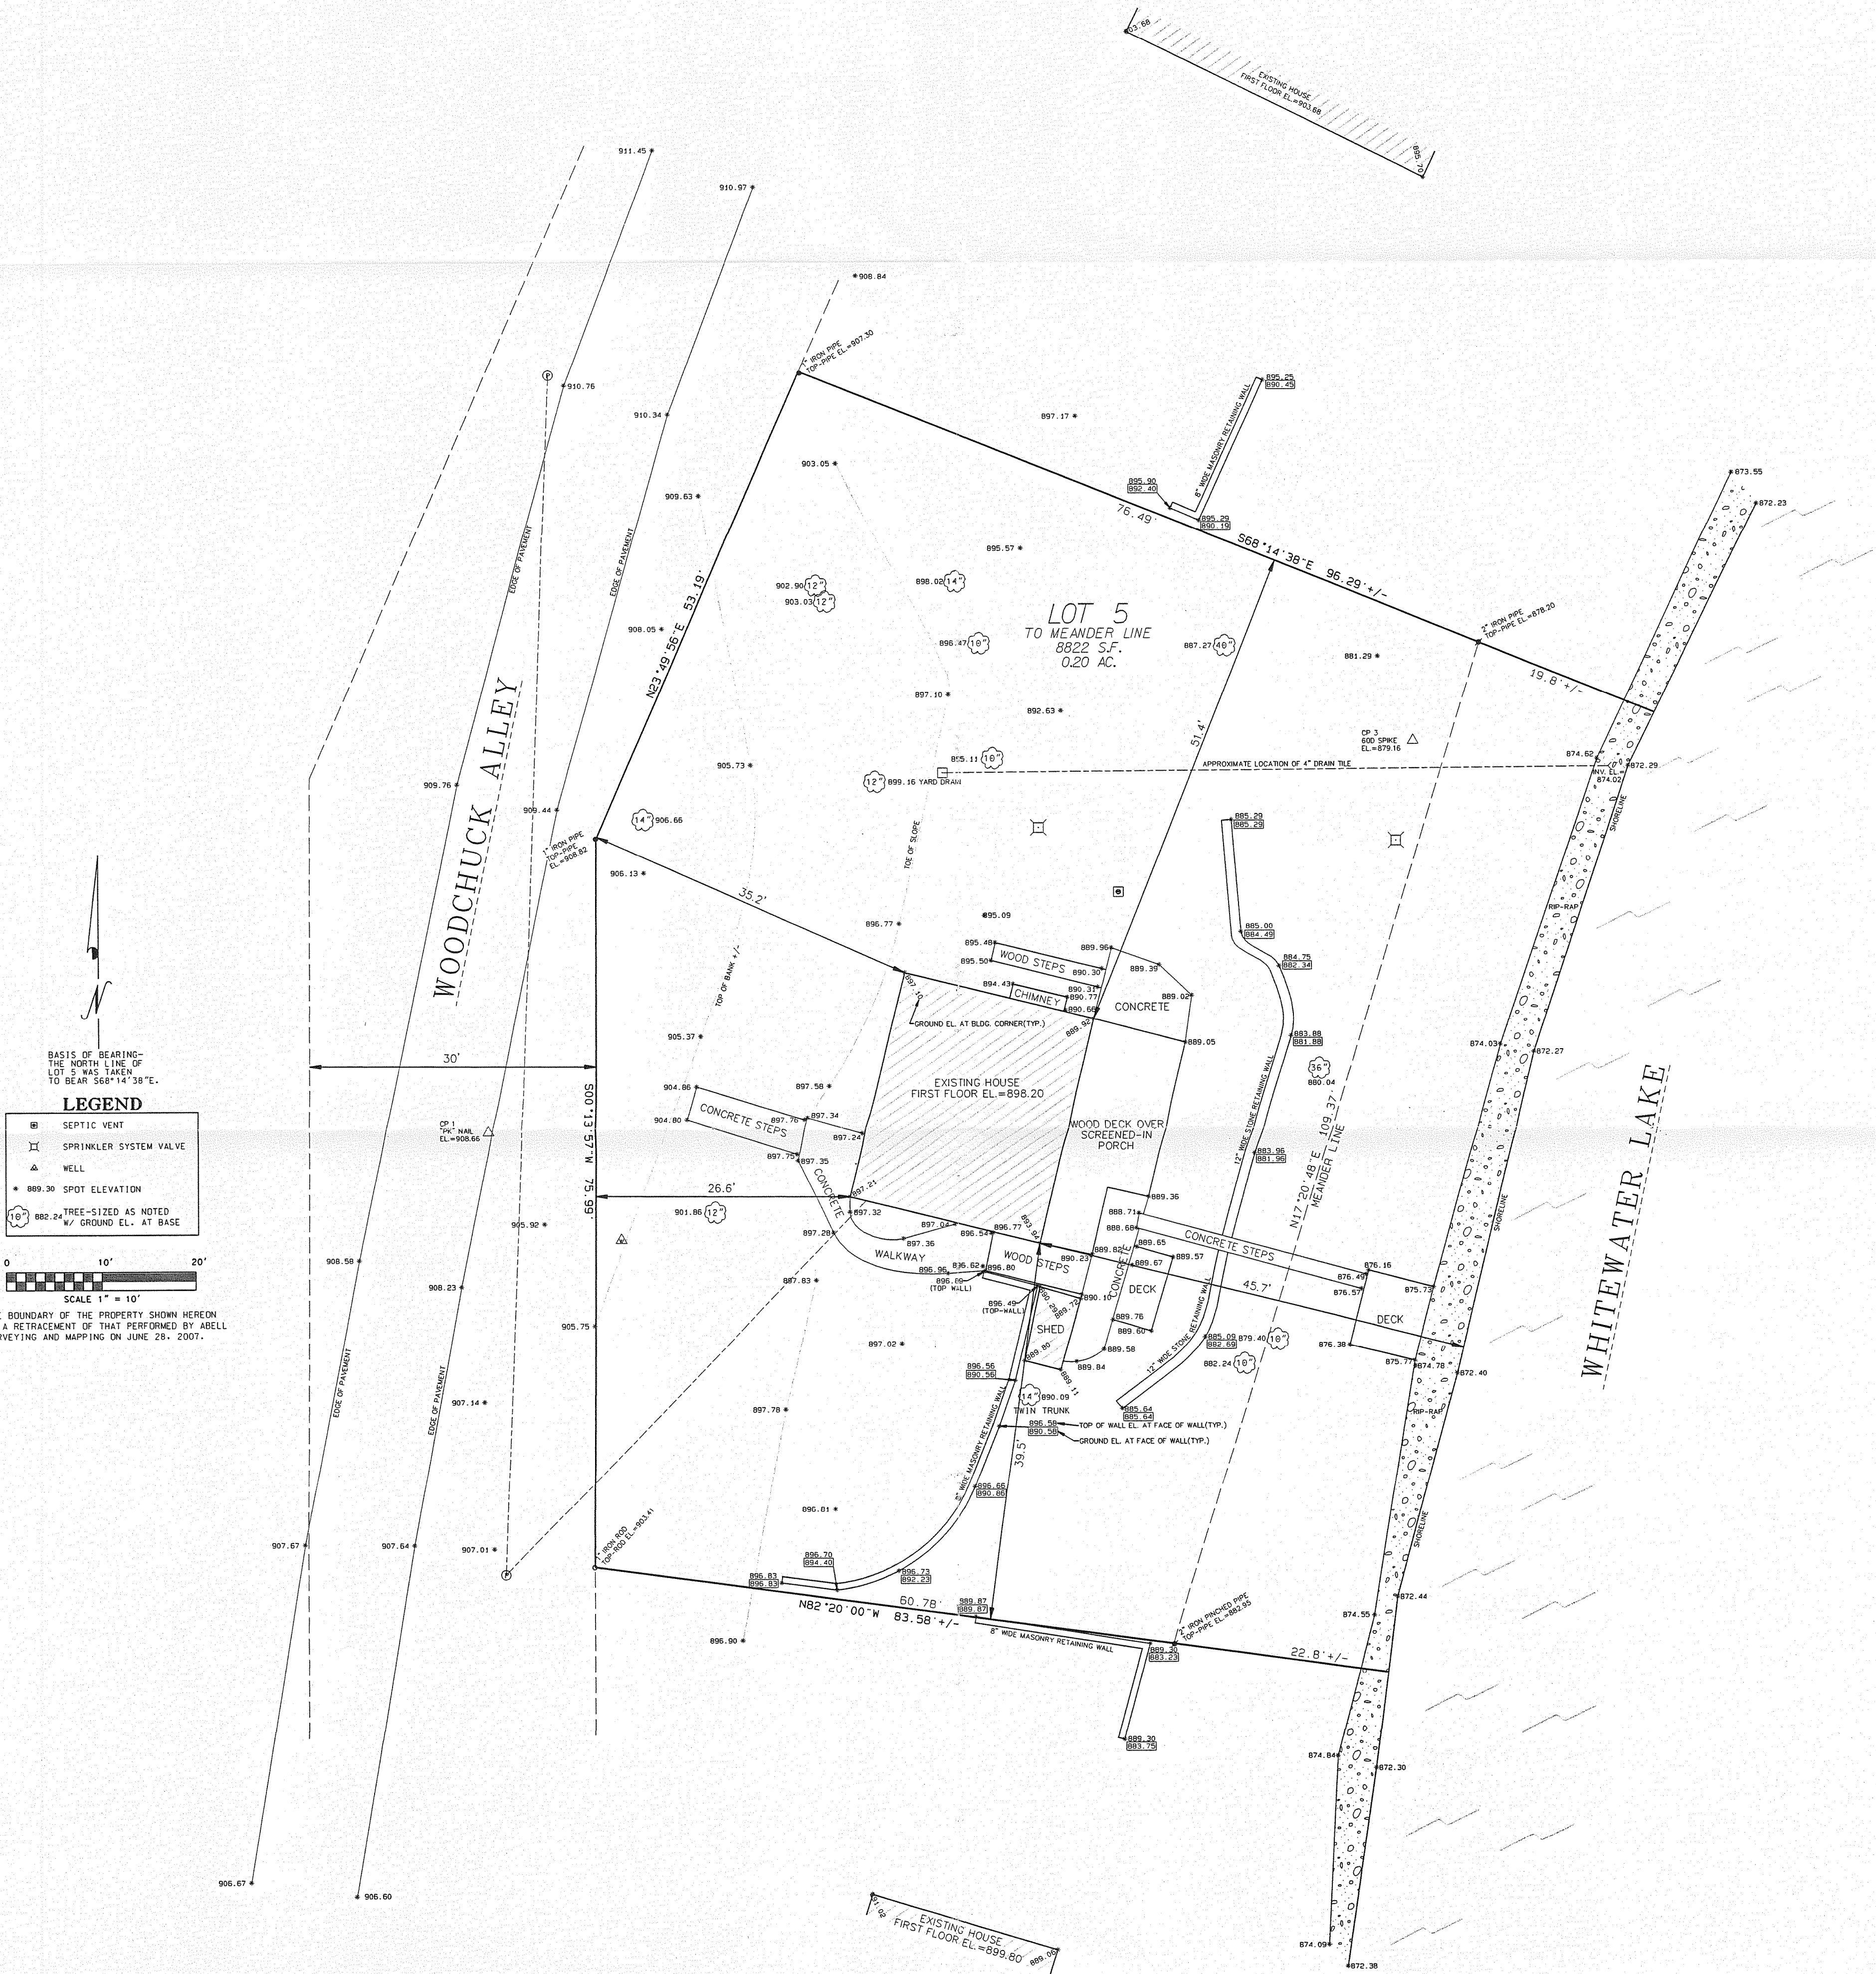

I, KENNETH B. MEHRING, R.L.S., # 2838 HEREBY CERTIFY THAT I HAVE SURVEYED THE ABOVE DESCRIBED PROPERTY AND THE ABOVE MAP IS A TRUE REPRESENTATION THEREOF AND SHOWS THE SIZE AND LOCATION OF THE PROPERTY, ITS EXTERIOR BOUNDARIES, THE LOCATION OF ALL STRUCTURES THEREON, FENCES, APPARENT EASEMENTS AND ROADWAYS AND VISIBLE ENCROACHMENTS, IF ANY.

THIS SURVEY IS MADE FOR THE EXCLUSIVE USE OF THE PRESENT OWNERS OF THE PROPERTY, AND ALSO THOSE WHO PURCHASE, MORTGAGE OR INSURE THE TITLE THEREIN WITHIN ONE (1) YEAR FROM DATE HEREOF, AND AS TO THEM I WARRANT THE ACCURACY OF SAID SURVEY MAP.

Kenneth B. Mehring
KENNETH B. MEHRING, R.L.S., # 2838
RSV# 07-134

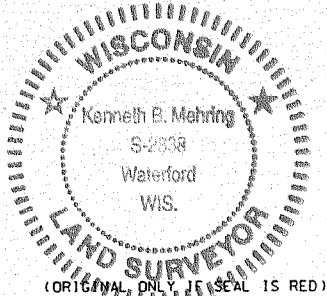

DMH-5

415-1151