

W H I T E W A T E R

LAKE ELEVATION 72.23' ON 6/11/08

L A K E

ABELL
SURVEYING & MAPPING
1140 SEQUOIA STREET • DELAVAN, WISCONSIN 53115
262-728-6737


LOT 19

LOT 20
AREA 0.22 ACRES ±

R O A D


R I D G E

AS TRAVELED

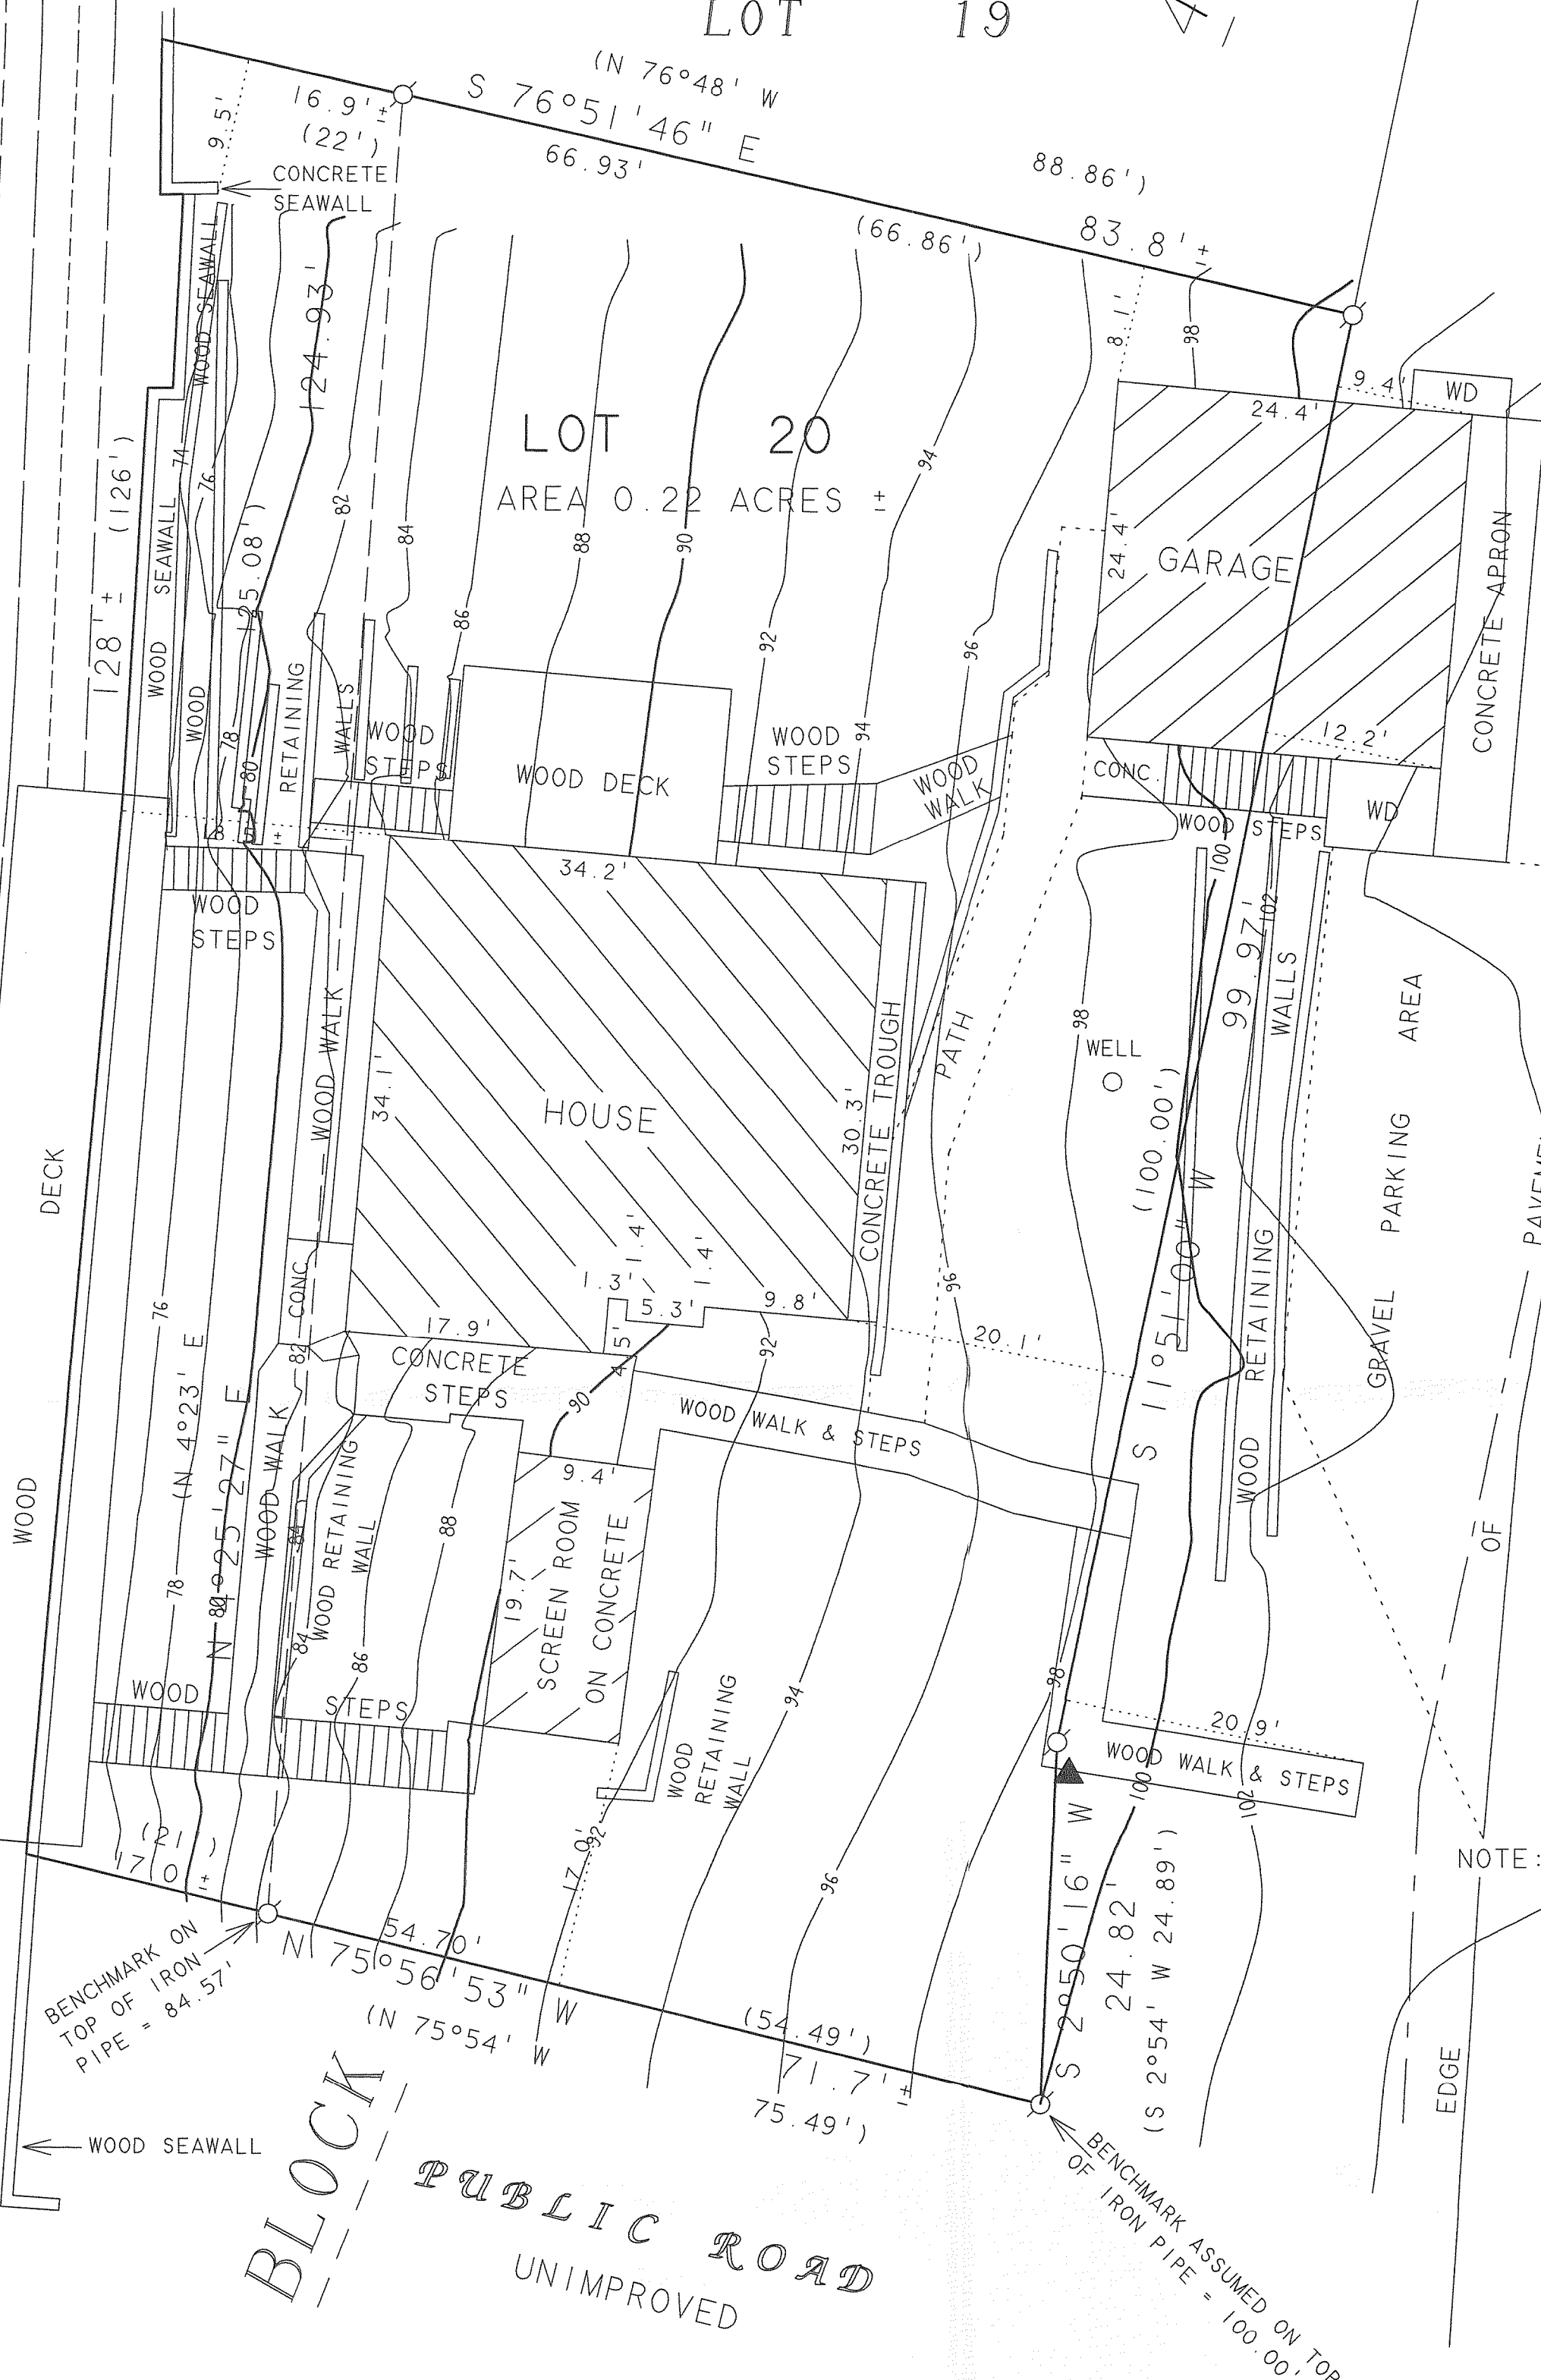

NOTE: BEARINGS ARE REFERENCED TO THE RECORDED SUBDIVISION PLAT.

N

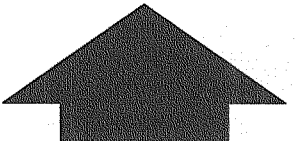


SCALE 1" = 10'

LEGEND

- - IRON PIPE FOUND
- WD - WOOD DECK
- ▲ - LAMP POST
- () - RECORDED AS

TOPOGRAPHIC SURVEY OF

LOT 20, BLOCK 4, MORAIN HEIGHTS, LOCATED
IN T4N R15E, WALWORTH COUNTY, WISCONSIN.

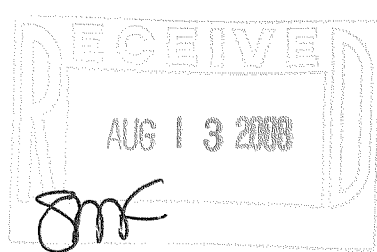

I, DAVID F. ABELL, DO HEREBY CERTIFY THAT I HAVE SURVEYED THE PROPERTY HEREON DESCRIBED ACCORDING TO THE OFFICIAL RECORDS AND THAT THE PLAT HEREON IS A CORRECT REPRESENTATION OF THE PROPERTY LINES TO THE BEST OF MY KNOWLEDGE AND BELIEF.
David F. Abell
DAVID F. ABELL
WISCONSIN REGISTERED LAND SURVEYOR, S-1596

ORDERED BY: BILL HENRY
KEHOE-HENRY & ASSOCIATES, INC.
32 S. WISCONSIN STREET
ELKHORN, WI 53121

June 24, 2008
DATE
NOTE: THIS IS NOT A CERTIFIED COPY UNLESS SEALED.
JOB NUMBER - 94070E

DMH - 102

415-1164