

County Trunk Highway P


Plat of Survey

of

Lot 2 of Certified Survey Map No. 3543,

recorded in Vol. 21 of Certified Survey Maps of Walworth County on Page 9 and located in the Southwest 1/4 of Section 36, Town 4 North, Range 15 East, Town of Whitewater, Walworth County, Wisconsin.

Surveyed for: **Kevin Keltesch**
N6549 County Hwy P
Delavan, Wisconsin. 53115.

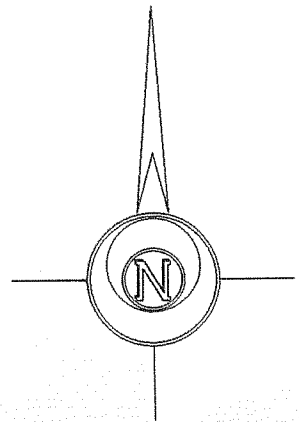

Bearings reference to Certified Survey Map No. 3543.

Lot 1
C.S.M. 3543

(N0°01'00"W 400.20')
N0°00'49"W 400.25'


Tax Parcel
DW 3600006C

(N88°11'00"E 295.50')
N88°11'24"E 295.55'

Lot 2
2.714 Acres
118,231 Sq.Ft.

Tax Parcel
DW 3600006

(S0°01'00"E 400.20')
S0°00'48"E 400.21'

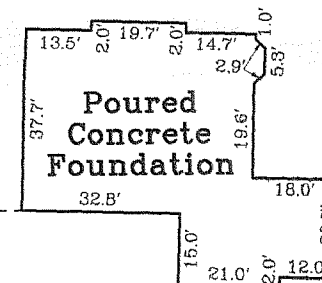

(S88°11'00"W 505.00')
S88°11'00"W 295.50'
S88°11'00"W 295.55'

Lot 4
C.S.M. 3543

66' Wide Ingress & Egress Easement Area
As shown on C.S.M. 3543.

S88°11'00"W 295.55'
(S88°11'00"W 295.50')



Lot 4
C.S.M. 3543

Copyright © 2008 by Jensen & Olson Land Surveying, LLC.

All rights reserved. No part of this survey plat may be reproduced or transmitted in any form by any means - graphic, electronic, or mechanical, including photocopying, tracing, or information storage and retrieval systems - without permission in writing from Douglas G. Olson, Jensen & Olson Land Surveying, LLC.

I, Douglas G. Olson, Wisconsin Registered Land Surveyor, do hereby certify that this survey was performed by me or under my direction in full compliance with the owner's/agent's instructions and Chapter A-E 7 of the Wisconsin Administrative Code "Minimum Standards for Property Surveys" and that this map is an accurate representation thereof to the best of my knowledge and belief.

Douglas G. Olson
Wisconsin Registered Land Surveyor - 2093

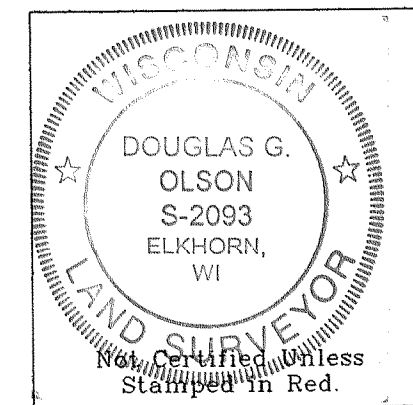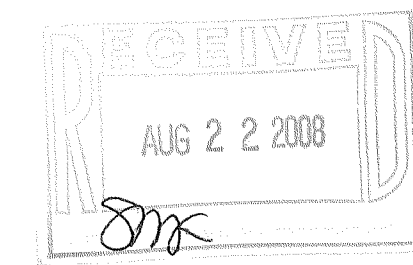

Notes:

- 1) This survey plat is not certified unless signed and sealed in red ink.
- 2) This survey is subject to Wisconsin lien laws. This Plat of Survey is the notice of intent to file lien. Lien waiver required.

Survey Date: February 8, 2008.
Revisions: No. 1 - Foundation

Scale in Feet
1" = 40'
0' 20' 40' 80'

Jensen & Olson Land Surveying, LLC

45 South Wisconsin Street P.O. Box 322
Elkhorn, Wisconsin. 53121
Telephone (262) 723-3434
Facsimile (262) 723-8044

Legend
☒ Found Iron Pipe
☒ Recorded Information
☒ Utility Pedestal
☒ Utility Box
☒ Gravel Surface

Sheet 1 of 1 Sheets
Job Reference Number
2008.016

2008.016

DA 3543-2

415-1169