



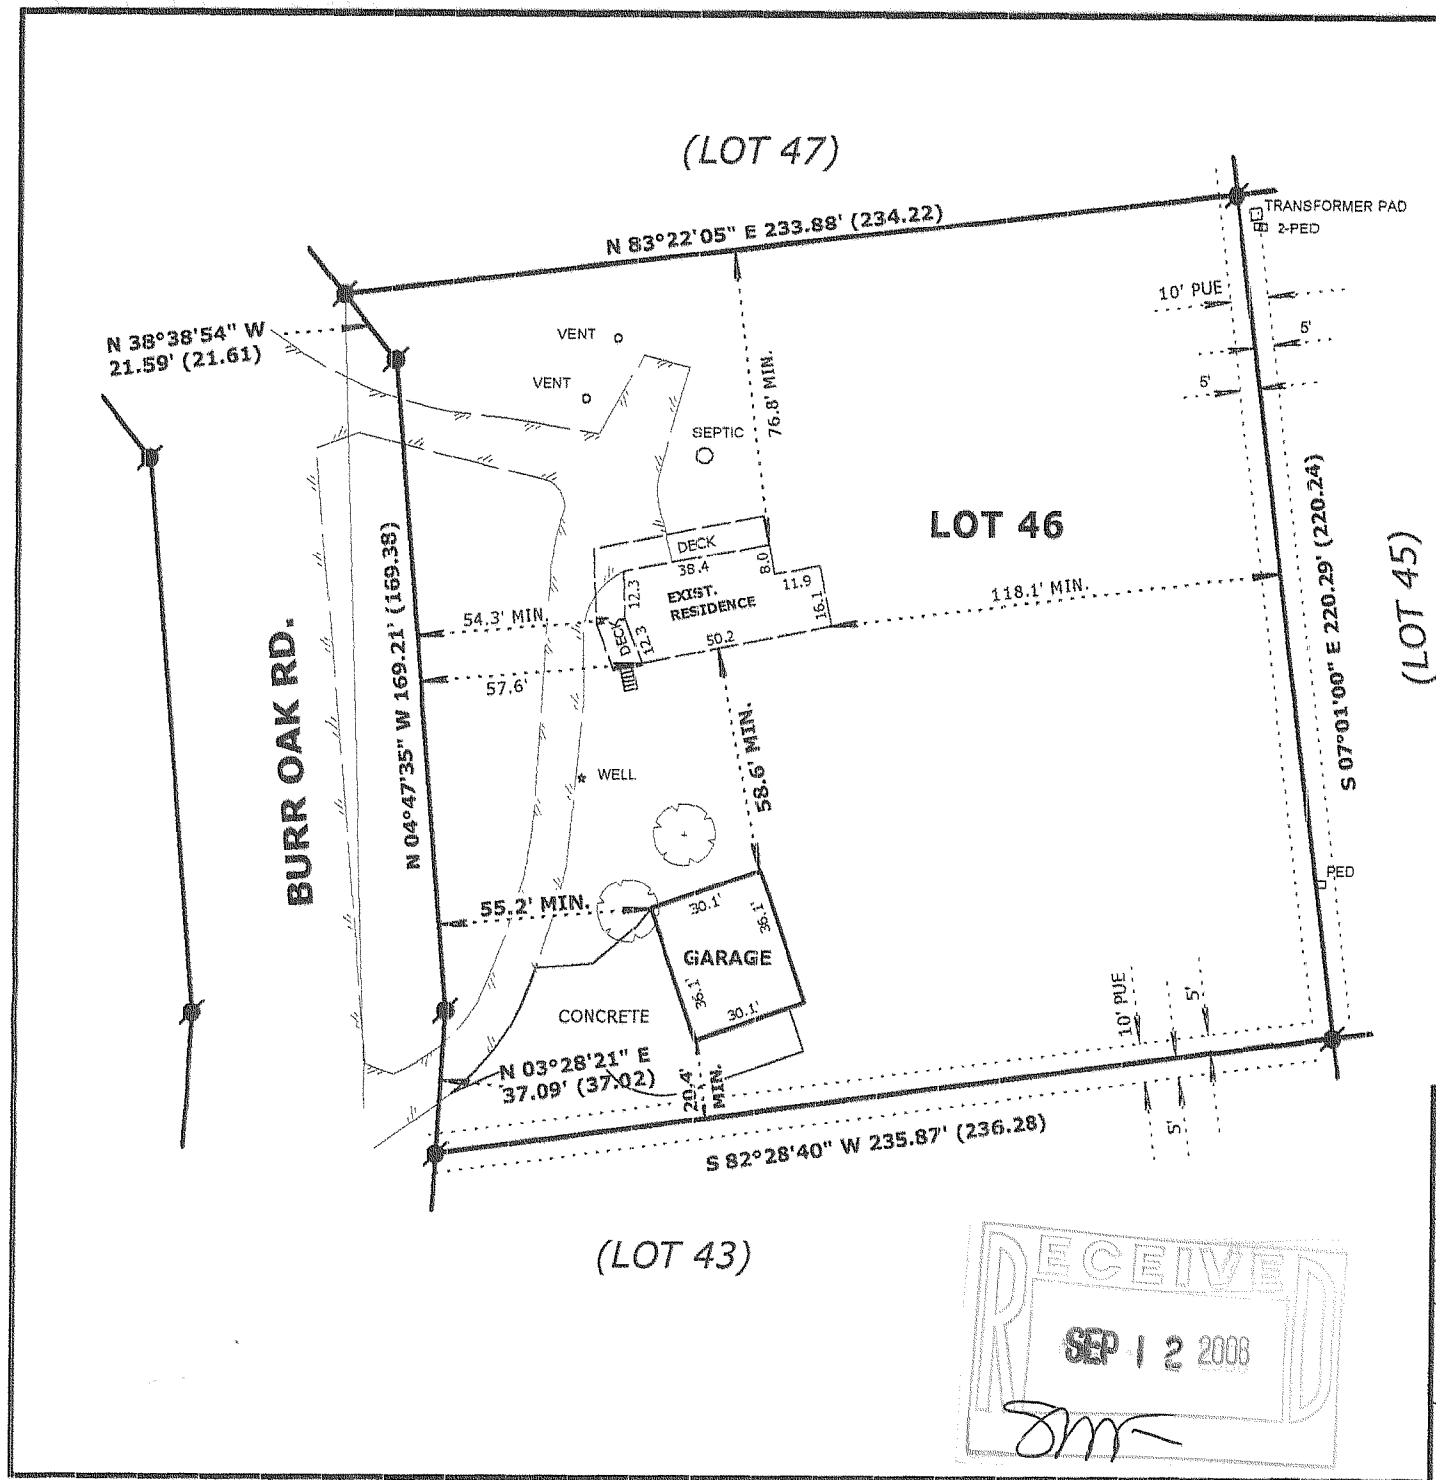

LEGAL DESCRIPTION

LOT 46, SCATTERED OAKS SUBDIVISION
IN THE TOWN OF WHITEWATER, WALWORTH CO., WI.


SITE ADDRESS: N7488 BURR OAK RD., WHITEWATER, WI.

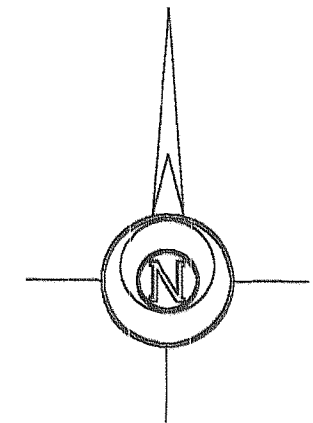


BASIS OF BEARINGS:
THE E'LY LINE OF LOT 46
BEING S 7°01'00" E

NOTES:

- () - INDICATES RECORD DATA
- ⬮ - INDICATES FOUND IRON ROD

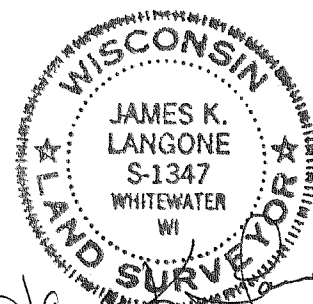

THIS PLOT PLAN IS BASED ON A PLAT OF SURVEY OF THE ABOVE
DESCRIBED PARCEL, DONE BY ME AND DATED 01/30/03.

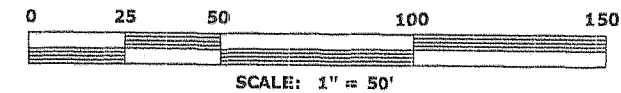

JAMES K. LANGONE LAND SURVEYS & CIVIL ENGINEERING			
5 Coburn Lane		Whitewater, WI. 53190	(262) 473-4119
SCALE	1" = 50'		DRAWN BY JKL
DATE	11/06/07		REVISED REV. 9/04/08
AS-BUILT GARAGE			
CLIENT HORLACHER			DRAWING NUMBER 02-130 REV.

DSO - 46

415-1173