


PLAT OF SURVEY

LEGAL DESCRIPTION:
LOT 10, BLK. 1, CHAPEL HILLS SUB.

REQUESTED BY: EARNEST J. ROY

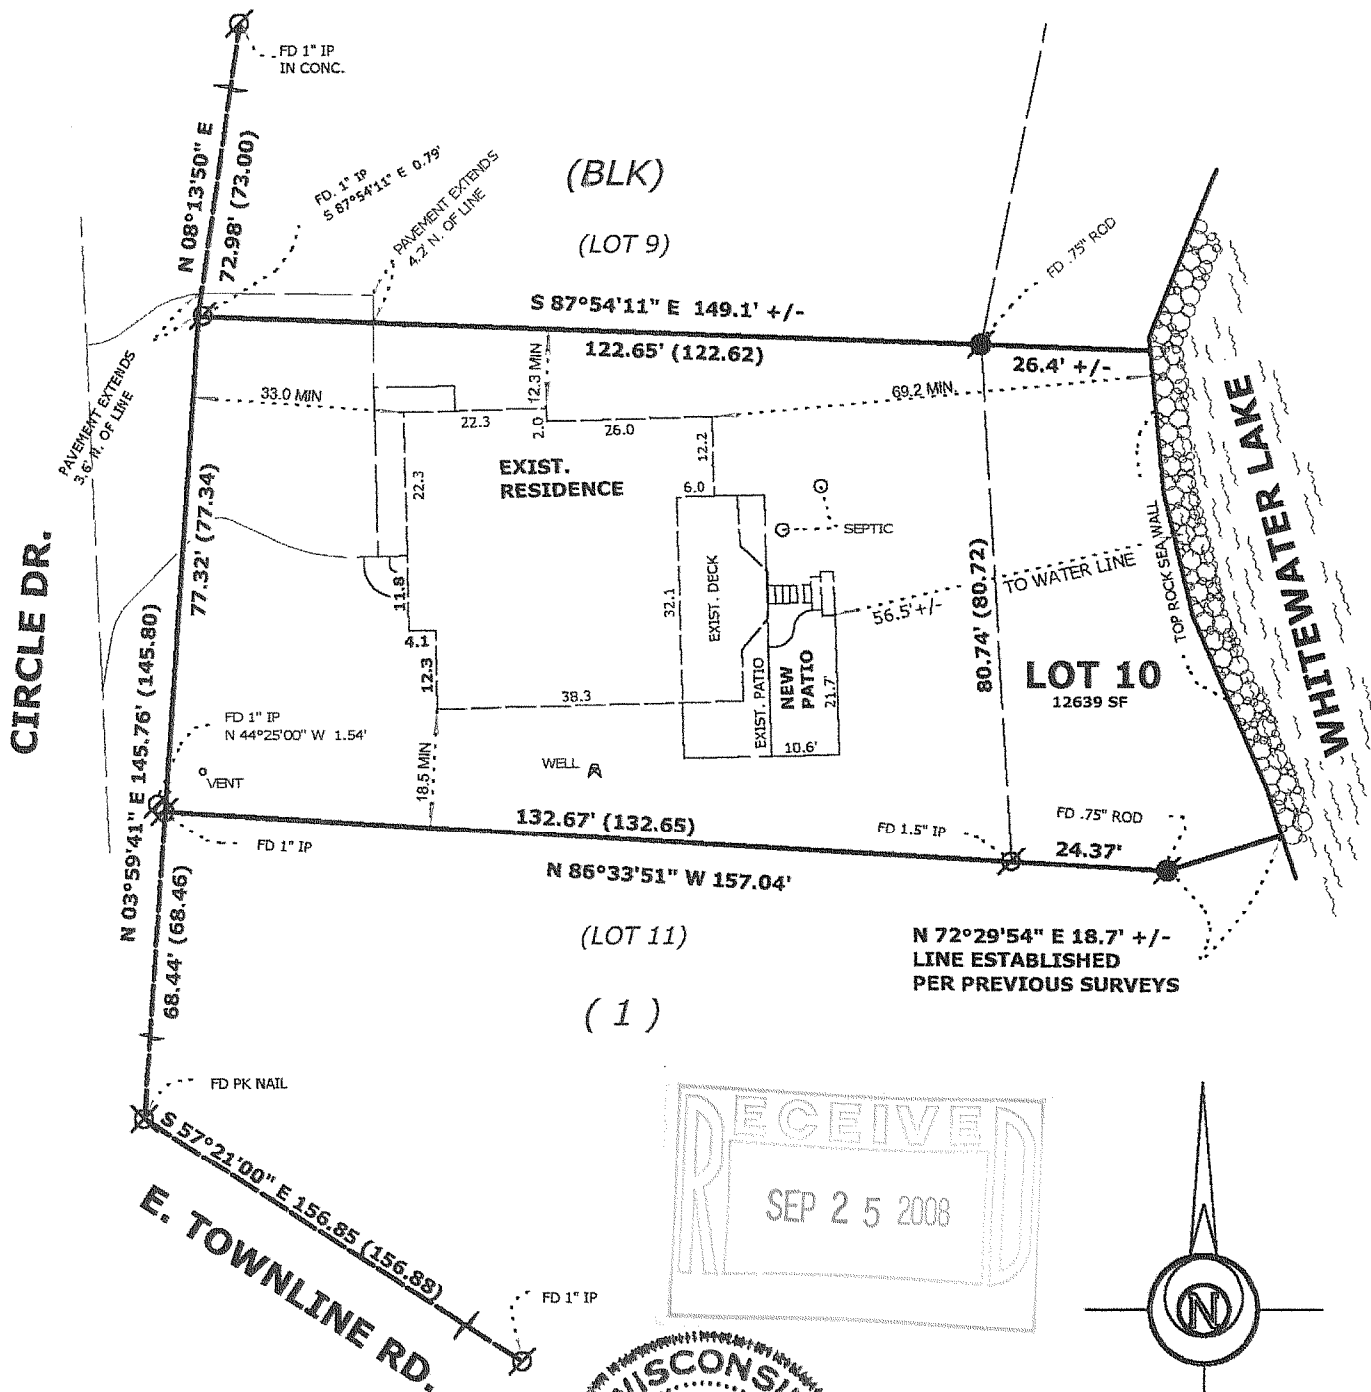


SURVEYOR'S CERTIFICATE:

I, JAMES K. LANGONE, REGISTERED LAND SURVEYOR, CERTIFY THAT I HAVE SURVEYED THE PROPERTY DESCRIBED HEREON AND THAT THIS PLAT IS A TRUE AND CORRECT REPRESENTATION OF THE BOUNDARIES THEREOF.

DATE: 7/29/08

JAMES K. LANGONE
REGISTERED LAND SURVEYOR S-1347

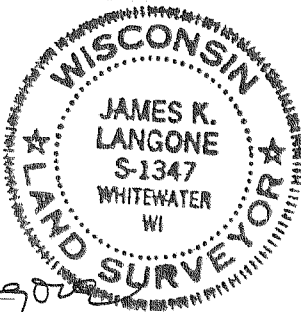


BASIS OF BEARINGS:
THE N'LY LINE OF TOWNLINE RD.
BEING S 57°21'00" E

NOTES:

- (XX) INDICATES RECORD DATA
- INDICATES FOUND IRON PIPE
- INDICATES FOUND IRON ROD
- ⊗ INDICATES FOUND PK NAIL

AS-BUILT: PATIO 7/29/08

AS-BUILT 2/05/07

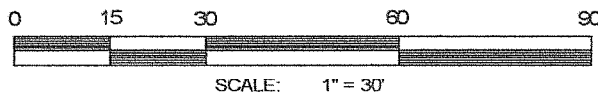

RE-CERTIFICATION OF SURVEY DATED 04/29/03.
REVISED TO PROVIDE ADDITIONAL DATA FOR
USE AS PLOT PLAN. 9/28/06

JN: 03-105
04/29/03

JAMES K. LANGONE
LAND SURVEYS & CIVIL ENGINEERING

5 Coburn Ln. Whitewater, WI. 53190 (262) 473-4119

DCH-10

415-1175