

PLAT OF SURVEY

LOT 22 OF BLOCK 4 OF MORaine HEIGHTS SUBDIVISION

LOCATED IN TOWN 4 NORTH, RANGE 15 EAST,
WALWORTH COUNTY, WISCONSIN


NOTE: PREVIOUSLY SURVEYED SHOREYARD
SETBACK FOR LOT 21 IS 38' TO THE HOUSE
AND 30' TO THE DECK AS SHOWN ON SURVEY
BY ABELL SURVEYING AND MAPPING DATED
MAY 16, 1996.

EXISTING RESIDENCE
FLOOR ELEV.=903.0'



NOTE: COPIES OF THIS MAP TO WHICH THE FOLLOWING CERTIFICATE
WILL APPLY SHOW THE SURVEYOR'S ORIGINAL SEAL AND SIGNATURE
IN RED INK. COPIES BY ANY OTHER MEANS MAY HAVE ALTERATIONS
WHICH DO NOT REPRESENT THE SURVEYOR'S WORK PRODUCT.

I HEREBY CERTIFY THAT THE ABOVE DESCRIBED PROPERTY HAS BEEN
SURVEYED UNDER MY DIRECTION AND THAT THE ABOVE MAP IS A TRUE
REPRESENTATION THEREOF AND SHOWS THE SIZE AND LOCATION OF
THE PROPERTY AND ITS EXTERIOR BOUNDARIES. THIS SURVEY IS
MADE FOR THE USE OF THE PRESENT OWNERS OF THE PROPERTY, AND
ALSO THOSE WHO PURCHASE, MORTGAGE, OR GUARANTEE THE TITLE
THERE TO WITHIN ONE YEAR FROM THE DATE HEREOF.



DATED: SEPTEMBER 18, 2008

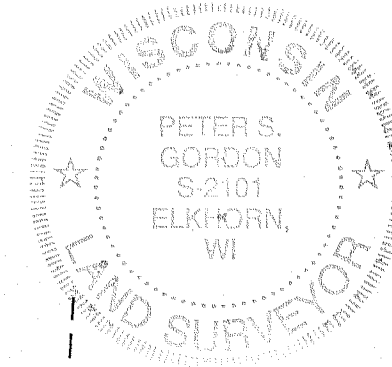

Peter S. Gordon
PETER S. GORDON R.L.S. 2101

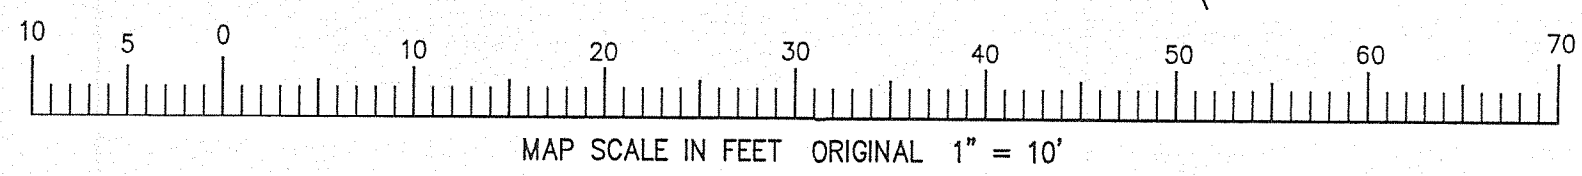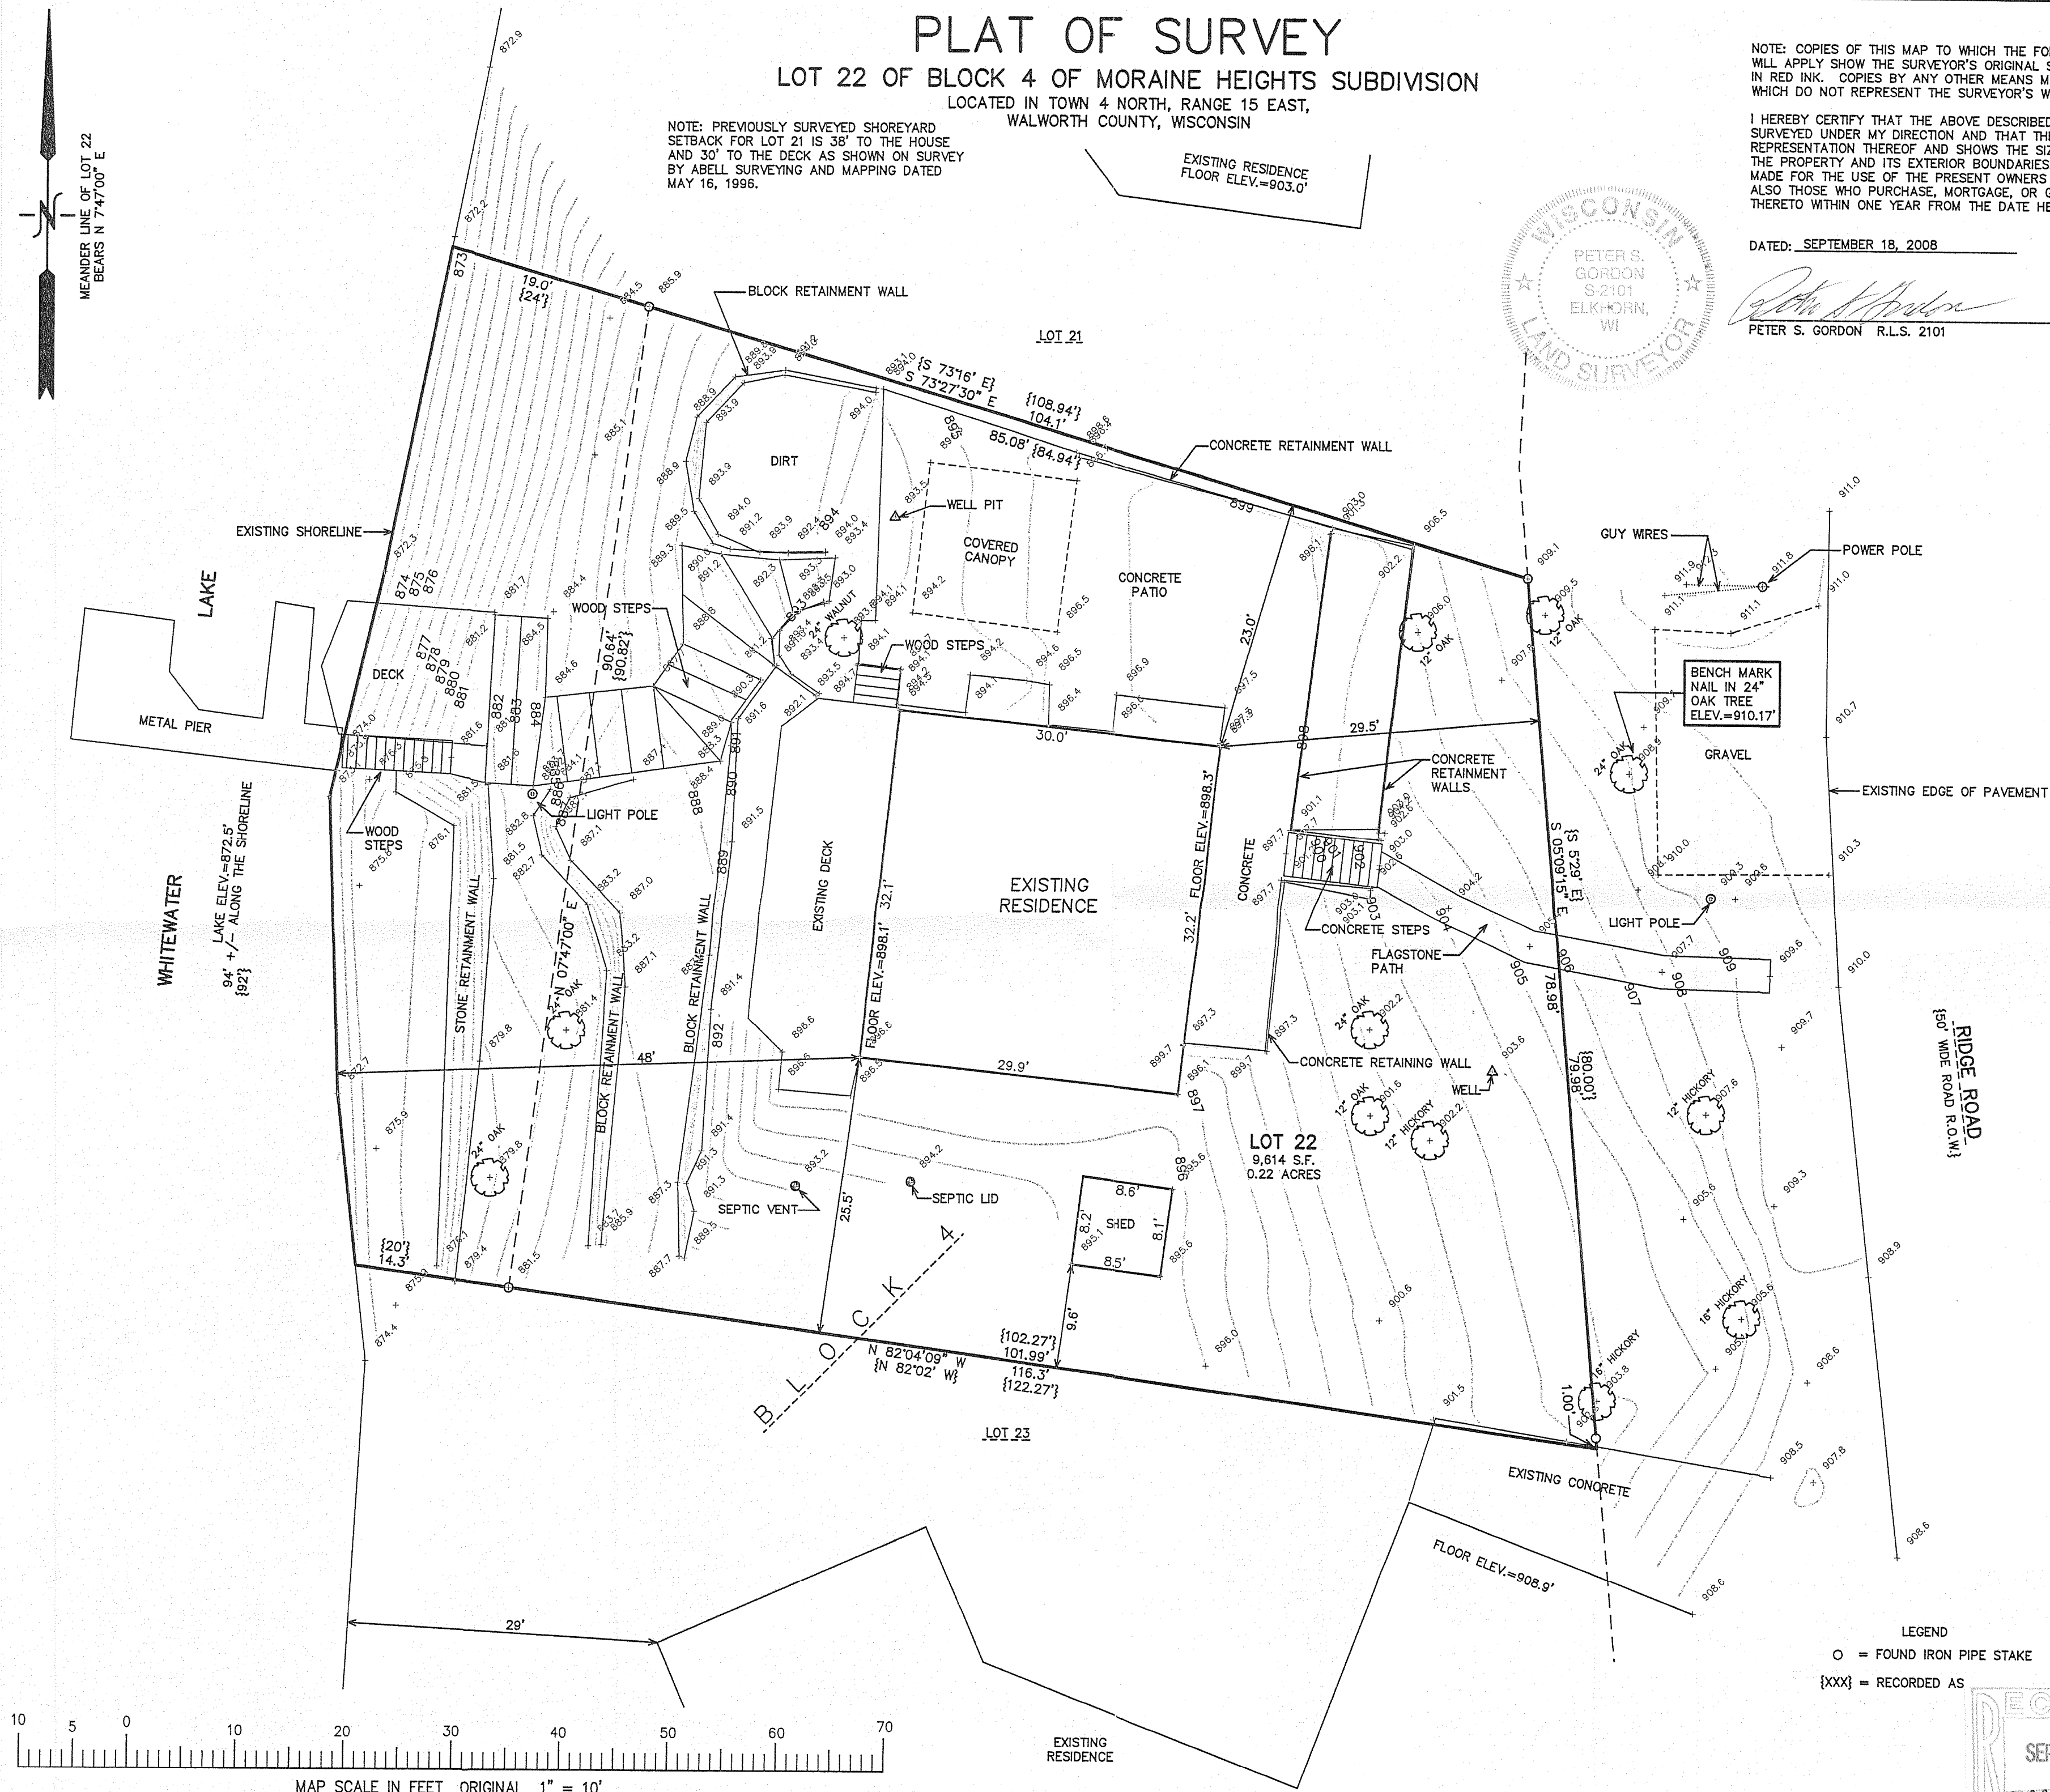

LEGEND
O = FOUND IRON PIPE STAKE
{XXX} = RECORDED AS

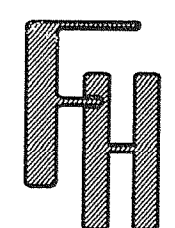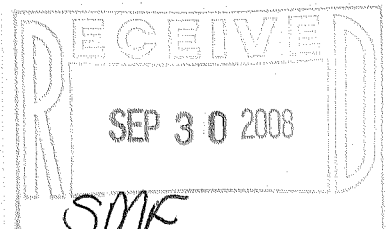

WORK ORDERED BY -
ROBERT LEWANDOWSKI
1679 N. PEBBLE BEACH WAY
VERNON HILLS, IL 60061

FARRIS, HANSEN & ASSOCIATES, INC.
ENGINEERING - ARCHITECTURE - SURVEYING
7 RIDGWAY COURT P.O. BOX 437
ELKHORN, WISCONSIN 53121
OFFICE: (262) 723-2098 FAX: (262) 723-5886

REVISIONS

PROJECT NO.
7750
DATE:
9/18/2008
SHEET NO.
1 OF 1

DMH-104

415-1196