

FARRIS, HANSEN & ASSOCIATES, INC.



ENGINEERING — ARCHITECTURE — SURVEYING
7 RIDGWAY COURT — P.O. BOX 437 — ELKHORN, WISCONSIN 53121
PHONE: (262) 723-2098 FAX: (262) 723-5886

LOT 1 OF C.S.M. 3803

LOCATED IN THE NE 1/4 AND SE 1/4 OF
THE NW 1/4 OF SECTION 32, TOWN 4 NORTH,
RANGE 15 EAST, WALWORTH COUNTY, WISCONSIN

— WORK ORDERED BY —
EUGENE & DONNA FRODL
N7553 STATE ROAD "89"
WHITEWATER, WI 53190

GRID NORTH
WI. COORD. SYSTEM
SOUTH ZONE
ASSIGNED N. LINE NW 1/4
N 88° 06' 43" E

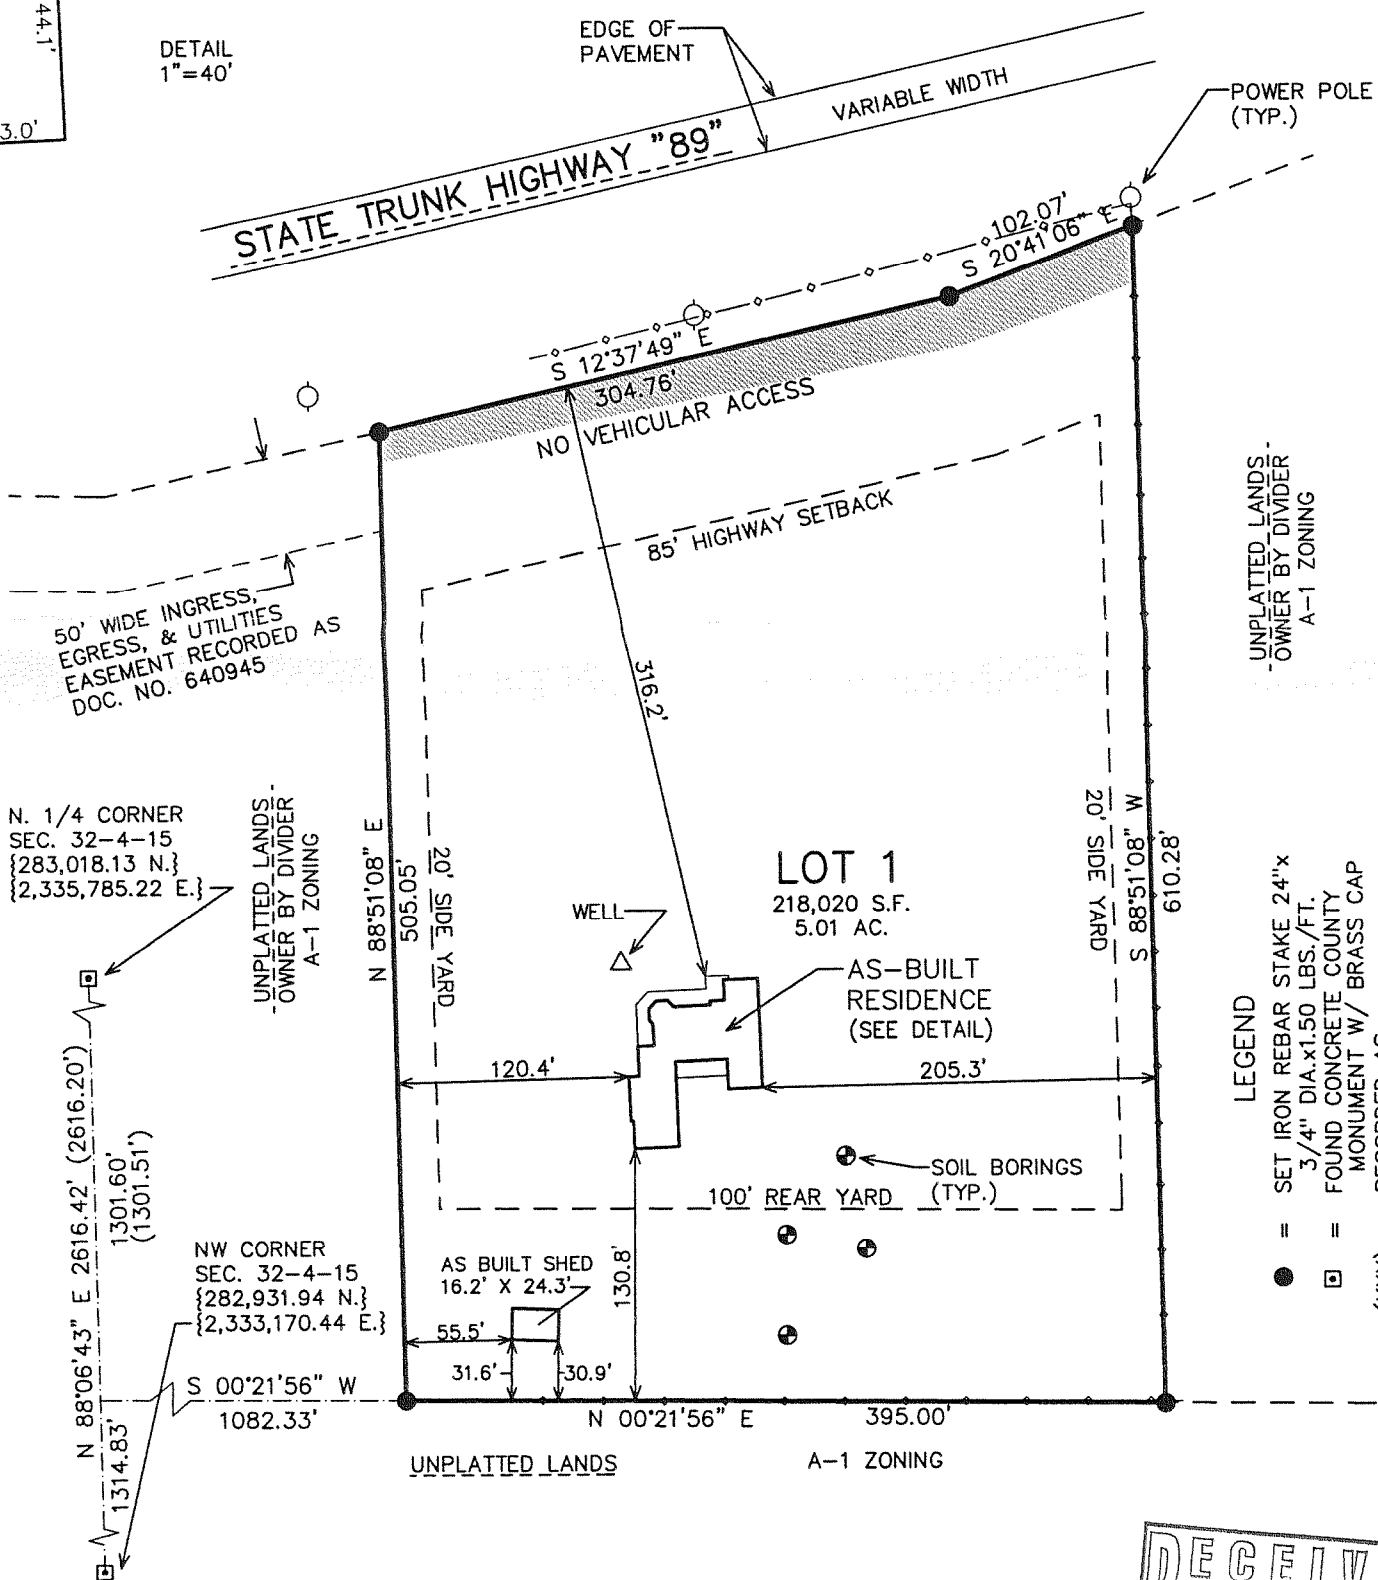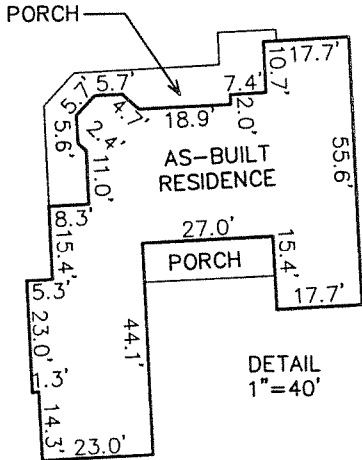

UNPLATTED LANDS -
OWNER BY DIVIDER
A-1 ZONING

LEGEND
● = SET IRON REBAR STAKE 24"x
3/4" DIA. x 1.50 LBS./FT.
□ = FOUND CONCRETE COUNTY
MONUMENT W/ BRASS CAP
(XXX) = RECORDED AS




NOTE: COPIES OF THIS MAP TO WHICH THE FOLLOWING CERTIFICATE
WILL APPLY SHOW THE SURVEYOR'S ORIGINAL SEAL AND SIGNATURE
IN RED INK. COPIES BY ANY OTHER MEANS MAY HAVE ALTERATIONS
WHICH DO NOT REPRESENT THE SURVEYOR'S WORK PRODUCT.

I HEREBY CERTIFY THAT THE ABOVE DESCRIBED PROPERTY HAS BEEN
SURVEYED UNDER MY DIRECTION AND THAT THE ABOVE MAP IS A TRUE
REPRESENTATION THEREOF AND SHOWS THE SIZE AND LOCATION OF
THE PROPERTY AND ITS EXTERIOR BOUNDARIES. THIS SURVEY IS
MADE FOR THE USE OF THE PRESENT OWNERS OF THE PROPERTY, AND
ALSO THOSE WHO PURCHASE, MORTGAGE, OR GUARANTEE THE TITLE
THERETO WITHIN ONE YEAR FROM THE DATE HEREOF.

DATED: APRIL 13, 2005

REVISED: JULY 7, 2005 TO SHOW SIZE & LOCATION OF AS-BUILT RESIDENCE
REVISED 12-08-2008 TO SHOW SIZE & LOCATION OF AS BUILT SHED

PETER S. GORDON R.L.S. 2101

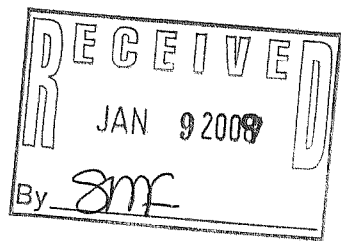

PROJECT: 4270.04
DATE: 04/13/2005
SHEET 1 OF 1