


Tax Parcel
DW 3400004

Tax Parcel
DW 3400001

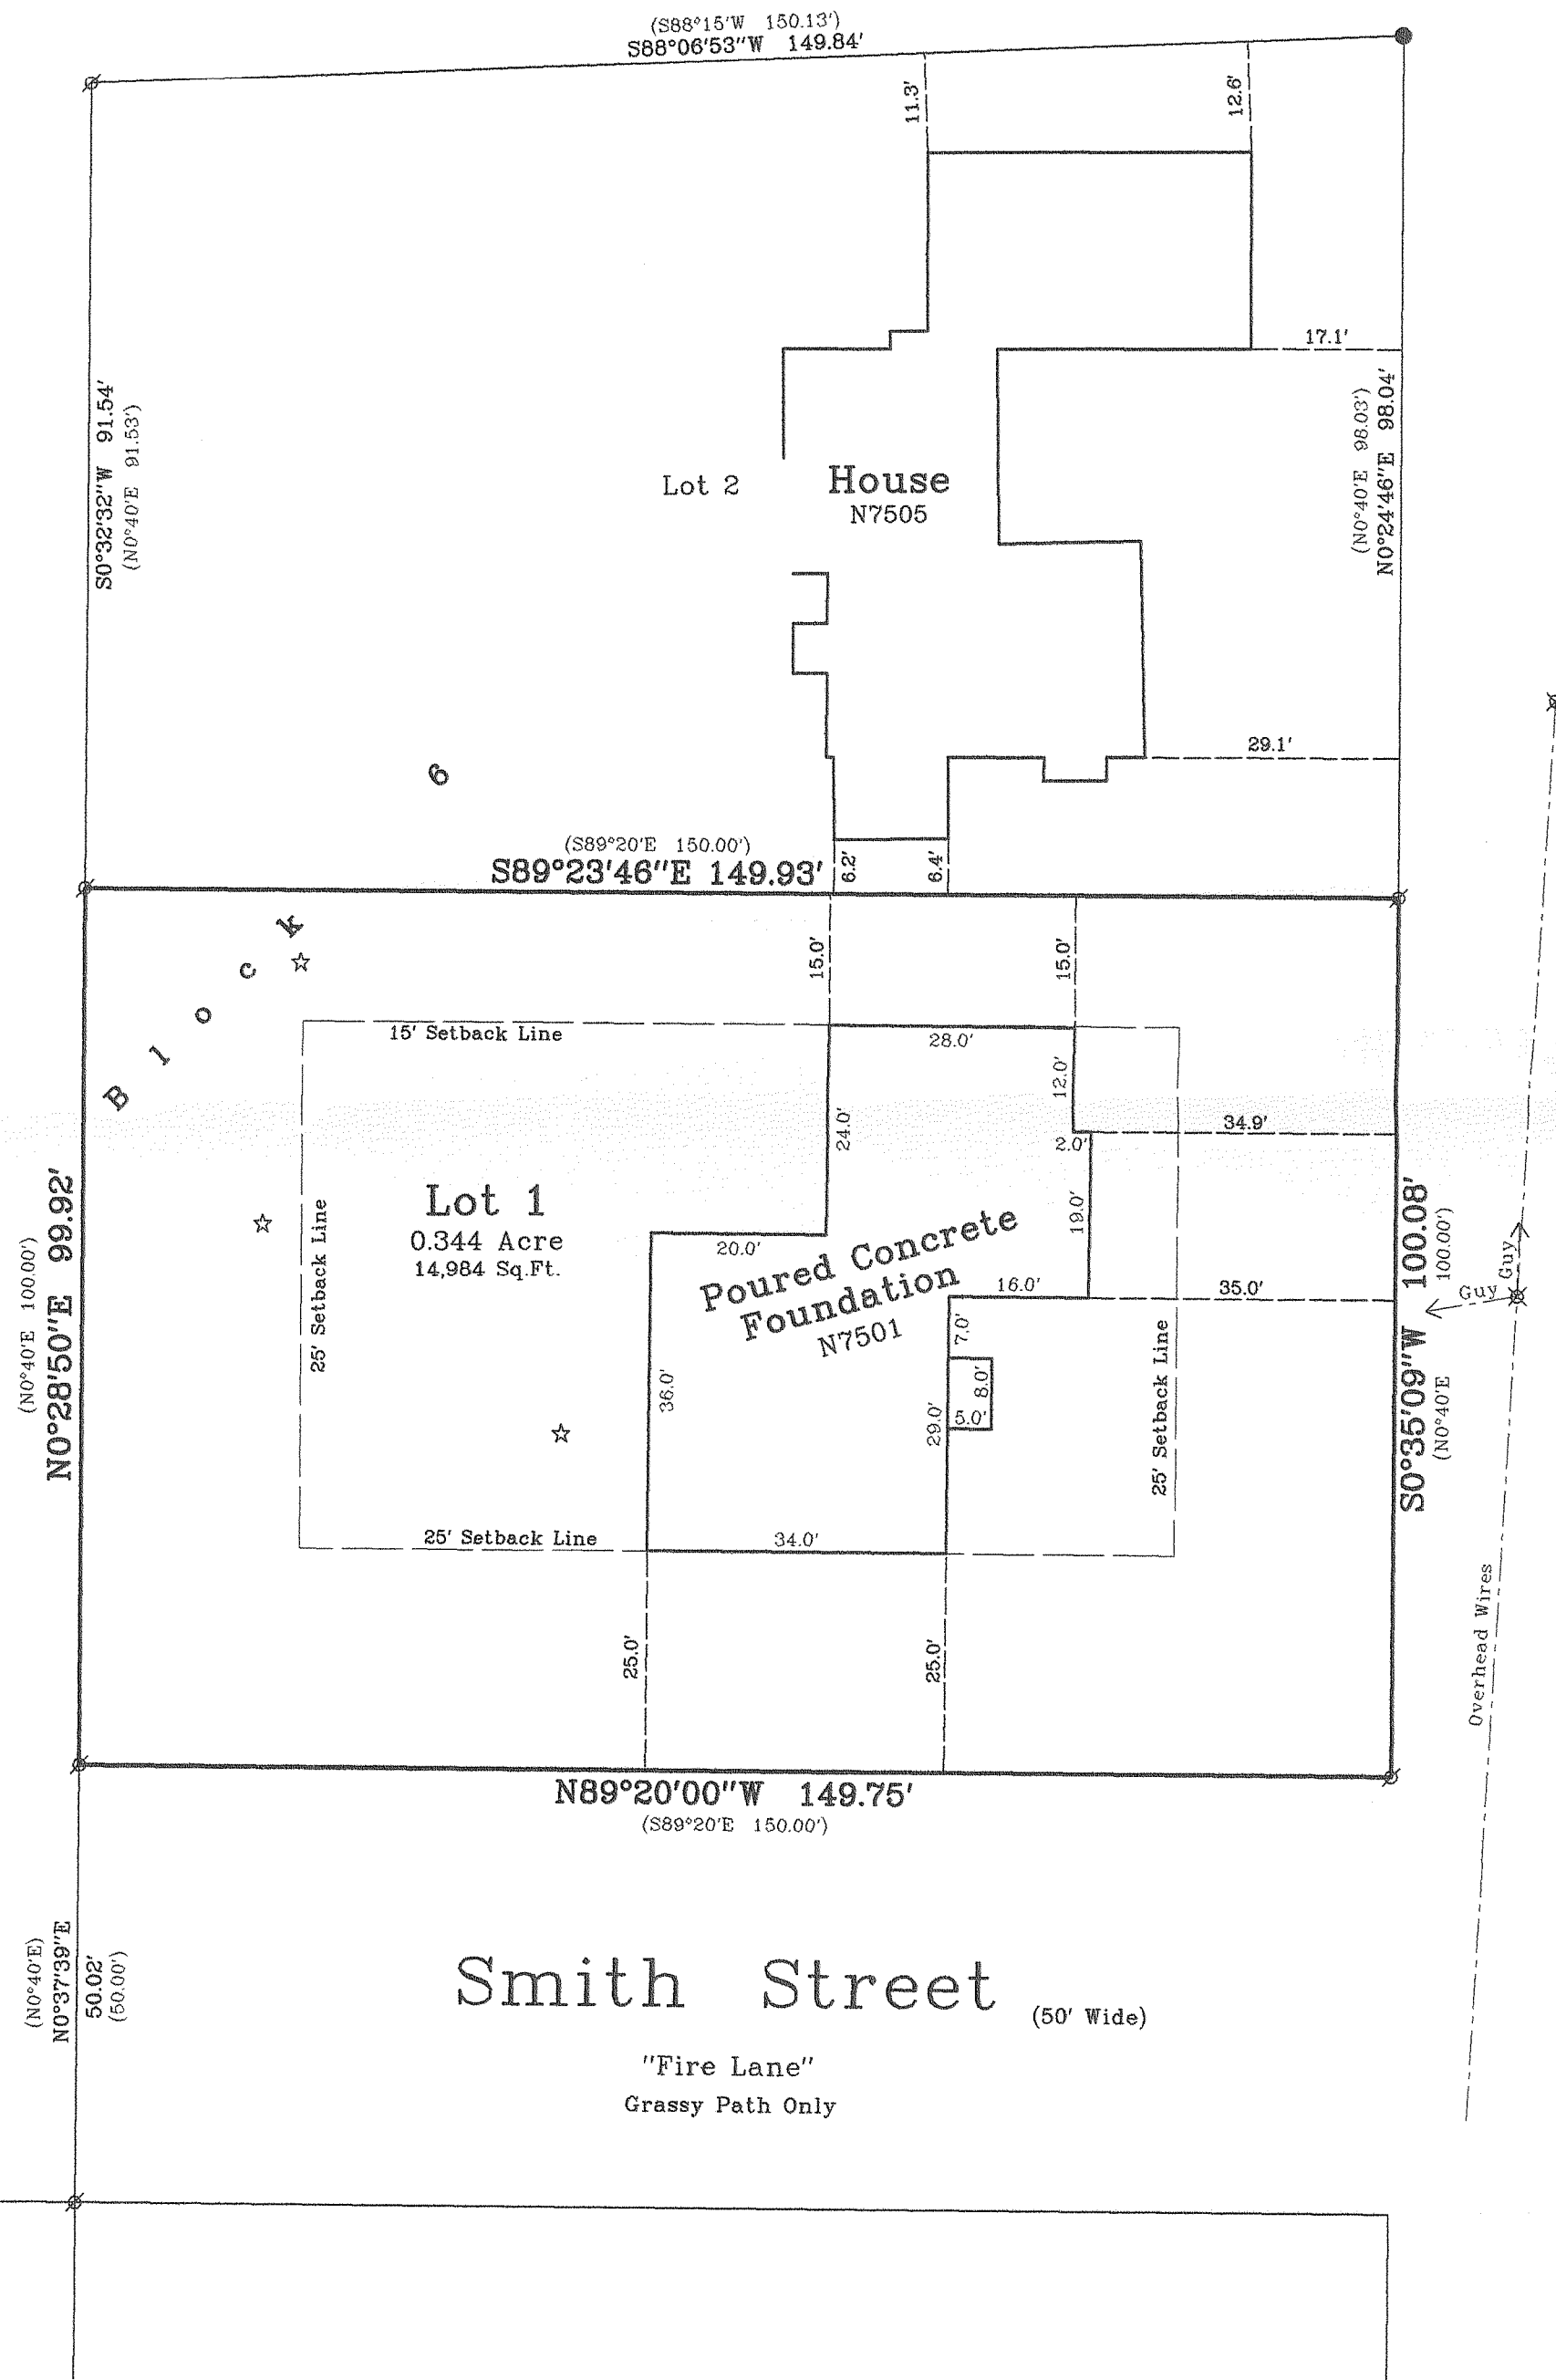




Plat of Survey

of

Lot 1 of Block 6 of Grand View Subdivision,

located in the Southeast 1/4 of Section 34, Town 4 North, Range 15 East, Town of Whitewater, Walworth County, Wisconsin.

Surveyed for: **James Bronson**
N7470 Kettle Moraine Drive
Whitewater, Wisconsin. 53190

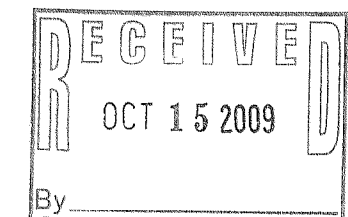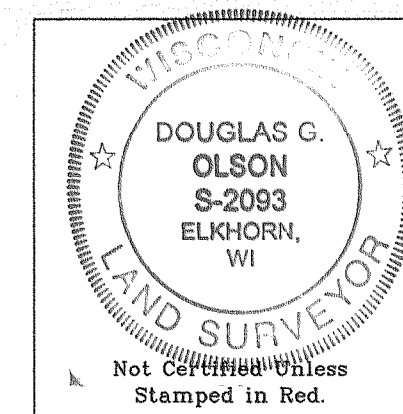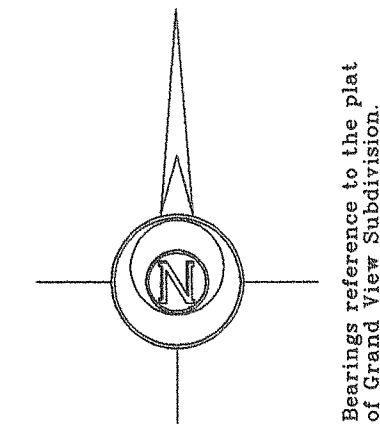

- Notes: 1) This survey plat is not certified unless signed and sealed in red ink.
- 2) This survey is subject to Wisconsin lien laws. This Plat of Survey is the notice of intent to file lien. Lien waiver required.


Copyright 2005 by Jensen & Olson Land Surveying, LLC.

All rights reserved. No part of this survey plat may be reproduced or transmitted in any form by any means - graphic, electronic, or mechanical, including photocopying, tracing, or information storage and retrieval systems - without permission in writing from Douglas G. Olson, Jensen & Olson Land Surveying, LLC.

I, Douglas G. Olson, Wisconsin Registered Land Surveyor, do hereby certify that this survey was performed by me or under my direction in full compliance with the owner's/agent's instructions and Chapter A-E 7 of the Wisconsin Administrative Code "Minimum Standards for Property Surveys", and that this map is an accurate representation thereof to the best of my knowledge and belief.

Douglas G. Olson
Wisconsin Registered Land Surveyor - 2093

Survey Date: August 17, 2005.
Revisions: No. 1 - Proposed House
No. 2 - Station
No. 3 - Foundation

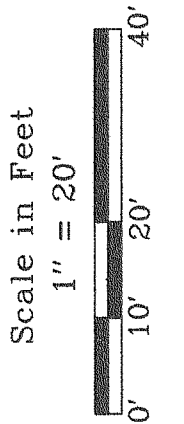

Jensen & Olson Land Surveying, LLC
45 South Wisconsin Street P.O. Box 322
Elkhorn, Wisconsin 53121
Telephone (262) 723-3434
Facsimile (262) 723-8044

Legend
☒ Found Iron Pipe ☐ Set Wood Stake
☒ Found Iron Rod ☐ Stake
☒ Recorded Information
☒ Utility Pole
☒ Soil Boring
☒ Asphalt Surface

Sheet 1 of 1 Sheets
Job Reference Number
2009.001
2009.001

DGD-67

415-1197